




SECTION A - A
(SCALE - 1:25)
RCC DETAIL OF CONTAINER FOUNDATION

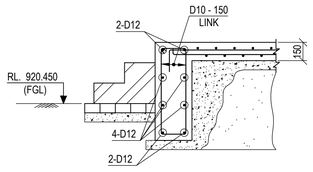

SECTION B - B
(SCALE - 1:25)
RCC DETAIL OF BEAM

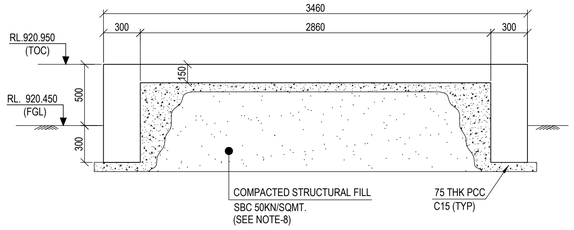


SECTION A - A
(SCALE - 1:25)

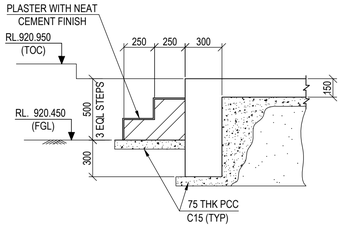


SECTION B - B
(SCALE - 1:25)



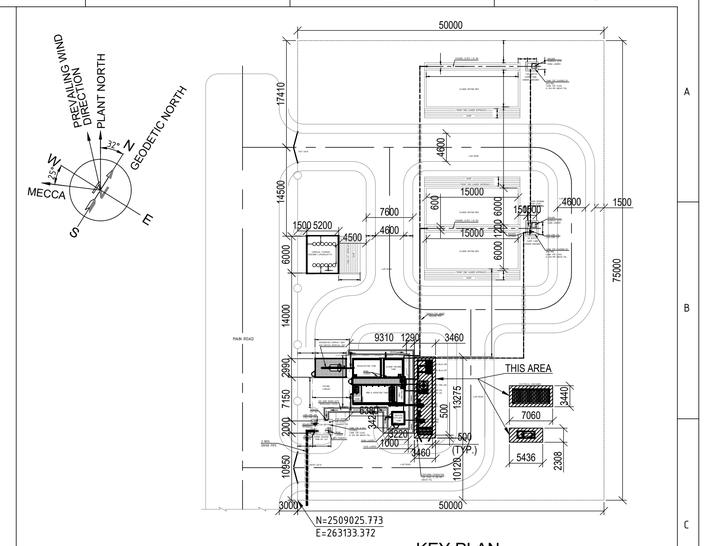


KEY PLAN
(SCALE - 1:500)




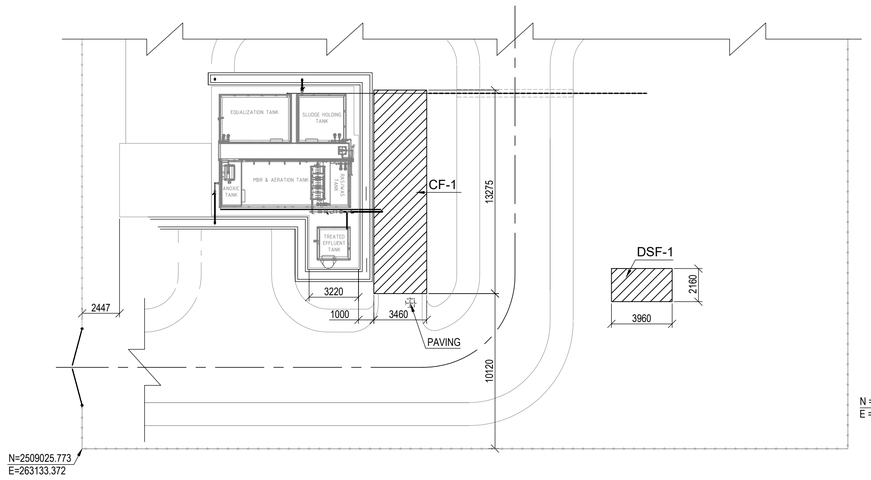


FOUNDATION LAYOUT PLAN OF CONTAINER & DG SET FOUNDATION
(SCALE - 1:200)

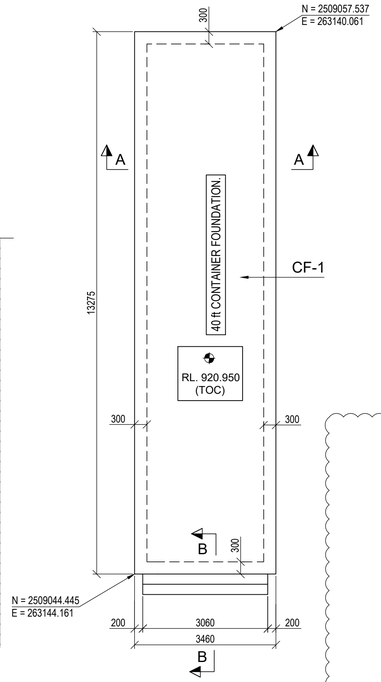


PLAN OF CONTAINER FOUNDATION MKD CF-1
(SCALE - 1:75)

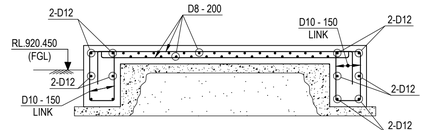


SECTION D - D
(SCALE - 1:25)
RCC DETAIL OF DG SET FOUNDATION MKD DSF1

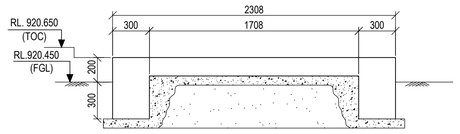

SECTION D - D
(SCALE - 1:25)

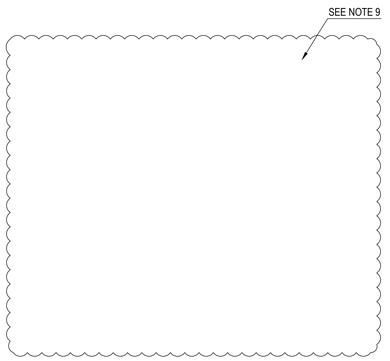

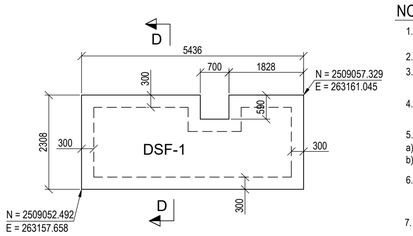

PLAN OF DG SET FOUNDATION MKD DSF-1
(SCALE - 1:75)

LEGENDS :

TOC - TOP OF CONCRETE
RL- REDUCED LEVEL
TYP - TYPICAL
PCC - PLAIN CEMENT CONCRETE
MKD - MARKED
C - COLUMN
TOS - TOP OF SLAB
BOF - BOTTOM OF FOUNDATION
CL - CENTRE LINE
RCC - REINFORCED CEMENT CONCRETE
DRG. - DRAWING
THK - THICK
FGL - FINISHED GROUND LEVEL
BOF - BOTTOM OF FOUNDATION
FDN - FOUNDATION
SBC - SAFE BEARING CAPACITY
SQMT. - SQUARE METRE
EQL - EQUAL
GA - GENERAL ARRANGEMENT

NOTES :-

1. ALL DIMENSIONS ARE IN MILLIMETRES AND LEVELS AND CO-ORDINATES ARE IN METRES UNLESS OTHERWISE STATED.
2. GRADE OF CONCRETE SHALL BE 35MPa FOR RCC AND 15 MPa FOR BLINDING CONCRETE.
3. GRADE OF REINFORCEMENT SHALL BE DEFORMED BAR (GRADE 60) - ASTM M615/fy=420Mpa.
4. FOR MINIMUM LAP LENGTH OF REINFORCEMENT REFER DRG. NO. MD-216-1000-EG-CV-DED-1001.
5. CLEAR COVER TO REINFORCEMENT SHALL BE AS
   a). WALL = 50mm.
   b). SLAB = 25mm.
6. IF ANY PART OF FOUNDATION COMES ON BACKFILL ZONE OF ADJACENT FOUNDATION OR ANY LOOSE SOIL ARE ENCOUNTERED BELOW FOUNDATION LEVEL THE SAME SHALL BE REMOVED AND FILLED WITH PCC.
7. THE CONTENT OF THIS DRAWING SHALL CONFORM TO THE PROVISIONS OF CIVIL, STRUCTURAL & ARCHITECTURAL DESIGN CRITERIA DOCUMENT NO. MD-216-1000-EG-ST-CRT-1001 & GENERAL NOTES DRG.NO. MD-216-1000-EG-CV-DED-1001.
8. STRUCTURAL FILL SHALL CONFORM TO PROVISIONS OF DOCUMENT MD-216-1000-EG-CV-MST-1698.
9. FOUNDATION DETAIL OF ELECTRICAL CONTAINER TO BE FURNISHED IN SEPERATE DRAWING.

DOCUMENT NUMBER	REFERENCE DOCUMENTS	REV	DATE	REVISION DESCRIPTION	DRN	CHK	ENG	APP	EMP
		D01	16/02/2023	AS-BUILT	PML	SJM	BJB	AG	
		C02	28/06/2021	ISSUED FOR CONSTRUCTION & REVISED AS MKD. C02	PML	SJM	BJB	AG	
		C01	08/12/2020	ISSUED FOR CONSTRUCTION & REVISED AS MKD. C01	DSR	SJM	BJB	AG	
		A01	09/09/2020	ISSUED FOR REFERENCE	DSR	SJM	BJB	AG	

RESERVED FOR VENDOR LOGO AND DRAWING NUMBER

LARSEN & TOUBRO

This drawing is the property of LARSEN & TOUBRO and must not be passed on to any person or body not authorized by us to receive it nor be copied or otherwise made use either in full or in part by such person or body without our prior permission in writing.

Outotec

The content of these documents are the sole property of Outotec Oyj. Any rights not expressly granted herein are reserved. Reproduction, transfer or distribution of part or all of the contents in any form without prior written permission of Outotec is prohibited.

MA'ADEN معادن
Saudi Arabian Mining Company شركة التعدين العربية السعودية

This document and the information contained herein is Ma'aden proprietary know-how. This document or any part thereof should not be reproduced, stored in a retrieval system or transmitted by any means, electronic or otherwise, or divulged without prior written permission of Ma'aden.

LARSEN & TOUBRO DRAWING NUMBER	019045_045_C_G_24282_001	REVISION 3
OUTOTEC DRAWING NUMBER	900707__GAU01__AG90__MTL01__50022	DOCUMENT ID OU100692385 / REVISION 3

DRAWN	DSR	03/09/2020
CHECKED	SJM	07/09/2020
ENGINEER	BJB	03/09/2020
APPROVED	AG	09/09/2020
EMPLOYER		
SCALE	1:100,50,20	A1

MANSOURAH - MASSARAH GOLD PROJECT
GENERAL ARRANGEMENT
SEWAGE TREATMENT PLANT
CONTAINER & DG SET FDN GA & DETAIL

DRAWING NUMBER MD-216-49EE-EG-CV-GAD-1586 REV D01