

DRAWING NUMBER: MD-216-49EE-EG-CV-GAD-1587 | REV: D01

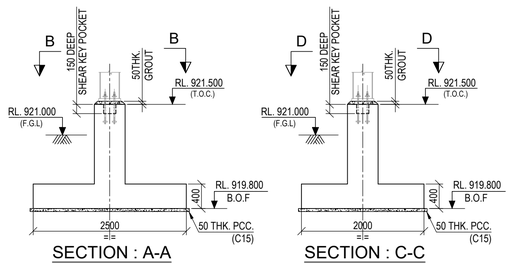


SECTION : A-A
SCALE 1:50


SECTION : C-C
SCALE 1:50

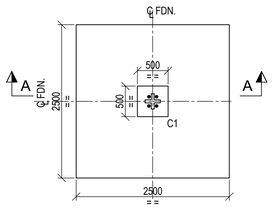


DETAIL OF FOUNDATION
MKD. F1
SCALE 1:50

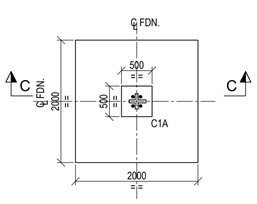


DETAIL OF FOUNDATION
MKD. F1A
SCALE 1:50

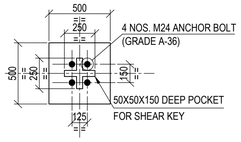


VIEW : B-B
(FOR COL. MKD. C1)
SCALE 1:25

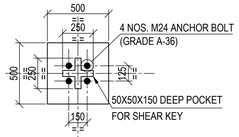


VIEW : D-D
(FOR COL. MKD. C1A)
SCALE 1:25
C03

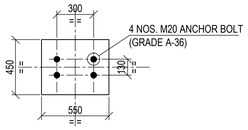


VIEW : F-F
SCALE 1:25

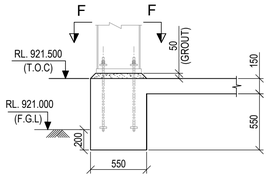


SECTION E-E
SECTION E'-E' (OPPOSITE HAND)
SCALE 1:30

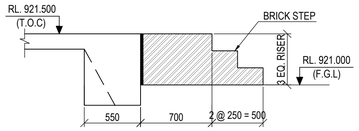


SECTION J-J
SECTION J'-J' (OPPOSITE HAND)
SCALE 1:30

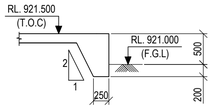


SECTION G-G
SECTION G'-G' (OPPOSITE HAND)
SCALE 1:50

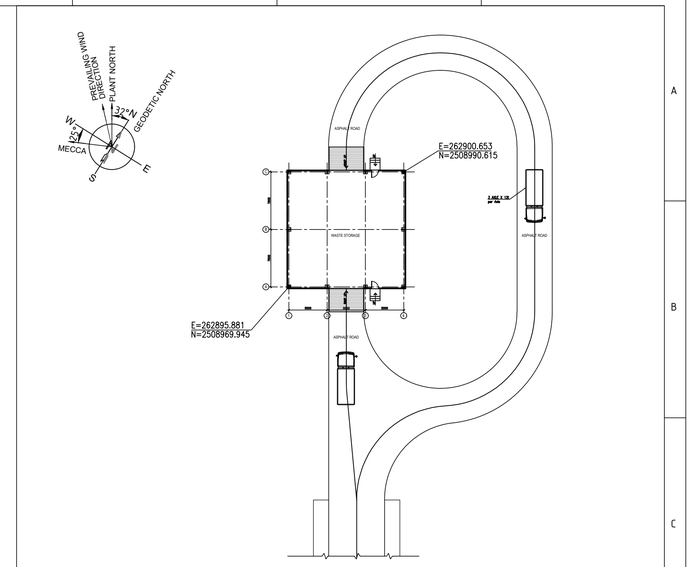


KEY PLAN
(SCALE - 1:400)

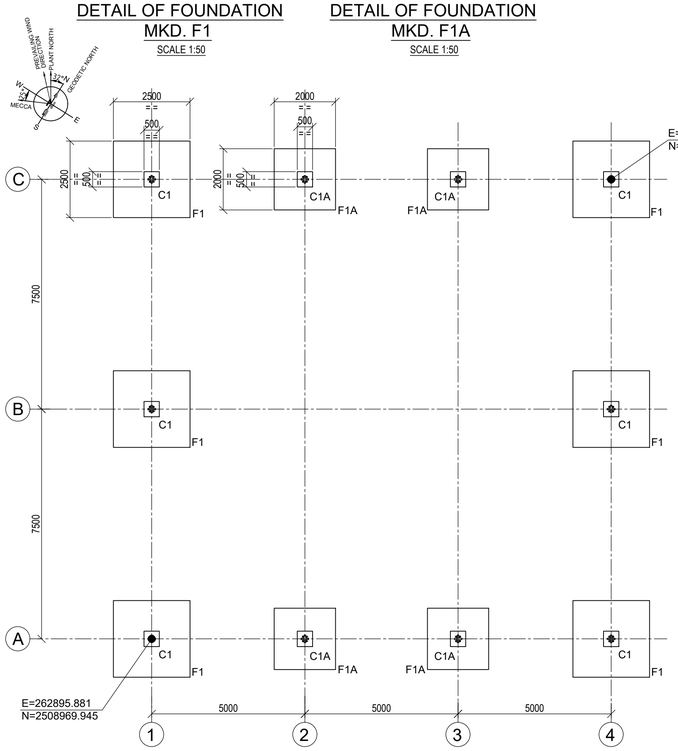


LAYOUT OF FOUNDATION
(SCALE - 1:100)

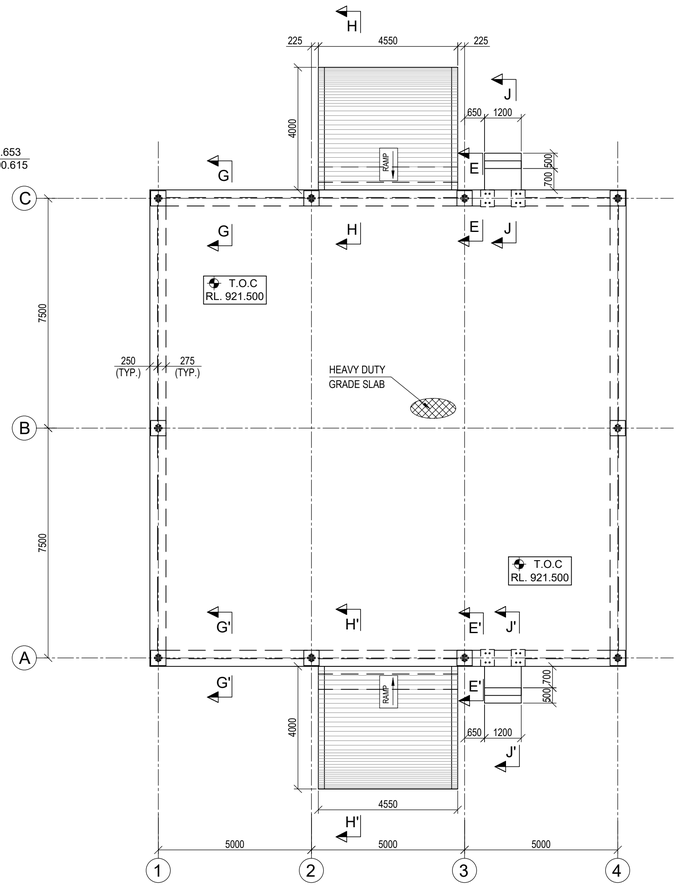

LAYOUT OF GRADE SLAB
(SCALE - 1:100)

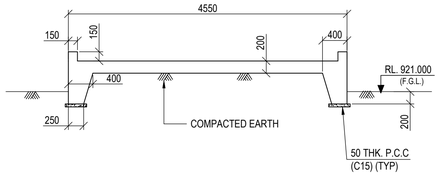

SECTION H1-H1
SCALE 150

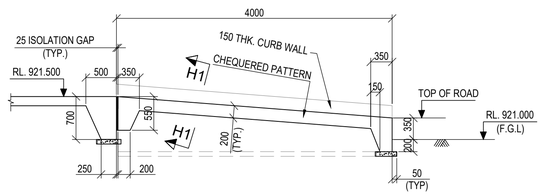

SECTION H-H
SECTION H'-H' (OPPOSITE HAND)
SCALE 1:50

LEGENDS :

TOC - TOP OF CONCRETE
RL- REDUCED LEVEL
TYP - TYPICAL
PCC - PLAIN CEMENT CONCRETE
MKD - MARKED
COL. - COLUMN
FDN. - FOUNDATION
BOF - BOTTOM OF FOUNDATION
℄ - CENTRE LINE
DRG. - DRAWING
THK - THICK
F.G.L - FINISHED GROUND LEVEL

NOTES :-

1. ALL DIMENSIONS ARE IN MILLIMETRES AND LEVELS AND CO-ORDINATES ARE IN METRES UNLESS OTHERWISE STATED.
2. GRADE OF CONCRETE SHALL BE 35MPa FOR RCC AND 15 MPa FOR BLINDING CONCRETE.
3. GRADE OF REINFORCEMENT SHALL BE DEFORMED BAR MPa (GRADE 60) - ASTM A615/A615M.
4. NET SAFE BEARING CAPACITY OF SOIL AT BOTTOM OF FOUNDATION IS CONSIDERED AS 350KN/SQ.M.
5. IF ANY PART OF FOUNDATION COMES ON BACKFILL ZONE OF ADJACENT FOUNDATION OR ANY LOOSE SOIL ARE ENCOUNTERED BELOW FOUNDATION LEVEL THE SAME SHALL BE REMOVED AND FILLED WITH PCC.
6. FOR STANDARD DETAILS OF ANCHOR BOLTS REFER DRG. NO. MD-216-1000-EG-CV-DED-1003.
7. THIS DRAWING IS TO BE READ IN CONJUNCTION WITH DRG.NO. MD-216-49EE-EG-CV-DED-1590-A01.
8. FOR DETAILS OF HEAVY DUTY GRADE SLAB REFER DRAWING NO.MD-216-1000-EG-CV-DED-1002.

DOCUMENT NUMBER	REFERENCE DOCUMENTS	REV	DATE	REVISION DESCRIPTION	DRN	CHK	ENG	APP	EMP
		D01	16/02/2023	AS-BUILT	SYA	SJM	AVG	AG	
		C03	17/05/2021	ISSUED FOR CONSTRUCTION & REVISED AS MARKED C03	SYA	SJM	AVG	AG	
		C02	15/03/2021	ISSUED FOR CONSTRUCTION & REVISED AS MARKED C02	SYA	SJM	AVG	AG	
MD-216-49EE-EG-ST-GAD-1003	WASTE STORAGE BUILDING : PLAN, ELEVATION & SECTION	C01	09/09/2020	ISSUED FOR CONSTRUCTION	SYA	SJM	SOR	AG	
MD-216-4010-EG-AR-DGA-0005	GENERAL SITE AREA WASTE STORAGE BUILDING	A01	27/07/2020	ISSUED FOR REFERENCE	DSR	SJM	SOR	AG	

RESERVED FOR VENDOR LOGO AND DRAWING NUMBER

LARSEN & TOUBRO

This drawing is the property of LARSEN & TOUBRO and must not be passed on to any person or body not authorized by us to receive it nor be copied or otherwise made use either in full or in part by such person or body without our prior permission in writing.

Outotec

The content of these documents are the sole property of Outotec Oyj. Any rights not expressly granted herein are reserved. Reproduction, transfer or distribution of part or all of the contents in any form without prior written permission of Outotec is prohibited.

MA'ADEN معادن
Saudi Arabian Mining Company شركة التعدين العربية السعودية

This document and the information contained herein is Ma'aden proprietary know-how. This document or any part thereof should not be reproduced, stored in a retrieval system or transmitted by any means, electronic or otherwise, or divulged without prior written permission of Ma'aden.

LARSEN & TOUBRO DRAWING NUMBER: 019045_045_C_G_24283_001 | REVISION: 4
OUTOTEC DRAWING NUMBER: 900707__GAU01__AG90__MTL01__50023 | DOCUMENT ID: OU100692386 | REVISION: 4

DRAWN	DSR	23/07/2020
CHECKED	SJM	24/07/2020
ENGINEER	SOR	23/07/2020
APPROVED	AG	27/07/2020
EMPLOYER		
SCALE	1:100, 50	A1

MANSOURAH - MASSARAH GOLD PROJECT
GENERAL ARRANGEMENT
WASTE DISPOSAL : WASTE STORAGE BUILDING
BUILDING FOUNDATION LAYOUT & GA

DRAWING NUMBER: MD-216-49EE-EG-CV-GAD-1587 | REV: D01