


DRAWING NUMBER MD-216-49EE-EG-CV-GAD-1588 REV D01

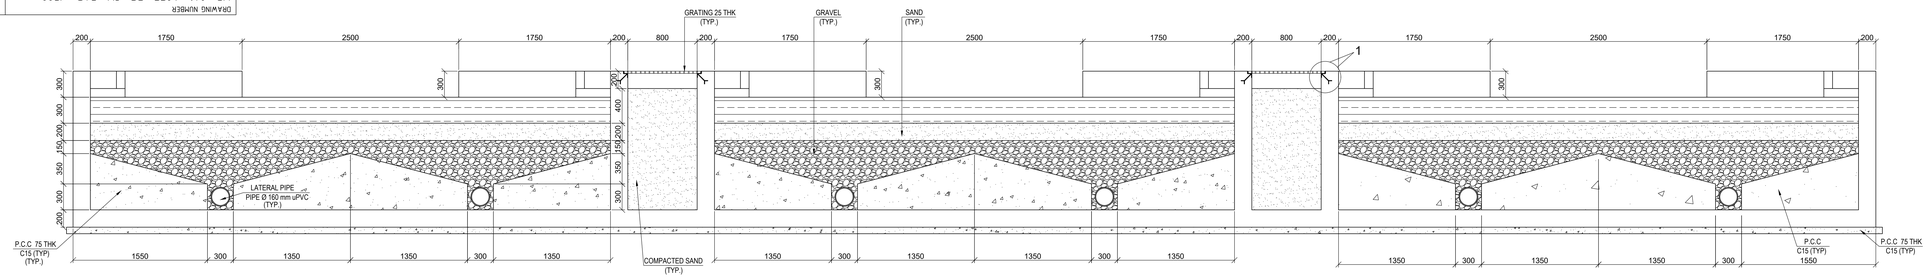


SECTION A-A
(FOR R.C DETAILS REFER MD-216-49EE-EG-CV-DED-1591)
(SCALE - 1:25)

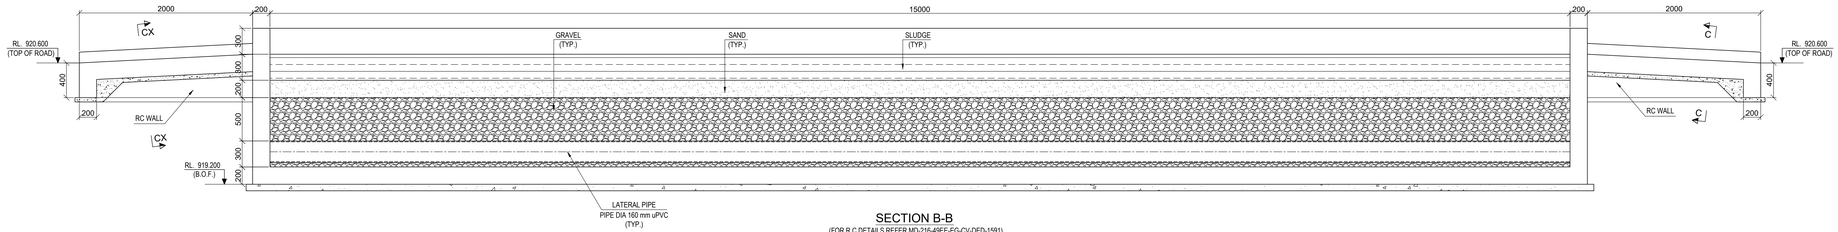


SECTION B-B
(FOR R.C DETAILS REFER MD-216-49EE-EG-CV-DED-1591)
(SCALE - 1:25)

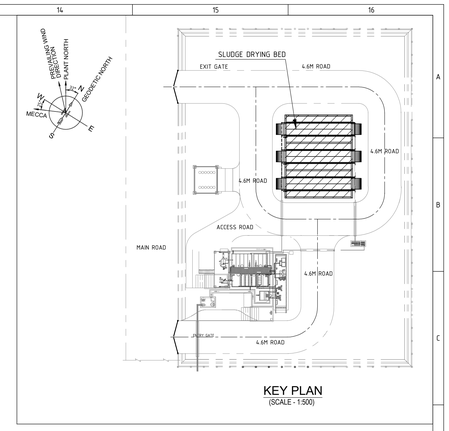


KEY PLAN
(SCALE - 1:500)

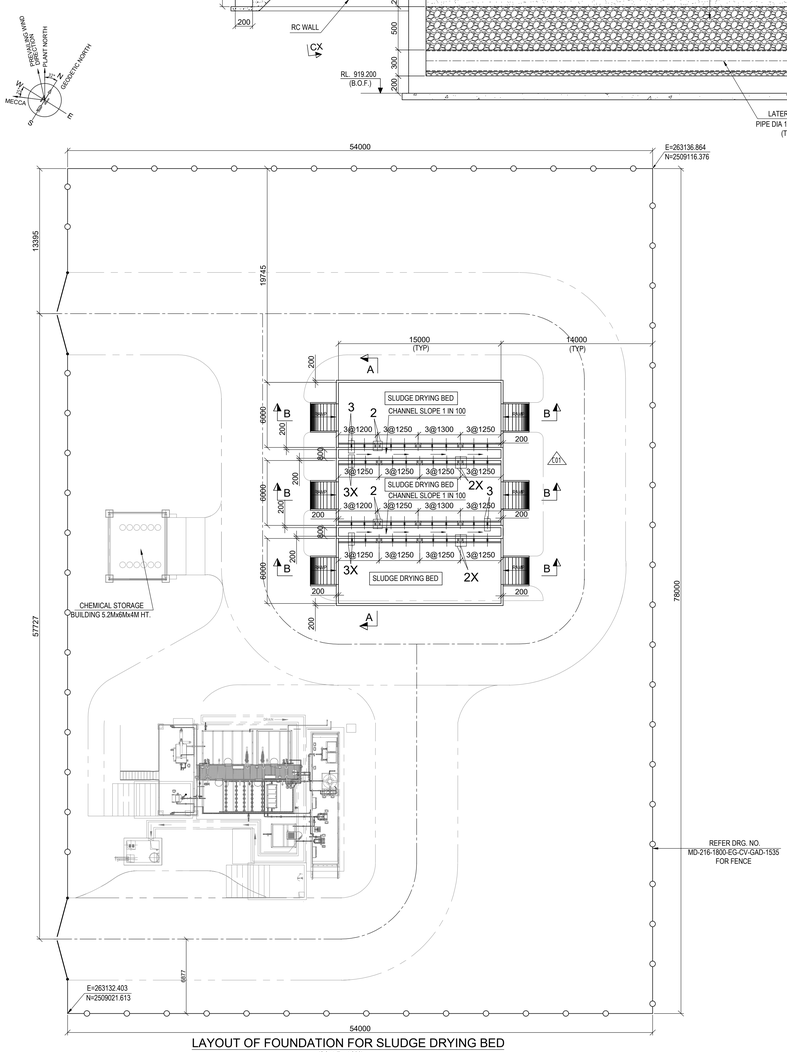


LAYOUT OF FOUNDATION FOR SLUDGE DRYING BED
(SCALE - 1:200)

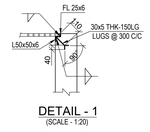


DETAIL - 1
(SCALE - 1:20)

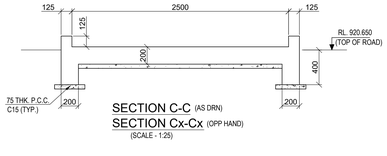

SECTION C-C (AS DRN)
SECTION Cx-Cx (OPP HAND)
(SCALE - 1:25)

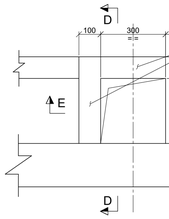


DETAIL - 2
(SCALE - 1:10)

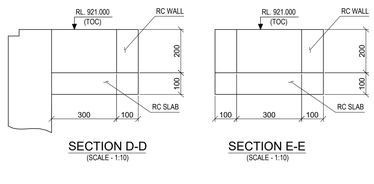


SECTION D-D
(SCALE - 1:10)

SECTION E-E
(SCALE - 1:10)

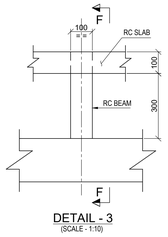

DETAIL - 3
(SCALE - 1:10)

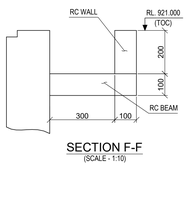

SECTION F-F
(SCALE - 1:10)

LEGEND :-

RL - REDUCED LEVEL
℄ - CENTRE LINE
T.O.C. - TOP OF CONCRETE
TYP. - TYPICAL
F.G.L. - FINISHED GROUND LEVEL
B.O.F. - BOTTOM OF FOUNDATION
P.C.C. - PLAIN CEMENT CONCRETE
THK. - THICK
GA - GENERAL ARRANGEMENT
LG - LONG
DIA - DIAMETER
C/C - CENTRE TO CENTRE
DRN - DRAWN
OPP - OPPOSITE
RC - REINFORCEMENT CONCRETE

NOTES :-

1. ALL DIMENSIONS ARE IN MILLIMETRES AND LEVELS AND CO-ORDINATES ARE IN METRES. UNLESS OTHERWISE STATED.
2. GRADE OF CONCRETE SHALL BE C35 FOR FOUNDATION.
3. GRADE OF REINFORCEMENT SHALL BE DEFORMED BAR ASTM A615 - GRADE 60 (fy = 420 MPa).
4. IF ANY PART OF FOUNDATION COMES ON BACKFILL ZONE OF ADJACENT FOUNDATION OR ANY LOOSE SOIL ARE ENCOUNTERED BELOW FOUNDATION LEVEL THE SAME SHALL BE REMOVED AND FILLED WITH PCC (15MPa).
5. THE CONTENT OF THIS DRAWING SHALL CONFORM TO THE PROVISIONS OF CIVIL, STRUCTURAL & ARCHITECTURAL DESIGN CRITERIA DOCUMENT NO. MD-216-1000-EG-ST-CRT-1001.

DOCUMENT NUMBER	REFERENCE DOCUMENTS	REV	DATE	REVISION DESCRIPTION	DRN	CHK	ENG	APP	EMP
		D01	16/02/2023	AS-BUILT	DSR	SJM	BJB	AG	
		C01	11/12/2020	ISSUED FOR CONTRUCTION & REVISED AS MKD. 01	DSR	SJM	BJB	AG	
		A01	14/10/2020	ISSUED FOR REFERENCE	DSR	SJM	BJB	AG	

RESERVED FOR VENDOR LOGO AND DRAWING NUMBER

LARSEN & TOUBRO DRAWING NUMBER: 019045_045_C_G_24284_001 — REVISION: 2
OUTOTEC DRAWING NUMBER: 900707__GAU01__AG90__MTL01__50024 — DOCUMENT ID: OU100692387 — REVISION: 2

LARSEN & TOUBRO
This drawing is the property of LARSEN & TOUBRO and must not be passed on to any person or body not authorized by us to receive it nor be copied or otherwise made use either in full or in part by such person or body without our prior permission in writing.

Outotec
The content of these documents are the sole property of Outotec Oyj. Any rights not expressly granted herein are reserved. Reproduction, transfer or distribution of part or all of the contents in any form without prior written permission of Outotec is prohibited.

MA'ADEN معادن Saudi Arabian Mining Company
This document and the information contained herein is Ma'aden proprietary know-how. This document or any part thereof should not be reproduced, stored in a retrieval system or transmitted by any means, electronic or otherwise, or divulged without prior written permission of Ma'aden.

DRAWN	DSR	28/09/2020	MANSOURAH - MASSARAH GOLD PROJECT
CHECKED	SJM	30/09/2020	GENERAL ARRANGEMENT
ENGINEER	BJB	27/09/2020	SEWERAGE TREATMENT PLANT
APPROVED	AG	14/10/2020	SLUDGE DRYING BED - GA PLAN & SECTIONS
EMPLOYER			DRAWING NUMBER: MD-216-49EE-EG-CV-GAD-1588 — REV: D01
SCALE	1:200, 25, 20	A0	