


DRAWING NUMBER MD-216-49EE-EG-CV-GAD-1592 REV D01

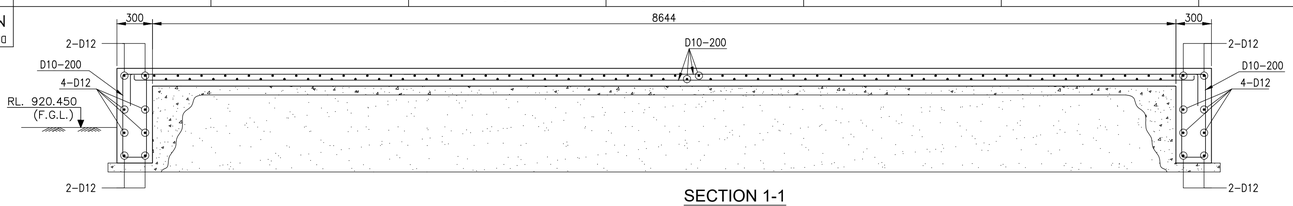


SECTION 1-1
(RCC DETAIL)
(SCALE – 1:25)

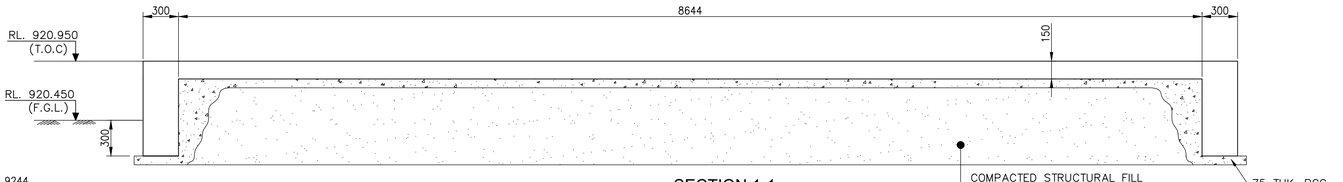


SECTION 1-1
(GA DETAIL)
(SCALE – 1:25)

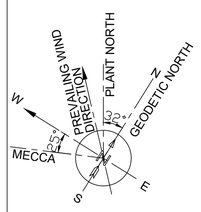


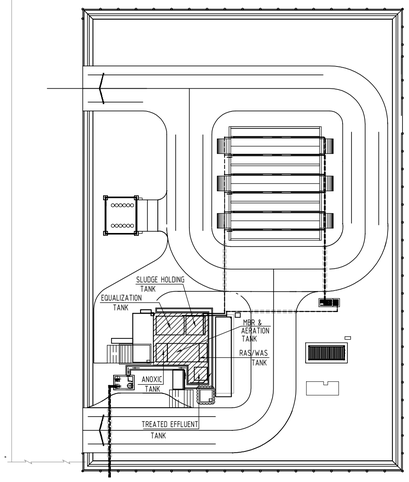


KEY PLAN
(SCALE- 1:500)

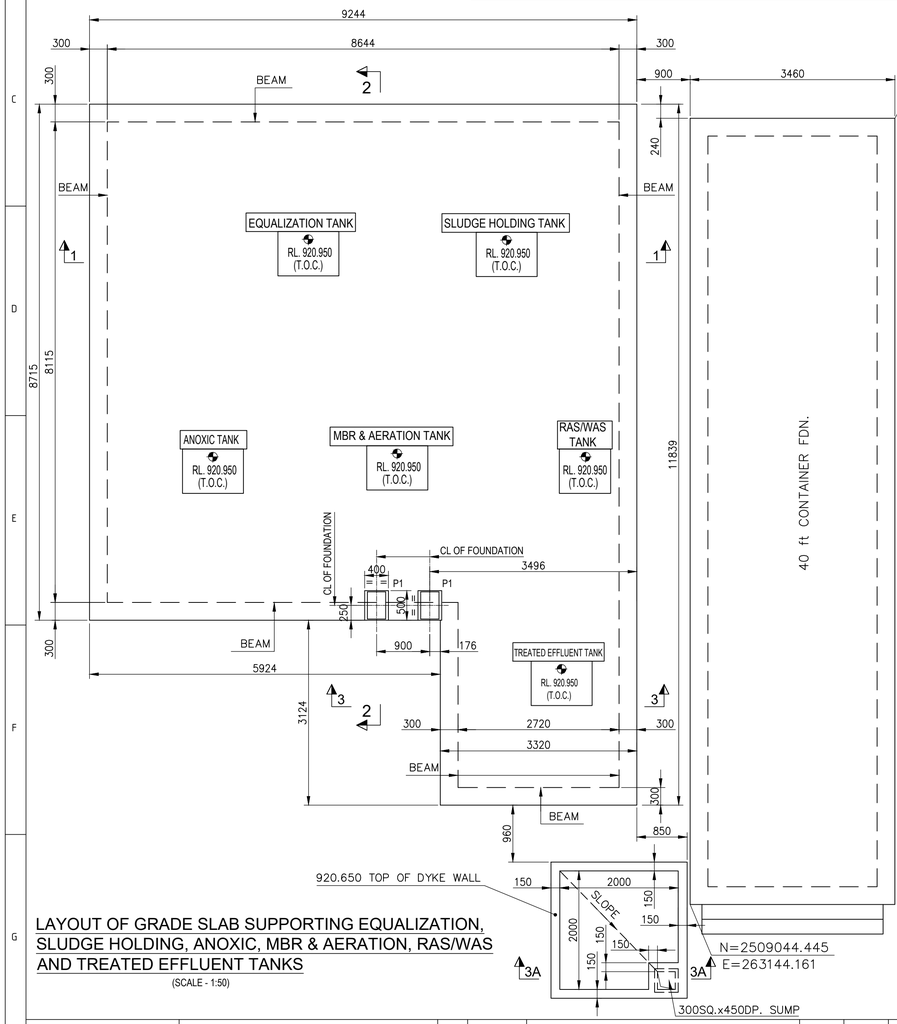


LAYOUT OF GRADE SLAB SUPPORTING EQUALIZATION, SLUDGE HOLDING, ANOXIC, MBR & AERATION, RAS/WAS AND TREATED EFFLUENT TANKS
(SCALE - 1:50)

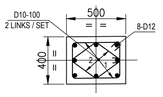


SECTION 4-4
(SCALE = 1:25)

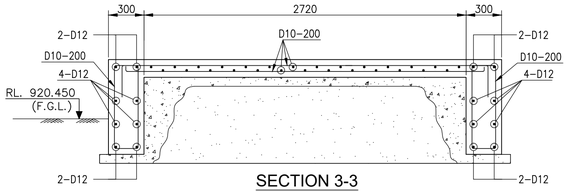


SECTION 3-3
(RCC DETAIL)
(SCALE – 1:25)

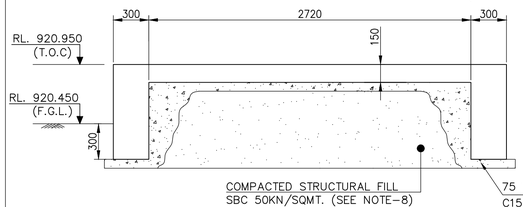


SECTION 3-3
(GA DETAIL)
(SCALE – 1:25)

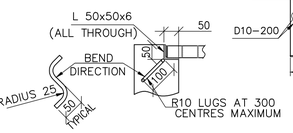


DETAIL - 'A'
(SCALE – 1:25)

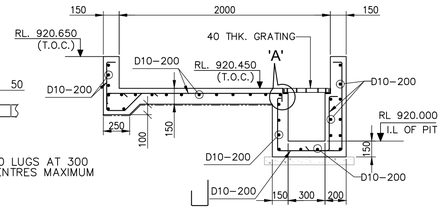

SECTION 3A-3A
(SCALE – 1:25)

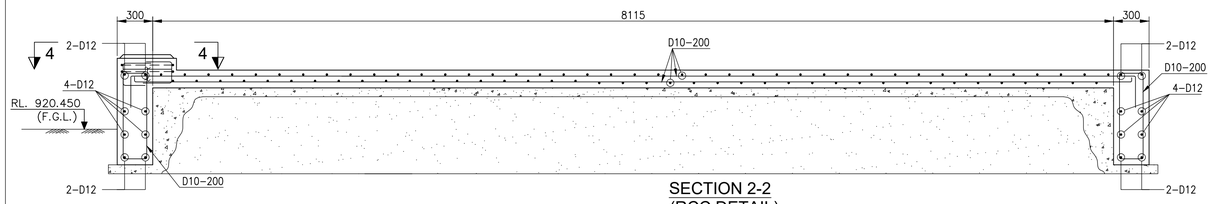

SECTION 2-2
(RCC DETAIL)
(SCALE – 1:25)

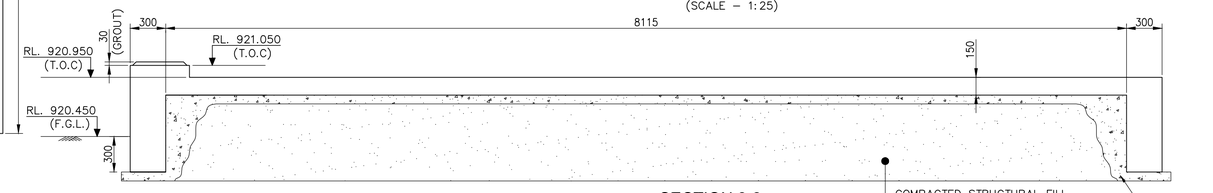

SECTION 2-2
(GA DETAIL)
(SCALE – 1:25)

LEGEND :-
R.L. - REDUCED LEVEL
T.O.C. - TOP OF CONCRETE
TYP. - TYPICAL
F.G.L. - FINISHED GROUND LEVEL
PCC - PLAIN CEMENT CONCRETE
THK. - THICK
GA - GENERAL ARRANGEMENT
RCC - REINFORCED CEMENT CONCRETE
FDN. - FOUNDATION
SBC - SAFE BEARING CAPACITY
SQMT - SQUARE METRE
DRG.-DRAWING
DET.-DETAIL
B.O.W.-BOTTOM OF WALL
I.L - INVERT LEVEL

NOTES :-
1. ALL DIMENSIONS ARE IN MILLIMETRES AND LEVELS AND CO-ORDINATES ARE IN METRES UNLESS OTHERWISE STATED.
2. GRADE OF CONCRETE SHALL BE 35MPa FOR RCC AND 15MPa FOR BLINDING CONCRETE.
3. GRADE OF REINFORCEMENT SHALL BE DEFORMED BAR (GRADE 60)- ASTM A615/f$_y$ = 420 MPa.
4. FOR MINIMUM LAP LENGTH OF REINFORCEMENT REFER DRG. NO. MD-216-1000-EG-CV-DED-1001.
5. CLEAR COVER TO REINFORCEMENT SHALL BE AS
   a) WALL = 50 mm
   b) SLAB = 25mm
6. IF ANY PART OF FOUNDATION COMES ON BACKFILL ZONE OF ADJACENT FOUNDATION OR ANY LOOSE SOIL ARE ENCOUNTERED BELOW FOUNDATION LEVEL THE SAME SHALL BE REMOVED AND FILLED WITH PCC.
7. THE CONTENT OF THIS DRAWING SHALL CONFORM TO THE PROVISIONS OF CIVIL, STRUCTURAL & ARCHITECTURAL DESIGN CRITERIA DOCUMENT NO. MD-216-1000-EG-ST-CRT-1001 & GENERAL NOTES DRG. NO. MD-216-1000-EG-CV-DED-1001
8. STRUCTURAL FILL SHALL CONFORM TO PROVISIONS OF DOCUMENT MD-216-1000-EG-CV-MST-1698.

DOCUMENT NUMBER	REFERENCE DOCUMENTS	REV	DATE	REVISION DESCRIPTION	DRN	CHK	ENG	APP	EMP
		D01	16/02/2023	AS-BUILT	PML	BJB	APEX	SJM	
		C03	25/06/2021	ISSUED FOR CONSTRUCTION AND REVISED AS MARKED C03	PML	BJB	APEX	SJM	
		C02	26/04/2021	ISSUED FOR CONSTRUCTION AND REVISED AS MARKED C02	APEX	BJB	APEX	SJM	
		C01	20/01/2021	ISSUED FOR CONSTRUCTION AND REVISED AS MARKED C01	APEX	BJB	APEX	SJM	
		A01	02/11/2020	ISSUED FOR REVIEW	APEX	BJB	APEX	SJM	

RESERVED FOR VENDOR LOGO AND DRAWING NUMBER

LARSEN & TOUBRO
This drawing is the property of LARSEN & TOUBRO and must not be passed on to any person or body not authorized by us to receive it nor be copied or otherwise made use either in full or in part by such person or body without our prior permission in writing.

Outotec
The content of these documents are the sole property of Outotec Oy). Any rights not expressly granted herein are reserved. Reproduction, transfer or distribution of part or all of the contents in any form without prior written permission of Outotec is prohibited.

MA'ADEN معادن
Saudi Arabian Mining Company شركة معادن العربية السعودية
This document and the information contained herein is Ma'aden proprietary know-how. This document or any part thereof should not be reproduced, stored in a retrieval system or transmitted by any means, electronic or otherwise, or divulged without prior written permission of Ma'aden.

LARSEN & TOUBRO DRAWING NUMBER	019045_045_C_G_24288_001	REVISION 4
OUTOTEC DRAWING NUMBER	900707__GAU01__AG90__MTL01__50025	DOCUMENT ID OU100692388 / REVISION 4

DRAWN	APEX	29/10/2020
CHECKED	BJB	30/10/2020
ENGINEER	APEX	28/10/2020
APPROVED	SJM	02/11/2020
EMPLOYER		
SCALE	1:50,25	A1

MANSOURAH - MASSARAH GOLD PROJECT
GENERAL ARRANGEMENT
SEWAGE TREATMENT PLANT
EQUALIZATION TANK & SLUDGE HOLDING TANK FDN.- GA & RCC DET.

DRAWING NUMBER MD-216-49EE-EG-CV-GAD-1592 REV D01