


DRAWING NUMBER: MD-216-49EE-EG-CV-GAD-1593 | REV: D01

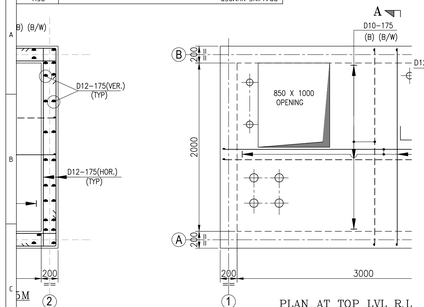


PLAN AT TOP LVL R.L
SURGE SEWAGE TAN
(R.C.C. DETAILS)
SCALE 1:25

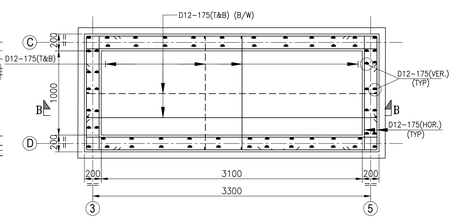


PLAN AT FOUNDATION LVL R.L 918.25M
SUMP TANK
(R.C.C. DETAILS)
SCALE 1:25

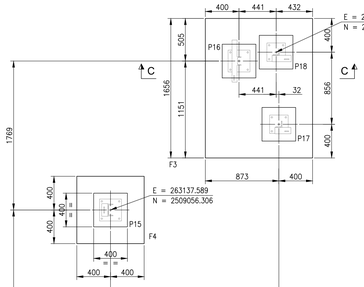


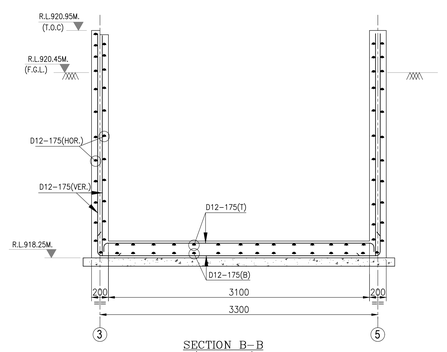


SECTION B-B
(R.C.C. DETAIL)
SCALE 1:25

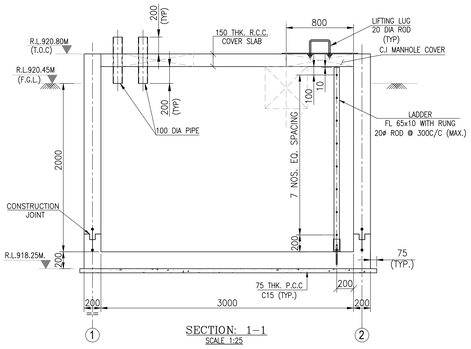


SECTION: 1-1
SCALE 1:25

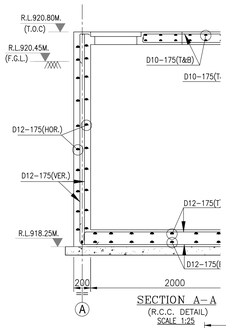


SECTION A-A
(R.C.C. DETAIL)
SCALE 1:25

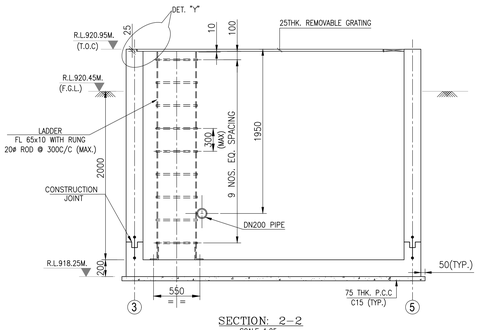

SECTION: 2-2
SCALE 1:25

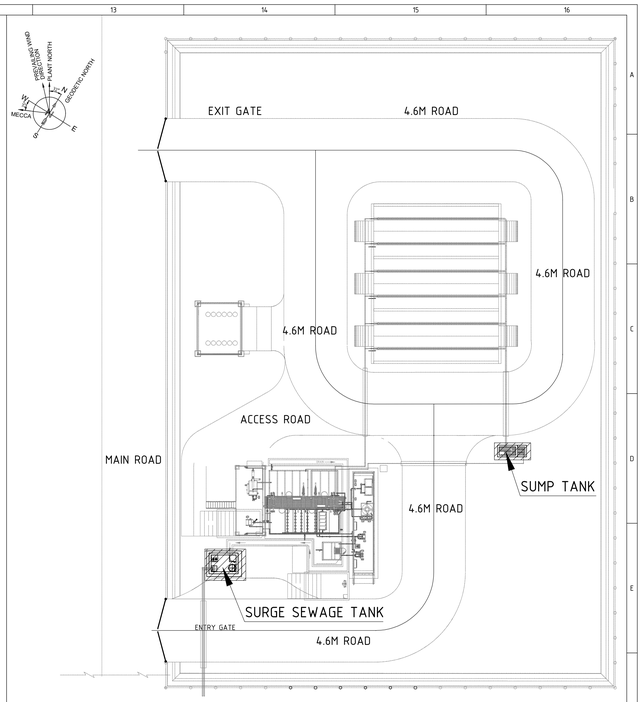


KEY PLAN

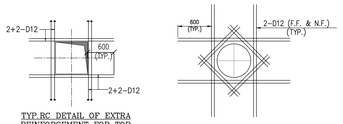



TYP.RC DETAIL OF EXTRA REINFORCEMENT FOR TOP SLAB & WALL OPENING

TYP.RCC DETAIL OF EXTRA REINFORCEMENT FOR MANHOLE OPENING

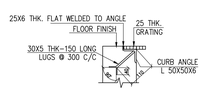


DETAIL-Y
(SHOWING DETAIL OF CURB ANGLE)

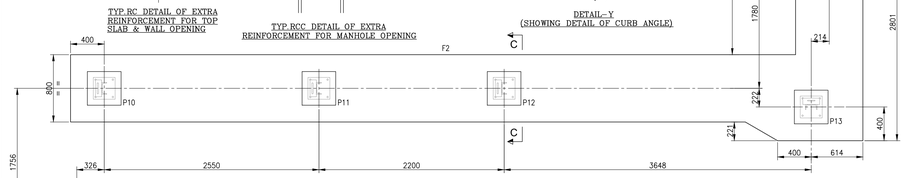


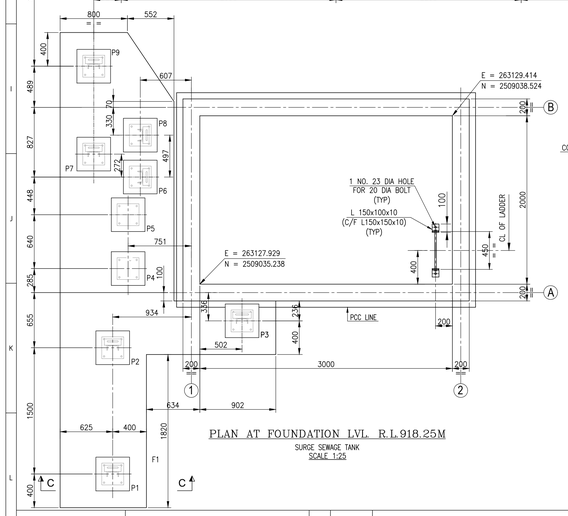


PLAN AT FOUNDATION LVL R.L 918.25M
SURGE SEWAGE TANK
SCALE 1:25

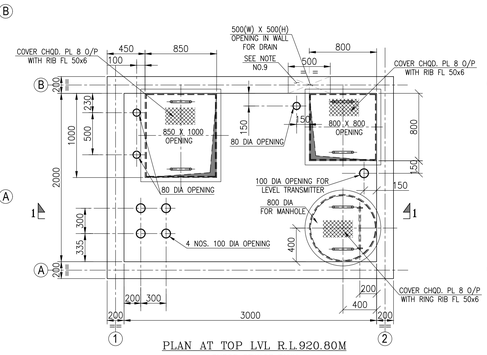


PLAN AT TOP LVL R.L 920.80M
SURGE SEWAGE TANK
SCALE 1:25

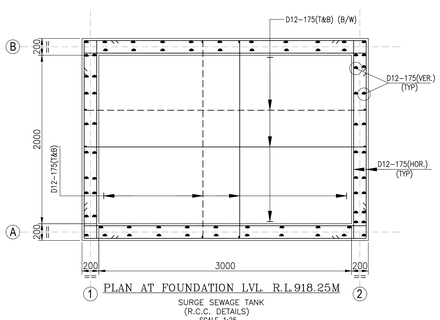

PLAN AT FOUNDATION LVL R.L 918.25M
SURGE SEWAGE TANK
(R.C.C. DETAILS)
SCALE 1:25

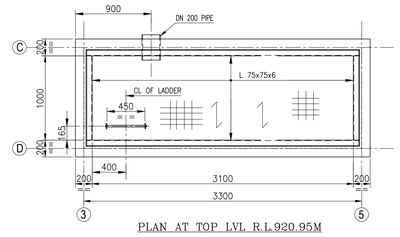


PLAN AT TOP LVL R.L 920.95M
SUMP TANK
SCALE 1:25

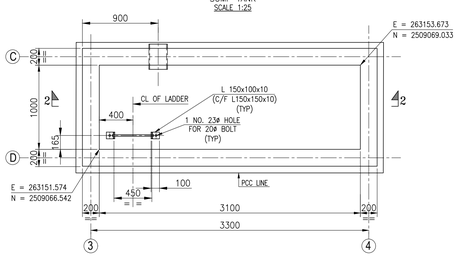


PLAN AT FOUNDATION LVL R.L 918.25M
SUMP TANK
SCALE 1:25

PEDESTAL MARKED	PEDESTAL SIZE	T.O.C FROM F.G.L (X) MM.
P1	400X400	175
P2	400X400	175
P3	400X400	190
P4	400X400	125
P5	400X400	125
P6	400X400	175
P7	400X400	175
P8	400X400	175
P9	400X400	175


PEDESTAL MARKED	PEDESTAL SIZE	T.O.C FROM F.G.L (X) MM.
P10	400X400	175
P11	400X400	175
P12	400X400	175
P13	400X400	290
P14	400X400	290
P15	400X400	155
P16	400X400	145
P17	400X400	145
P18	400X400	145

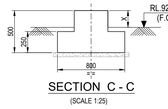


SECTION C - C
(SCALE 1:25)

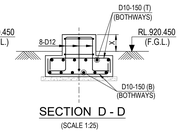

SECTION D - D
(SCALE 1:25)

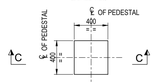

TYP. DETAIL OF PEDESTAL MKD. P1 TO P18
(SCALE 1:25)

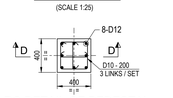

RC DETAIL OF PEDESTAL MKD. P1 TO P18
(SCALE 1:25)

LEGENDS :

TOC - TOP OF CONCRETE	RCC - REINFORCED CEMENT CONCRETE
R.L - REDUCED LEVEL	C/C - CENTRE TO CENTRE
TYP - TYPICAL	THK. - THICK
P.C.C - PLAIN CEMENT CONCRETE	O/P - OVER PLATE
F.G.L - FINISHED GROUND LEVEL	W - WIDTH
CL - CENTRE LINE	H - HEIGHT
SEC. - SECTION	PL - PLATE
DETS. - DETAIL	CHQD. - CHEQUERED
DRG. - DRAWING	FL - FLAT
DIA - DIAMETER	MAX. - MAXIMUM
HOR - HORIZONTAL	B/W - BOTHWAYS
VER - VERTICAL	F.F - FAR FACE
T & B - TOP & BOTTOM	N.F - NEAR FACE
T - TOP	MKD. - MARKED
B - BOTTOM	O/P - OVER PLATE
LVL - LEVEL	C/F - CUT FROM

NOTES :-

1. ALL DIMENSIONS ARE IN MILLIMETRES AND LEVELS AND CO-ORDINATES ARE IN METRES UNLESS OTHERWISE STATED.
2. GRADE OF CONCRETE SHALL BE 35MPa FOR RCC AND 15 MPa FOR BLINDING CONCRETE.
3. GRADE OF REINFORCEMENT SHALL BE DEFORMED BAR MPa (GRADE 60) - ASTM M615fy=420Mpa.
4. NET SAFE BEARING CAPACITY OF SOIL AT BOTTOM OF FOUNDATION IS CONSIDERED AS 400 KN/m².
5. CLEAR COVER TO REINFORCEMENT SHALL BE AS
   a). FOUNDATION = 50mm.
   b). WALL = 40mm.
   c). SLAB = 25mm.
6. FOR MINIMUM LAP LENGTH OF REINFORCEMENT REFER DRG. NO. MD-216-1000-EG-CV-DED-1001.
7. IF ANY PART OF FOUNDATION COMES ON BACKFILL ZONE OF ADJACENT FOUNDATION OR ANY LOOSE SOIL ARE ENCOUNTERED BELOW FOUNDATION LEVEL THE SAME SHALL BE REMOVED AND FILLED WITH PCC.
8. THE CONTENT OF THIS DRAWING SHALL CONFORM TO THE PROVISIONS OF CIVIL, STRUCTURAL & ARCHITECTURAL DESIGN CRITERIA DOCUMENT NO. MD-216-1000-EG-ST-CRT-1001.
9. INVERT LEVEL OF CUTOUT (600x500) TO BE FINALIZED AS PER DRAINGE LAYOUT.

DOCUMENT NUMBER	REFERENCE DOCUMENTS	REV	DATE	REVISION DESCRIPTION	DRN	CHK	ENG	APP	EMP
		D01	16/02/2023	AS-BUILT	DSR	AVG	APEX	SJM	
		C03	03/03/2022	ISSUED FOR CONSTRUCTION & REVISED AS MKD. (3)	DSR	AVG	APEX	SJM	
		C02	07/09/2021	ISSUED FOR CONSTRUCTION & REVISED AS MKD. (2)	DSR	BJB	APEX	SJM	
		C01	02/09/2020	ISSUED FOR CONSTRUCTION & REVISED AS MKD. (1)	DSR	BJB	APEX	SJM	
49EE_STP_CIVIL INPUT	LAYOUT OF SEWAGE TREATMENT PLANT CIVIL INPUT	A01	19/10/2020	ISSUE FOR REFERENCE	APEX	BJB	APEX	SJM	

RESERVED FOR VENDOR LOGO AND DRAWING NUMBER

LARSEN & TOUBRO

This drawing is the property of LARSEN & TOUBRO and must not be passed on to any person or body not authorized by us to receive it nor to be copied or otherwise made use either in full or in part by such person or body without our prior permission in writing.

Outotec

The content of these documents are the sole property of Outotec Oyj. Any rights not expressly granted herein are reserved. Reproduction, transfer or distribution of part or all of the contents in any form without prior written permission of Outotec is prohibited.

MA'ADEN معادن Saudi Arabian Mining Company شركة فحيحين العربية السعودية

This document and the information contained herein is Ma'aden proprietary know-how. This document or any part thereof should not be reproduced, stored in a retrieval system or transmitted by any means, electronic or otherwise, or divulged without prior written permission of Ma'aden.

LARSEN & TOUBRO DRAWING NUMBER			REVISION
019045_045_C_G_24422_001			4
OUTOTEC DRAWING NUMBER		DOCUMENT ID	REVISION
900707__GAU01__AG90__MTL01__50026		OU100697789	4
DRAWN	APEX	04/10/2020	MANSOURAH - MASSARAH GOLD PROJECT
CHECKED	BJB	05/10/2020	GENERAL ARRANGEMENT
ENGINEER	APEX	01/10/2020	SEWAGE TREATMENT PLANT
APPROVED	SJM	19/10/2020	SURGE SEWAGE & SUMP TANK PLAN SEC & DETS.
EMPLOYER			
SCALE 1:25	A0	DRAWING NUMBER MD-216-49EE-EG-CV-GAD-1593	REV D01