


DRAWING NUMBER: MD-216-39LA-EG-CV-GAD-1452 | REV: D01

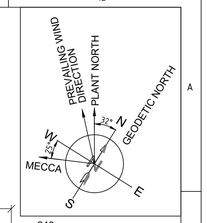


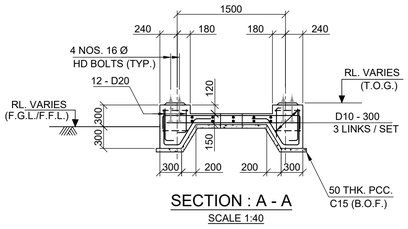


SECTION : A - A
SCALE 1:40

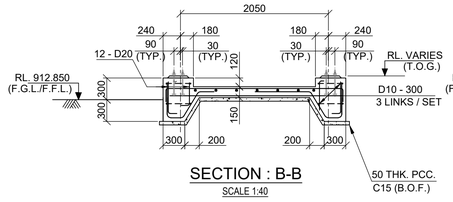


SECTION : B-B
SCALE 1:40

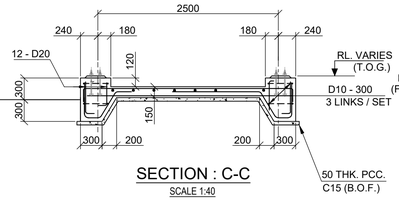


SECTION : C-C
SCALE 1:40

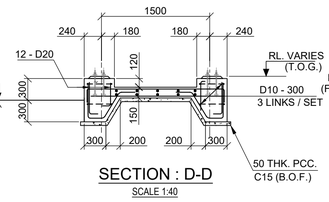


SECTION : D-D
SCALE 1:40

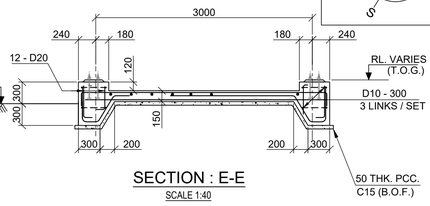


SECTION : E-E
SCALE 1:40

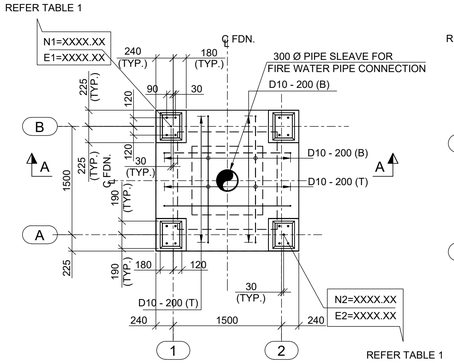


RCC. DETAIL OF
ACV FOUNDATION MKD-TYPE 1
16 NOS. REQD.

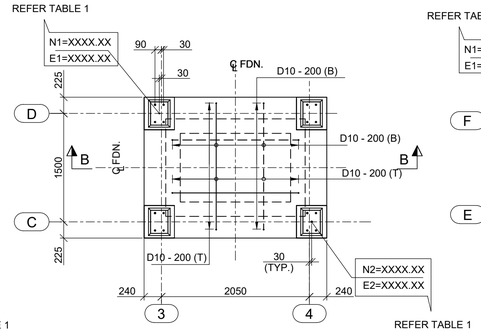


RCC. DETAIL OF
ACV FOUNDATION MKD-TYPE 2
1 NO. REQD.

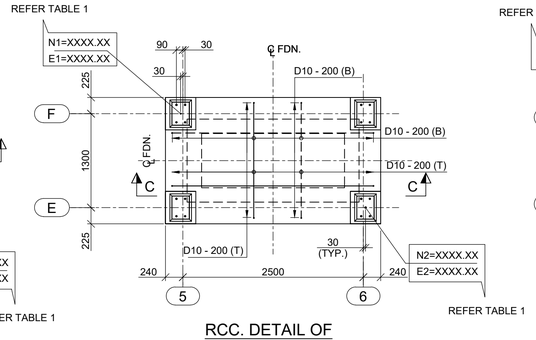

RCC. DETAIL OF
ACV FOUNDATION MKD-TYPE 3
1 NO. REQD.

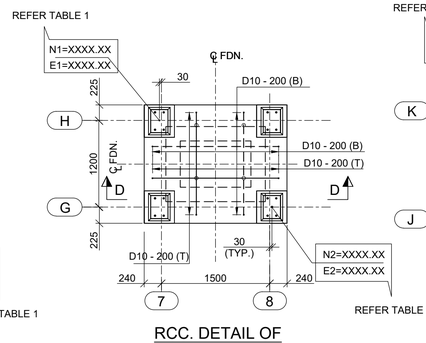

RCC. DETAIL OF
ACV FOUNDATION MKD-TYPE 4
1 NO. REQD.

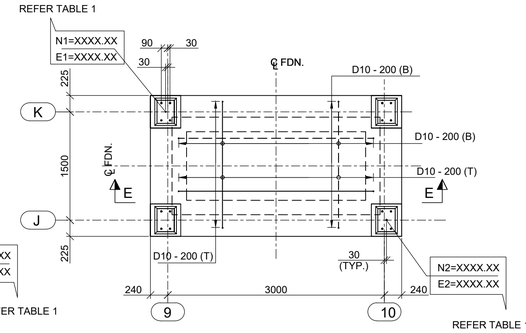

RCC. DETAIL OF
ACV FOUNDATION MKD-TYPE 5
1 NO. REQD.

TABLE 1

SL. NO.	ACV SHED MARK	COORDINATE (METRE)				FGL. (METRE)	REMARKS
		EAST-1 (E1)	NORTH-1 (N1)	EAST-2 (E2)	NORTH-2 (N2)		
1.	EMERGENCY SERVICES BUILDING	263787.255	2506217.397	263789.373	2506216.951	RL. 914.800	TYPE-1
2.	WAREHOUSE AND WORKSHOP39LA-SHD-969	264043.618	2506196.343	264046.202	2506196.189	RL. 913.100	TYPE-3
3.	BOILER ROOM	264013.679	2505935.635	264015.797	2505935.208	RL. 912.850	TYPE-1
4.	SMBS - REAGENT STORAGE ROOM39LA-SHD-965	264371.898	2506029.829	264374.016	2506029.384	RL. 911.900	TYPE-1
5.	POWER PLANT BUILDINGS (DIESEL GENERATOR HALL)WORKSHOP BUILDING)	263938.688	2506044.459	263940.647	2506044.268	RL. 913.100	TYPE-4
6.	WORKSHOP&WAREHOUSE_SHEE	264043.883	2506195.919	264046.467	2506195.765	RL. 913.100	TYPE-1
7.	CONVEYORS AREAS-3110-CNV-002	264339.395	2506457.385	264341.513	2506456.939	RL. 912.464	TYPE-1
8.	CONVEYORS AREAS-3120-CNV-001	264354.202	2506457.326	264356.320	2506456.881	RL. 912.440	TYPE-1
9.	CONVEYORS AREAS-3130-CNV-001	264316.205	2506493.939	264318.323	2506493.494	RL. 912.556	TYPE-1
10.	CONVEYORS AREAS-3130-CNV-002	264336.915	2506468.574	264339.033	2506468.128	RL. 912.490	TYPE-1
11.	CONVEYORS AREAS-3130-CNV-003	264309.583	2506380.835	264311.701	2506380.390	RL. 912.500	TYPE-1
12.	CONVEYORS AREAS-3210-CNV-001	264258.884	2506209.403	264261.002	2506208.957	RL. 913.000	TYPE-1
13.	CONVEYORS AREAS-3220-CNV-001	264252.745	2506207.476	264254.862	2506207.031	RL. 913.000	TYPE-1
14.	CONVEYORS AREAS-3360-CNV-002	264095.727	2506138.518	264097.845	2506138.073	RL. 913.000	TYPE-1
15.	COOLING TOWER-POX	264171.178	2505822.407	264173.296	2505821.962	RL. 912.350	TYPE-1
16.	COOLING TOWER-BALL MILL	264252.916	2506226.601	264255.034	2506226.156	RL. 913.000	TYPE-1
17.	COOLING TOWER-O2	264198.137	2505836.733	264200.255	2505836.288	RL. 912.350	TYPE-1
18.	PUMP HOUSE	264093.991	2505935.422	264093.737	2505938.281	RL. 912.850	TYPE-2
19.	LPG COMPRESSOR & VAPORIZER	263974.823	2505890.944	263976.940	2505890.498	RL. 913.000	TYPE-1
20.	HFO_STORAGE_TANK , LFO_STORAGE_TANK	263865.679	2505947.435	263865.997	2505943.972	RL. 913.400	TYPE-5

TABLE 1 :-
R.L. - REDUCED LEVEL
℄ - CENTRE LINE
T.O.C. - TOP OF CONCRETE
F.G.L. - FINISHED GROUND LEVEL
F.F.L. - FINISHED FLOOR LEVEL
B.O.F. - BOTTOM OF FOUNDATION
TYP. - TYPICAL
R.C.C - REINFORCED CEMENT CONCRETE
P.C.C - PLAIN CEMENT CONCRETE
MKD. - MARKED
THK. - THICK
T.O.G. - TOP OF GROUT
EQV. - EQUIVALENT
BOTTOM REINFORCEMENT (B) - – – – – –
TOP REINFORCEMENT (T) - ————
DET. - DETAIL
FDN. - FOUNDATION

NOTES:-
1. ALL DIMENSIONS ARE IN MILLIMETRES AND LEVELS AND CO-ORDINATES ARE IN METRES UNLESS OTHERWISE STATED.
2. GRADE OF CONCRETE SHALL BE C35 (35MPa) FOR FOUNDATION, C30 (30MPa) FOR GRADE SLAB & C15 (15MPa) FOR BLINDING CONCRETE.
3. GRADE OF REINFORCEMENT SHALL BE DEFORMED BAR 420 MPa (GRADE 60) - ASTM A615/A615M.
4. GRADE OF WELDED WIRE MESH SHALL BE GRADE 60 (fy = 420 MPa) ACCORDING TO A1064.
5. NET SAFE BEARING CAPACITY OF SOIL AT BOTTOM OF FOUNDATION IS CONSIDERED AS 350KN/ SQ. M.
6. CLEAR COVER TO REINFORCEMENT SHALL BE AS FOLLOWS
   a) FOUNDATION = 50 mm
   b) COLUMN = 50mm
   c) WALLS = 50mm
   d) SLAB = 20mm
7. FOR STANDARD REINFORCEMENT DETAIL & GENERAL NOTES FOR CIVIL WORKS REFER DRAWING NO. MD-216-1000-EG-CV-DED-1005 & 1001.
8. THIS DRAWING IS TO BE READ INCONJUNCTION WITH DWG. NO. MD-216-39LA-EG-ST-GAD-1002.
9. FOR CONCRETE GENERAL NOTES, REFER DRAWING NUMBER MD-216-1000-EG-CV-DED-1005

DOCUMENT NUMBER	REFERENCE DOCUMENTS	REV	DATE	REVISION DESCRIPTION	DRN	CHK	ENG	APP	EMP
		D01	10/03/2023	AS-BUILT	SUP	SJM	AVG	AG	
		C01	01/07/2021	ISSUED FOR CONSTRUCTION, REVISED AS PER EMPLOYER COMMENTS DATED 25/06/21 & AS MARKED.	SUP	SJM	AVG	AG	
		A01	28/05/2021	ISSUED FOR APPROVAL	SUP	SJM	AVG	AG	

RESERVED FOR VENDOR LOGO AND DRAWING NUMBER

LARSEN & TOUBRO
This drawing is the property of LARSEN & TOUBRO and must not be passed on to any person or body not authorized by us to receive it nor be copied or otherwise made use either in full or in part by such person or body without our prior permission in writing.

Outotec
The content of these documents are the sole property of Outotec Oyj. Any rights not expressly granted herein are reserved. Reproduction, transfer or distribution of part or all of the contents in any form without prior written permission of Outotec is prohibited.

MA'ADEN معادن
Saudi Arabian Mining Company شركة معادن العربية السعودية
This document and the information contained herein is Ma'aden proprietary know-how. This document or any part thereof should not be reproduced, stored in a retrieval system or transmitted by any means, electronic or otherwise, or divulged without prior written permission of Ma'aden.

LARSEN & TOUBRO DRAWING NUMBER	019045_080_C_G_24652_001	REVISION 2
OUTOTEC DRAWING NUMBER	900707_GAU01_AE01_MTL01_39129	DOCUMENT ID 0U100721772 / REVISION 2

DRAWN	SUP	19/05/2021
CHECKED	SJM	25/05/2021
ENGINEER	AVG	20/05/2021
APPROVED	AG	28/05/2021
EMPLOYER		
SCALE	1:10, 1:20, 1:40	A1

MANSOURAH - MASSARAH GOLD PROJECT
GENERAL ARRANGEMENT DRAWING
FIRE FIGHTING SYSTEM-STRUCTURAL SUN SHED
LAYOUT & DETAIL OF FOUNDATION

DRAWING NUMBER: MD-216-39LA-EG-CV-GAD-1452 | REV: D01