

DRAWING NUMBER: MD - 216 - 39LA - EG - CV - GAD - 1453 | REV: D01

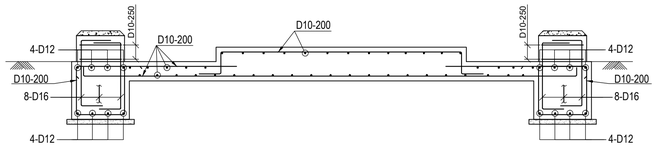


TYP. R.C DETAIL OF FDN. MKD. F1
SCALE 1:30


R.C DETAIL OF COL. MKD. C1
SCALE 1:20

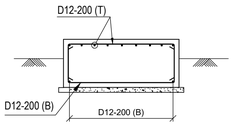


SECTION B-B
(R.C DETAILS)
SCALE 1:30

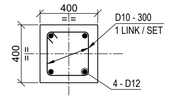


SECTION 1-1
SCALE 1:20

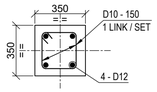


SECTION 2-2
SCALE 1:20

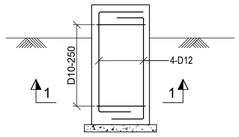


SECTION : C-C
(R.C DETAILS)
SCALE 1:20

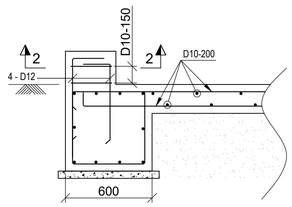


SECTION : A1-A1
(R.C DETAILS)
SCALE 1:20

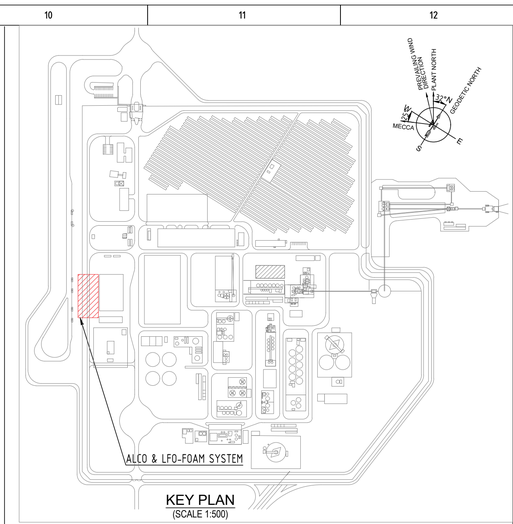


KEY PLAN
(SCALE 1:500)

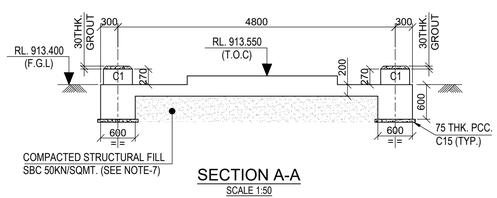


SECTION A-A
SCALE 1:50

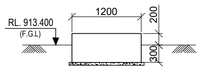


SECTION : B-B
SCALE 1:50

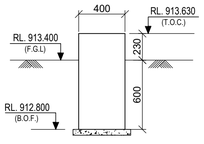


SECTION : C-C
SCALE 1:25

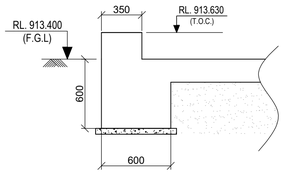


SECTION : A1-A1
SCALE 1:25

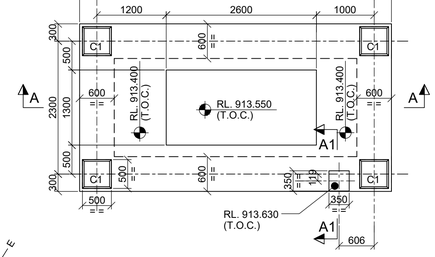


DETAIL OF FDN. MKD. F1
SCALE 1:50

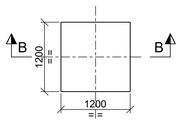


DETAIL OF FDN. MKD. F2
SCALE 1:50

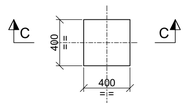

DETAIL OF FDN. MKD. F3
SCALE 1:25

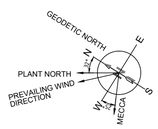

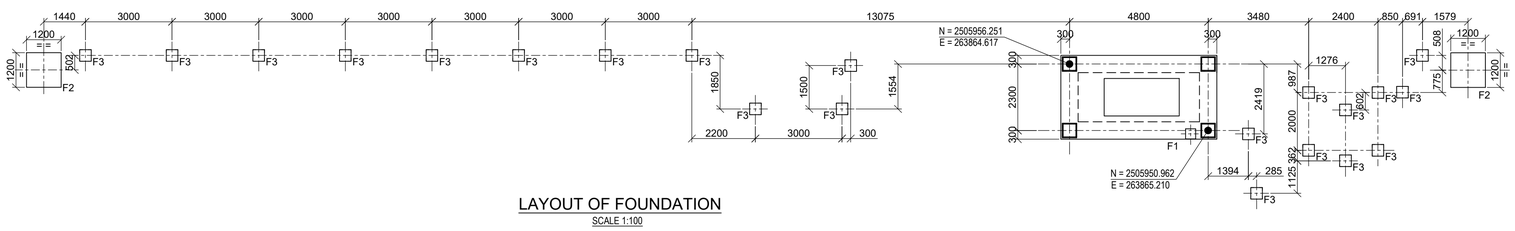

LAYOUT OF FOUNDATION
SCALE 1:100

(SCALE- 1:750)

LEGEND :-

R.L. - REDUCED LEVEL
℄ - CENTRE LINE
T.O.C. - TOP OF CONCRETE
F.G.L. - FINISHED GROUND LEVEL
R.C - REINFORCED CONCRETE
B.O.F. - BOTTOM OF FOUNDATION
MKD. - MARKED
GA - GENERAL ARRANGEMENT
COL. - COLUMN
REINF. - REINFORCEMENT
TYP. - TYPICAL
P.C.C - PLAIN CEMENT CONCRETE
THK - THICK
T.O.G. - TOP OF GROUT
DET. - DETAIL
DRG. - DRAWING
FDN. - FOUNDATION
R.C.C - REINFORCED CEMENT CONCRETE
BOTTOM REINFORCEMENT (B) - _ _ _
TOP REINFORCEMENT (T) - ———
CJ - CONSTRUCTION JOINT

NOTES:-

1. ALL DIMENSIONS ARE IN MILLIMETRES AND LEVELS AND CO-ORDINATES ARE IN METRES UNLESS OTHERWISE STATED.
2. NET SAFE BEARING CAPACITY OF SOIL AT BOTTOM OF FOUNDATION IS CONSIDERED AS 50KN/ SQ. M.
3. GRADE OF CONCRETE SHALL BE C35 (35Mpa) FOR FOUNDATION & GRADE SLAB & C15 (15Mpa) FOR BLINDING CONCRETE.
4. GRADE OF REINFORCEMENT SHALL BE DEFORMED BAR 420 MPa (GRADE 60) - ASTM A615/A615M.
5. CLEAR COVER TO REINFORCEMENT SHALL BE AS FOLLOWS
   a) FOUNDATION = 50 mm
   b) COLUMN = 50mm
6. IF ANY PART OF FOUNDATION COMES ON BACKFILL ZONE OF ADJACENT FOUNDATION OR ANY LOOSE SOIL ARE ENCOUNTERED BELOW FOUNDATION LEVEL THE SAME SHALL BE REMOVED AND FILLED WITH PCC.
7. FOR STANDARD REINFORCEMENT DETAIL & GENERAL NOTES FOR CIVIL WORKS REFER DRAWING NO. MD-216-1000-EG-CV-DED-1005 & 1001.
8. ANCHORAGE OF ALL EQUIPMENT AND STRUCTURE SHALL BE DONE BY ANCHOR FASTENER AS INDICATE IN DETAIL DRAWING.

DOCUMENT NUMBER	REFERENCE DOCUMENTS	REV	DATE	REVISION DESCRIPTION	DRN	CHK	ENG	APP	EMP
MD-216-39LA-EG-ST-GAD-1003	FIRE WATER SYSTEM ALCO & LFO - FOAM SYSTEM	D01	10/03/2023	AS-BUILT	SYA	SJM	AVG	AG	
	STRUCTURAL DETAIL OF SHED	C01	16/10/2021	ISSUED FOR CONSTRUCTION	SYA	SJM	AVG	AG	
MD-216-39LA-EG-FG-GAD-V513-2011	FIRE WATER SYSTEM ALCO & LFO - FOAM SYSTEM	A01	22/09/2021	ISSUED FOR APPROVAL	SYA	SJM	AVG	AG	

RESERVED FOR VENDOR LOGO AND DRAWING NUMBER

LARSEN & TOUBRO DRAWING NUMBER: 019045_080_C_G_24659_001 | REVISION: 2
OUTOTEC DRAWING NUMBER: 900707 _GAU01 _AE01 _MTL01 _39133 | DOCUMENT ID: OU100731915 | REVISION: 2

LARSEN & TOUBRO
This drawing is the property of LARSEN & TOUBRO and must not be passed on to any person or body not authorized by us to receive it nor be copied or otherwise made use either in full or in part by such person or body without our prior permission in writing.

Outotec
The content of these documents are the sole property of Outotec Oyj. Any rights not expressly granted herein are reserved. Reproduction, transfer or distribution of part or all of the contents in any form without prior written permission of Outotec is prohibited.

MA'ADEN معادن
Saudi Arabian Mining Company شركة التعدين العربية السعودية
This document and the information contained herein is Ma'aden proprietary know-how. This document or any part thereof should not be reproduced, stored in a retrieval system or transmitted by any means, electronic or otherwise, or divulged without prior written permission of Ma'aden.

DRAWN	SYA	18/09/2021	MANSOURAH - MASSARAH GOLD PROJECT
CHECKED	SJM	20/09/2021	GENERAL ARRANGEMENT DRAWING
ENGINEER	AVG	18/09/2021	FIRE WATER SYSTEM:ALCO & LFO-FOAM SYSTEM
APPROVED	AG	22/09/2021	DETAIL OF MISCELLANEOUS FOUNDATION
EMPLOYER			
SCALE 1:150, 50, 40, 30	A1		DRAWING NUMBER: MD - 216 - 39LA - EG - CV - GAD - 1453 | REV: D01