


DRAWING NUMBER MD-216-39MA-EG-CV-DED-1039 REV D01

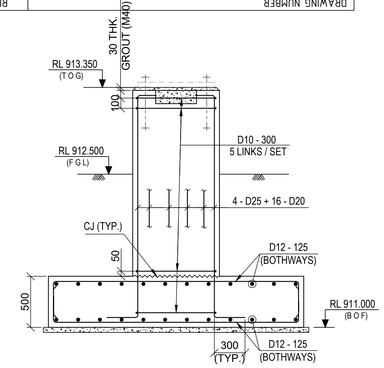


SECTION : 1-1
SCALE 1:30

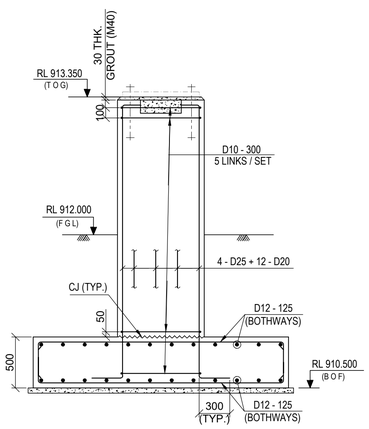


SECTION : 2-2
SCALE 1:30

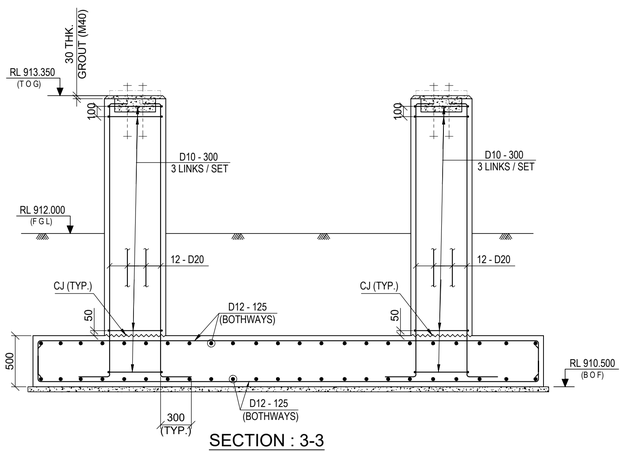


SECTION : 3-3
SCALE 1:30

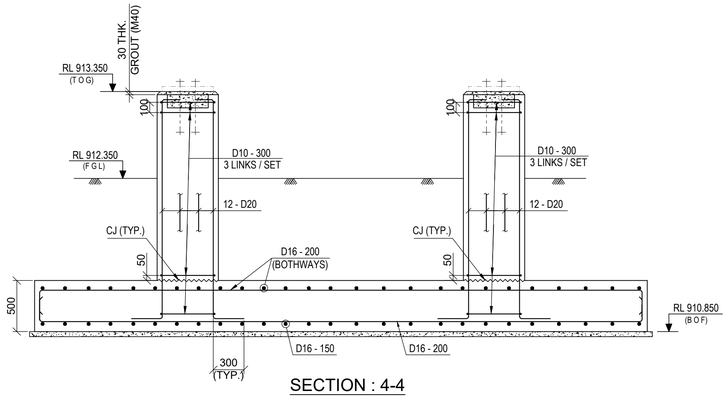


SECTION : 4-4
SCALE 1:30

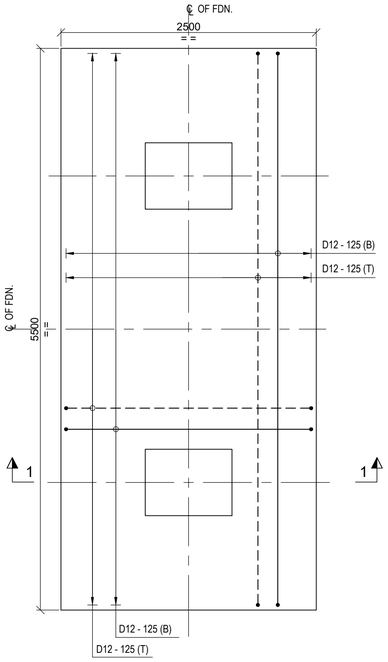


RC. DETAIL OF FOUNDATION MKD. F8A
SCALE 1:30

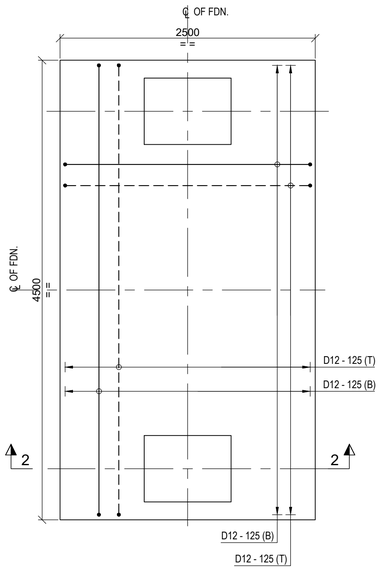


RC. DETAIL OF FOUNDATION MKD. F9B
SCALE 1:30

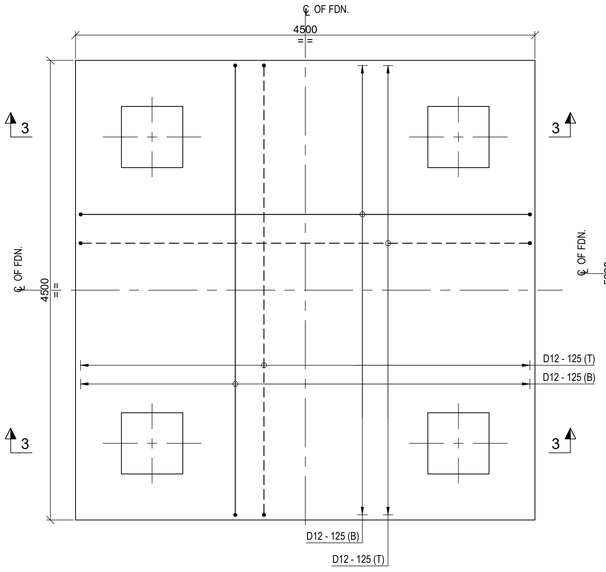


RC. DETAIL OF FOUNDATION MKD. F10A
SCALE 1:30

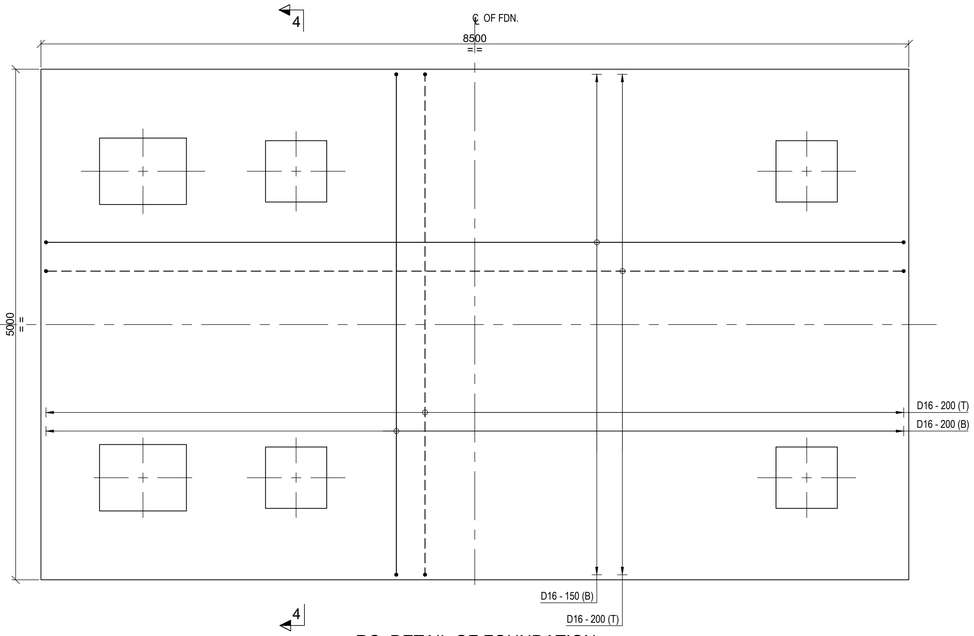


RC. DETAIL OF FOUNDATION MKD. F21
SCALE 1:30

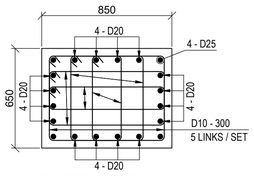

RC. DETAIL OF C8A
SCALE 1:20

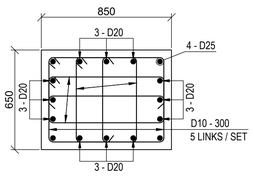

RC. DETAIL OF C9B
SCALE 1:20

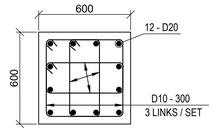

RC. DETAIL OF C10A & C21
SCALE 1:20

LEGEND :-

R L - REDUCED LEVEL
T O G - TOP OF GROUT
CJ - CONSTRUCTION JOINT
F G L - FINISHED GROUND LEVEL
P C C - PLAIN CEMENT CONCRETE
FDN. - FOUNDATION
B O F - BOTTOM OF FOUNDATION
———— - BOTTOM REINFORCEMENT SHOWN THUS (B)
– – – – - TOP REINFORCEMENT SHOWN THUS (T)
℄ - CENTRE LINE
THK. - THICK
TYP. - TYPICAL
RC. - REINFORCED CONCRETE
MKD. - MARKED
RCC - REINFORCED CEMENT CONCRETE

NOTES:-

1. GRADE OF CONCRETE SHALL BE 35 MPa FOR RCC, 15 MPa FOR BLINDING CONCRETE.
2. GRADE OF REINFORCEMENT SHALL BE DEFORMED BAR 420 MPa (GRADE 60) - ASTM A615/A615M.
3. CLEAR COVER TO MAIN REINFORCEMENT SHALL BE COLUMN - 50MM., FOUNDATION - 50 MM.
4. FOR ALL OTHER NOTES, REFER DRAWING NO. MD-216-39MA-EG-CV-GAD-1024.

DOCUMENT NUMBER	REFERENCE DOCUMENTS	REV	DATE	REVISION DESCRIPTION	DRN	CHK	ENG	APP	EMP
MD-216-39MA-EG-ME-GAD-1001	LAYOUT WITH ZONE MARKINGS	D01	10/03/2023	AS-BUILT	AMT	BDA	SML	AG	
MD-216-3000-EG-CV-GAD-1001	PROCESS PLANT EARTHWORKS	C01	19/09/2020	ISSUED FOR CONSTRUCTION	AMT	BDA	SML	AG	
MD-216-39MA-EG-ST-GAD-2001	PROCESS PLANT PIPE RACK CUM CABLE RACK	A01	19/08/2020	ISSUED FOR REFERENCE	AMT	BDA	SML	AG	

RESERVED FOR VENDOR LOGO AND DRAWING NUMBER

LARSEN & TOUBRO DRAWING NUMBER: O19045_080_C_D_24013_010 — REVISION: 2

OUTOTEC DRAWING NUMBER: 900707__GAU01__ZZ01__CTB17__00010 — DOCUMENT ID: OU100675382 — REVISION: 2

LARSEN & TOUBRO
This drawing is the property of LARSEN & TOUBRO and must not be passed on to any person or body not authorized by us to receive it nor be copied or otherwise made use either in full or in part by such person or body without our prior permission in writing.

Outotec
The content of these documents are the sole property of Outotec Oyj. Any rights not expressly granted herein are reserved. Reproduction, transfer or distribution of part or all of the contents in any form without prior written permission of Outotec is prohibited.

MA'ADEN معادن
Saudi Arabian Mining Company شركة معادن العربية السعودية
This document and the information contained herein is Ma'aden proprietary know-how. This document or any part thereof should not be reproduced, stored in a retrieval system or transmitted by any means, electronic or otherwise, or divulged without prior written permission of Ma'aden.

DRAWN	AMT	13/08/2020
CHECKED	BDA	17/08/2020
ENGINEER	SML	13/08/2020
APPROVED	AG	19/08/2020
EMPLOYER		
SCALE	1:30, 1:20	A1

MANSOURAH - MASSARAH GOLD PROJECT
DETAIL DRAWING
PROCESS PLANT PIPE RACK CUM CABLE RACK
RC DETAILS

DRAWING NUMBER: MD-216-39MA-EG-CV-DED-1039 — REV: D01