


DRAWING NUMBER MD-216-2500-EG-CV-GAD-2001 REV D01

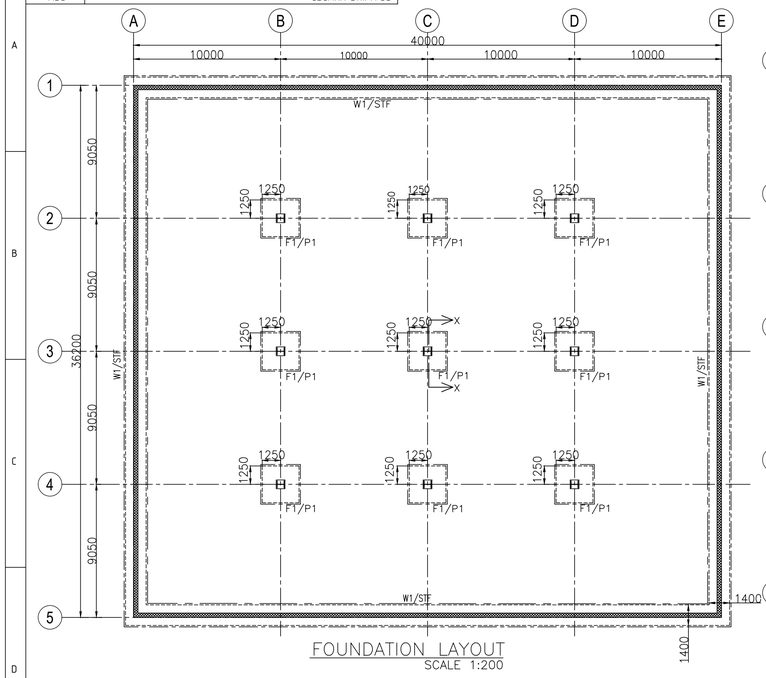


FOUNDATION LAYOUT
SCALE 1:200

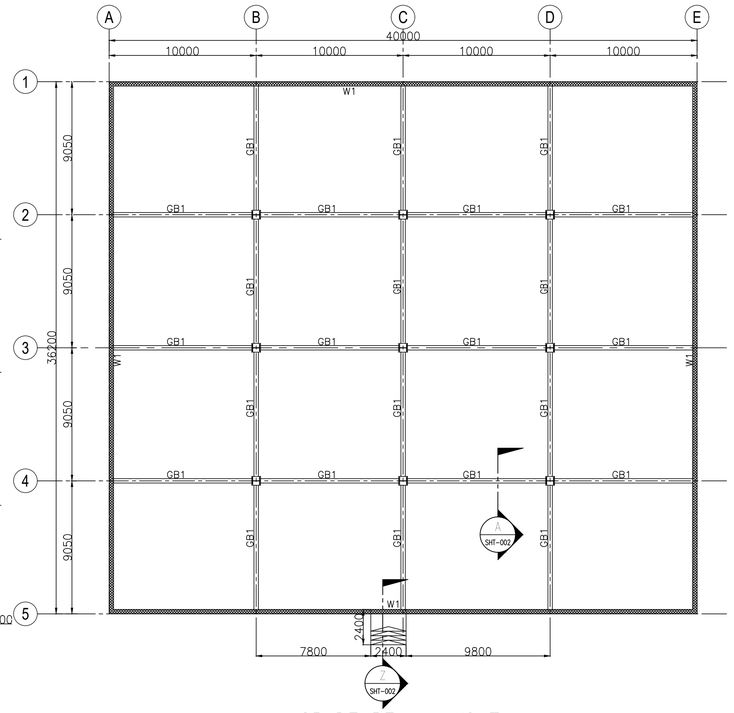

GRADE BEAM LAYOUT
SCALE 1:200

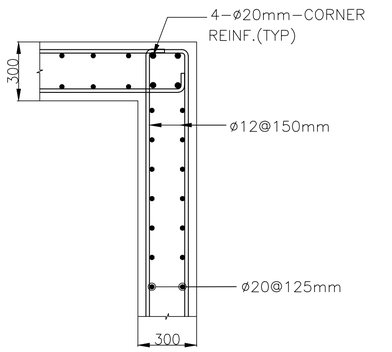


WALL CORNER REINF. DETAIL
SCALE: 1:100

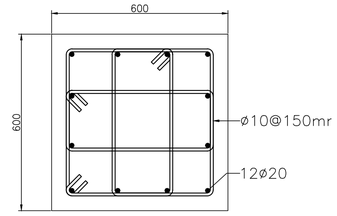

PEDESTAL DETAIL-P1
SCALE 1:50
(PROVIDE TOP '7' STIRRUPS @100mm C/C)

KEY PLAN

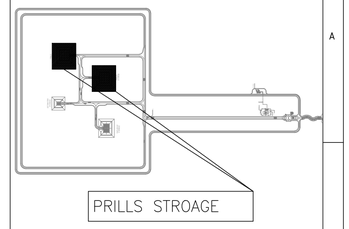

NOTES

1. ALL DIMENSIONS ARE GIVEN IN MILLIMETRES AND ELEVATIONS ARE IN METRES UNLESS OTHERWISE NOTED.
2. MINIMUM REINFORCED CONCRETE GRADE TO BE USED FOR SUPERSTRUCTURE & SUBSTRUCTURES IS C35(5000 PSI).
3. MINIMUM LEAN CONCRETE GRADE TO BE USED FOR THE SUB-STRUCTURES IS C15(2175 PSI).
4. ALL REINFORCING STEEL SHALL BE DEFORMED BILLET STEEL BARS CONFORMING TO ASTM-A615, WITH MINIMUM YIELD STRENGTH OF FY420 MPA .
5. THE NET SOIL BEARING CAPACITY CONSIDERED IN FOUNDATION DESIGN IS 570 KPA(REFER DOC 216-3000-EG-CV-RPT-1008)
6. WATER PROOFING INSULATION SHALL BE AS PER PROJECT SPECIFICATIONS & ITS MATERIAL TO BE APPROVED BY SITE ENGINEER.
7. MINIMUM CONCRETE COVER AS PER SBC-304-2018(TABLE 20.6.1.3.1) MEASURED FROM REBAR SHALL BE
   a. CONCRETE CAST AGAINST & PERMANENTLY EXPOSED TO EARTH (INCLUDING FOUNDATIONS OVER SUB-SLAB) FORMED CONCRETE EXPOSED TO EARTH OR WEATHER.....50MM
   b. CONCRETE NOT EXPOSED TO WEATHER NOR IN CONTACT WITH GROUND
      BEAMS, COLUMNS.....40MM
      SLABS, WALLS, JOISTS.....20MM
   c. CONCRETE SLAB OVER 50MM SUB-SLAB.....20MM
8. ALL DRAWINGS MUST BE READ IN CONJUNCTION WITH RELEVANT ARCHITECTURAL AND ENGINEERING DRAWINGS RELATED TO THE SAME SHEET AND ANY ITEM ON IT(MD-216-2500-EG-CV-LAD-2001).

LEGENDS


F/FDN.-FOUNDATION
FFL-FINISH FLOOR LEVEL
FGL-FINISH GROUND LEVEL
VER-VERTICAL
GB-GRADE BEAM
BW's-BOTH WAYS
S.O.G-SLAB ON GRADE
TYP-TYPICAL
HOR.-HORIZONTAL
REINF.-REINFORCEMENT
LVL.-LEVEL
P.-PEDESTAL
W1-CONCRETE WALL 300mm THICK
STF- STRIP FOOTING

SCHEDULE OF FOOTINGS


FOOTING MARK	PLAIN CONCRETE			REINFORCED CONCRETE			BOTTOM REINFORCEMENT		TOP REINFORCEMENT		Ha	REMARKS
	L	W	T	L	W	T	SHORT BARS	LONG BARS	SHORT BARS	LONG BARS		
F1	2700	2700	50	2500	2500	500	ø12@150	ø12@150	ø12@150	ø12@150	1200	
STF	SEE PLAN		50	SEE PLAN		500	ø12@150	ø12@150	ø12@150	ø12@150	1200	

SCHEDULE OF GRADE BEAMS


BEAM MARK	DIMENSIONS		STEEL REINFORCEMENT				STIRRUPS
			BOTTOM		TOP		
	WIDTH	DEPTH	STRAIGHT	ADD.	STRAIGHT	ADD.	
GB1	300	750	3ø20	2ø20	3ø20	2ø20	PROVIDE ø10@150 AT END SPAN@DISTANCE OF L/3 FROM THE SUPPORT & ø10@200 AT MIDSPAN

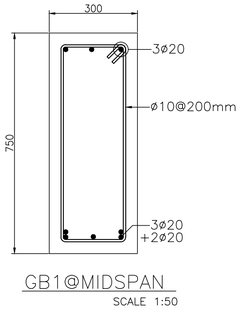

GB1@MIDSPAN
SCALE 1:50

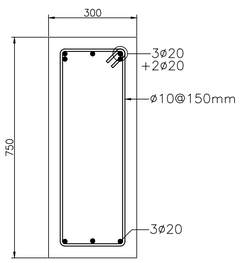

GB1@ENDSPAN
SCALE 1:50

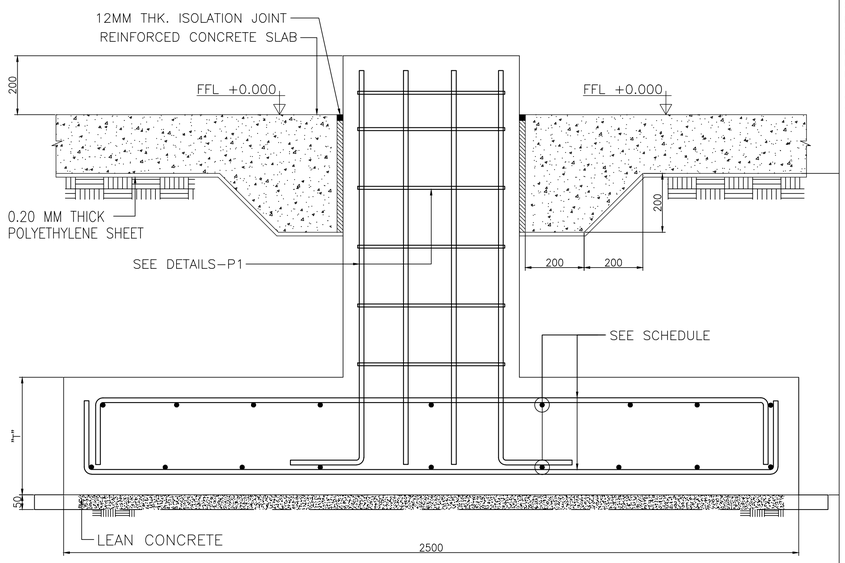

FOUNDATION SECTION X
SCALE 1:50

REVISION DESCRIPTION	DRN	CHK	ENG	APP	EMP	DATE	REV
AS-BUILT	--	SNM	--	SJM		13/06/2023	D01
ISSUED FOR CONSTRUCTION	--	SNM	--	SJM		07/12/2020	C01
REVISED AS PER EMPLOYER COMMENTS ON 26/08/2020	--	SNM	--	SJM		02/11/2020	A02
ISSUED FOR APPROVAL	--	SNM	--	SJM		01/08/2020	A01

DOCUMENT NUMBER	REFERENCE DOCUMENTS	REV
MD-216-6000-EG-CV-STD-1001	REINFORCEMENT STANDARD	A02
MD-216-2500-EG-CV-LAD-2001	GENERAL LAYOUT - EXPLOSIVE MAGAZINE	A01

ADVACON

LARSEN & TOUBRO
This drawing is the property of LARSEN & TOUBRO and must not be passed on to any person or body not authorized by us to receive it nor be copied or otherwise made use either in full or in part by such person or body without our prior permission in writing.

Outotec
The content of these documents are the sole property of Outotec Oy. Any rights not expressly granted herein are reserved. Reproduction, transfer or distribution of part or all of the contents in any form without prior written permission of Outotec is prohibited.

MA'ADEN معادن
Saudi Arabian Mining Company شركة معادن العربية السعودية
This document and the information contained herein is Ma'aden proprietary know-how. This document or any part thereof should not be reproduced, stored in a retrieval system or transmitted by any means, electronic or otherwise, or divulged without prior written permission of Ma'aden.

DRAWING NUMBER	MD-216-1800-EG-CV-DDE-1012	REVISION	C01
DATE / DRAWN	5/12/2020 / ABDUL	DATE / CHECKED	6/12/2020 / LARA
DATE / APPROVED	7/12/2020 / IHAB		

LARSEN & TOUBRO DRAWING NUMBER	019045_900_C_G_24451_001	REVISION 3
OUTOTEC DRAWING NUMBER	900707__GAU01__ZZ01__MTL01__25005	DOCUMENT ID OU100691785 / REVISION 3

DRAWN	--	--
CHECKED	SNM	31/07/2020
ENGINEER	--	--
APPROVED	SJM	01/08/2020
EMPLOYER		
SCALE	AS SHOW	A1

MANSOURAH - MASSARAH GOLD PROJECT
GENERAL ARRANGMENT
EXPLOSIVE MAGAZINE
PRILLS STORAGE FOUNDATION DETAILS

DRAWING NUMBER MD-216-2500-EG-CV-GAD-2001 REV D01