

DRAWING NUMBER: MD-216-2500-EG-CV-GAD-2006 | REV: D01

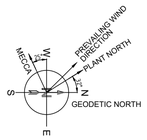

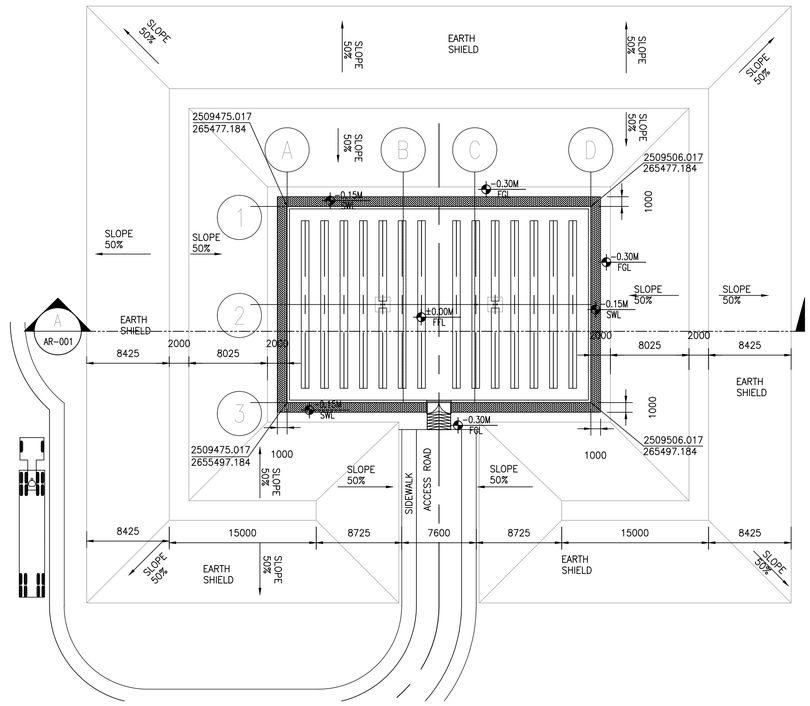



SITE PLAN — SCALE 1:300 — 1

LEGEND AND DESCRIPTION	
FGL	FINISH GRADE LEVEL
FFL	FINISH FLOOR LEVEL
SSL	STRUCTURE SLAB LEVEL
CMU	CONCRETE MASONARY UNIT
TOP	TOP OF PARAPET
CH	CEILING HEIGHT
TYP.	TYPICAL
SWL	SIDE WALK LEVEL


LEGEND AND DESCRIPTION	
LEGEND OF HATCHES	
FINISHES	SAMPLE
COMPACTED FILL	
INSULATED ROOF PANEL	
CONCRETE BEAM AND SLAB	
INTERLOCK PAVER SIDEWALK	

KEY PLAN

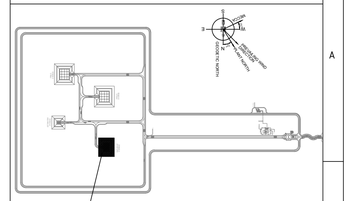

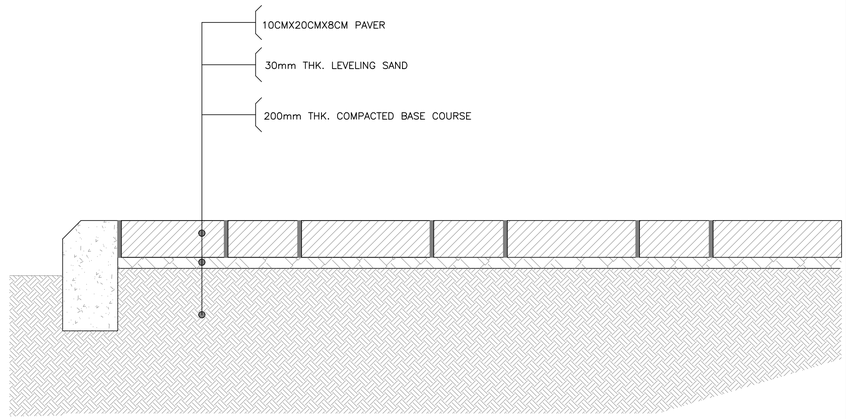

ENLARGED SECTION — SCALE 1:8 — 3

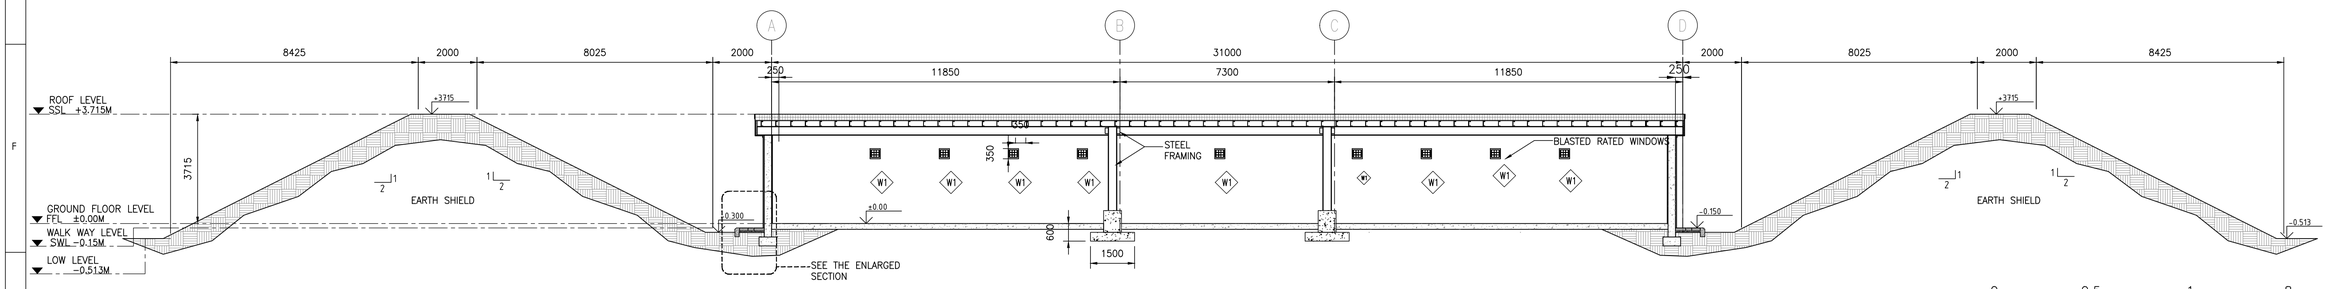

CROSS SECTION-A — SCALE 1:100 — 2

SCALE 1 : 8 — 0, 0.5, 1, 8 METERS

SCALE 1 : 100 — 0, 1, 2, 3, 4, 5, 6, 7, 8, 9, 10 METERS

SCALE 1 : 300 — 0, 5, 10, 20, 30 METERS

DOCUMENT NUMBER	REFERENCE DOCUMENTS	REV	DATE	REVISION DESCRIPTION	DRN	CHK	ENG	APP	EMP
		D01	13/06/2023	AS-BUILT	--	SNM	--	SJM	
		C01	04/01/2021	ISSUED FOR CONSTRUCTION	--	SNM	--	SJM	
MD-216-2500-EG-AR-LAD-2002	EXPLOSIVE STORAGE SITE PLAN VIEW	A01	01/08/2020	ISSUED FOR APPROVAL	--	SNM	--	SJM	

DVACON

DRAWING NUMBER: MD-216-1800-EG-CV-DDE-1017 | REVISION: A01

DATE	26/7/2020	DATE	26/7/2020	DATE	26/7/2020
DRAWN	ABDUL	CHECKED	LARA	APPROVED	IHAB

LARSEN & TOUBRO DRAWING NUMBER: 019045_900_C_G_24456_001 | REVISION: 2

OUTOTEC DRAWING NUMBER: 900707__GAU01__ZZ01__MTL01__25023 | DOCUMENT ID: OU100691803 | REVISION: 2

LARSEN & TOUBRO
This drawing is the property of LARSEN & TOUBRO and must not be passed on to any person or body not authorized by us to receive it nor be copied or otherwise made use either in full or in part by such person or body without our prior permission in writing.

Outotec
The content of these documents are the sole property of Outotec Oy). Any rights not expressly granted herein are reserved. Reproduction, transfer or distribution of part or all of the contents in any form without prior written permission of Outotec is prohibited.

MA'ADEN معادن
Saudi Arabian Mining Company شركة معادن العربية السعودية
This document and the information contained herein is Ma'aden proprietary know-how. This document or any part thereof should not be reproduced, stored in a retrieval system or transmitted by any means, electronic or otherwise, or divulged without prior written permission of Ma'aden.

DRAWN	--	--
CHECKED	SNM	31/07/2020
ENGINEER	--	--
APPROVED	SJM	01/08/2020
EMPLOYER		
SCALE	1:300	A1

MANSOURAH - MASSARAH GOLD PROJECT
GENERAL ARRANGMENT
EXPLOSIVE MAGAZINE
EXPLOSIVE STORAGE WALKWAY DETAIL

DRAWING NUMBER: MD-216-2500-EG-CV-GAD-2006 | REV: D01