


DRAWING NUMBER MD-216-2500-EG-CV-GAD-2007 REV D01

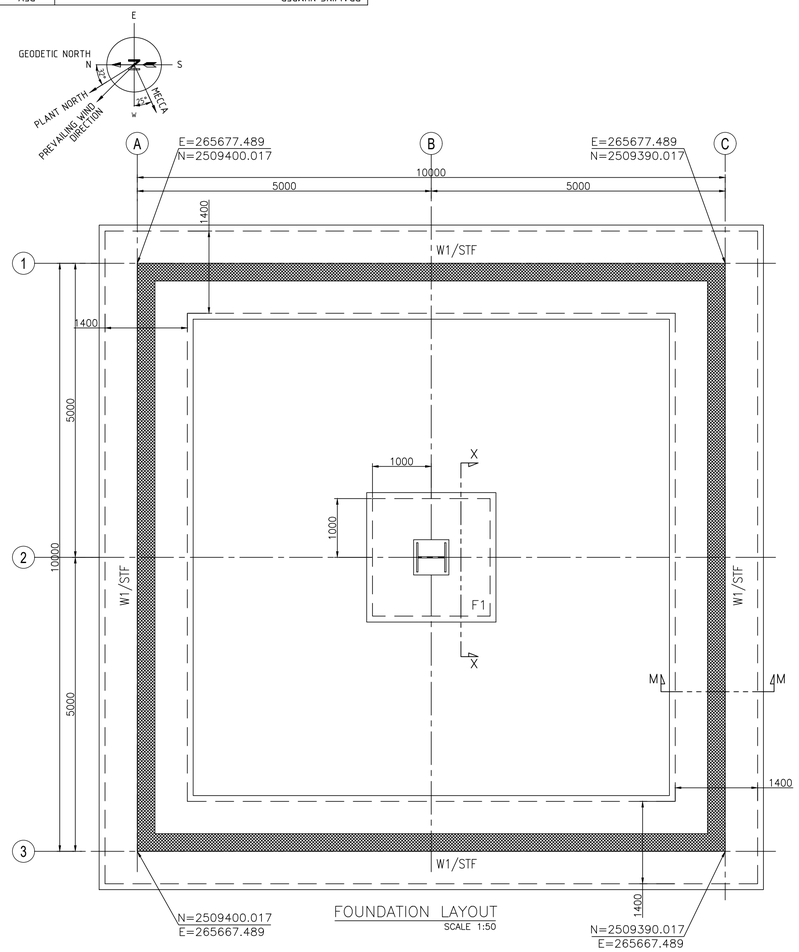


FOUNDATION LAYOUT
SCALE 1:50

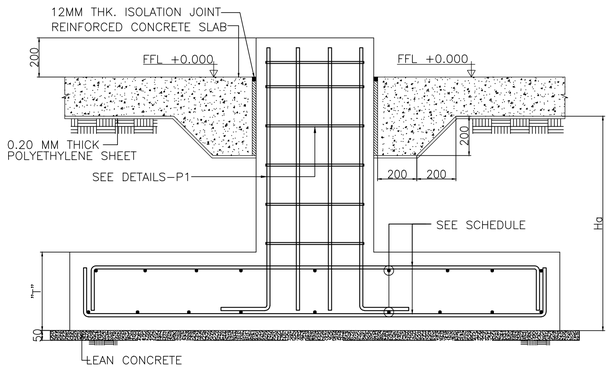

FOUNDATION SECTION-X
SCALE 1:75

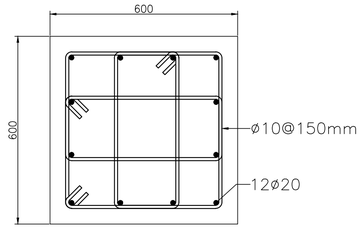


PEDESTAL DETAIL-P1
SCALE 1:50
(PROVIDE TOP '7' STIRRUPS @100mm C/C)

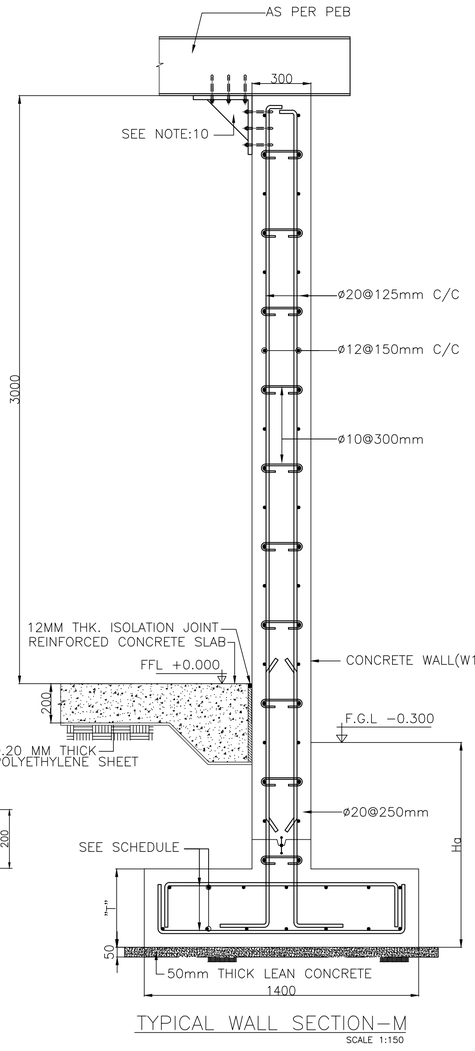


TYPICAL WALL SECTION-M
SCALE 1:150

SCHEDULE OF FOOTINGS

FOOTING MARK	PLAIN CONCRETE			REINFORCED CONCRETE			BOTTOM REINFORCEMENT		TOP REINFORCEMENT		Ha	REMARKS
	L	W	T	L	W	T	SHORT BARS	LONG BARS	SHORT BARS	LONG BARS		
F1	2200	2200	50	2000	2000	500	ø12@150	ø12@150	ø12@150	ø12@150	1200	
STF	SEE PLAN		50	SEE PLAN		500	ø12@150	ø12@150	ø12@150	ø12@150	1200	

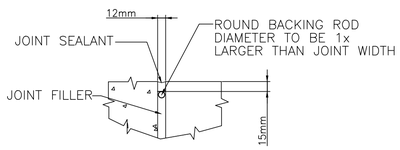


TYP JOINT SEAL DETAIL-C
SCALE 1:10

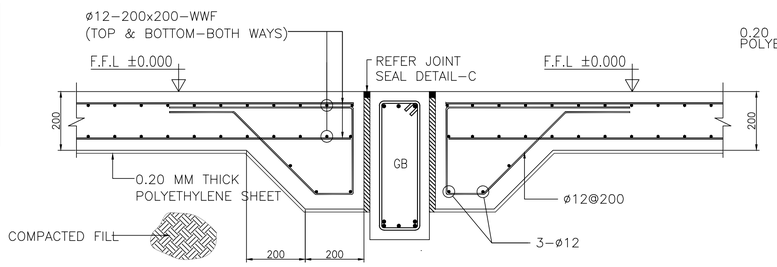

TYP SECTION FOR GRADE SLAB (A, SHT 002)
SCALE 1:50

KEY PLAN

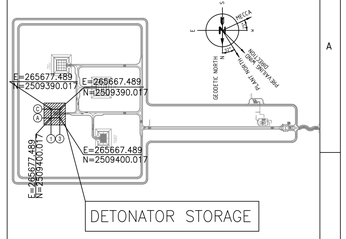

NOTES

1. ALL DIMENSIONS ARE GIVEN IN MILLIMETRES AND ELEVATIONS ARE IN METRES UNLESS OTHERWISE NOTED.
2. EL. (-) 0.300 CORRESPONDS TO RL.(+) 911.200 M (FGL)
3. MINIMUM REINFORCED CONCRETE GRADE TO BE USED FOR SUPERSTRUCTURE & SUBSTRUCTURES IS C35(5000 PSI).
4. MINIMUM LEAN CONCRETE GRADE TO BE USED FOR THE SUB-STRUCTURES IS C15(2175 PSI).
5. ALL REINFORCING STEEL SHALL BE DEFORMED BILLET STEEL BARS CONFORMING TO ASTM-A615, WITH MINIMUM YIELD STRENGTH OF FY420 MPA .
6. THE NET SOIL BEARING CAPACITY CONSIDERED IN FOUNDATION DESIGN IS 570 KPA(REFER DOC 216-3000-EG-CV-RPT-1008)
7. WATER PROOFING INSULATION SHALL BE AS PER PROJECT SPECIFICATIONS & ITS MATERIAL TO BE APPROVED BY SITE ENGINEER.
8. MINIMUM CONCRETE COVER AS PER SBC-304-2018(TABLE 20.6.1.3.1) MEASURED FROM REBAR SHALL BE
   a. CONCRETE CAST AGAINST & PERMANENTLY EXPOSED TO EARTH (INCLUDING FOUNDATIONS OVER SUB-SLAB) FORMED CONCRETE EXPOSED TO EARTH OR WEATHER.....50MM
   b. CONCRETE NOT EXPOSED TO WEATHER NOR IN CONTACT WITH GROUND
      BEAMS, COLUMNS.....40MM
      SLABS, WALLS, JOISTS.....20MM
   c. CONCRETE SLAB OVER 50MM SUB-SLAB.....20MM
9. ALL DRAWINGS MUST BE READ IN CONJUNCTION WITH RELEVANT ARCHITECTURAL AND ENGINEERING DRAWINGS RELATED TO THE SAME SHEET AND ANY ITEM ON IT(MD-216-2500-EG-CV-LAD-2001).
10. THE STEEL STRUCTURE DETAILS & MEMBER SIZES SHALL BE AS PER PEB VENDOR.BRACKET & CONNECTION DESIGN IS SUBJECT TO RECEVING REACTION FROM PES VENDOR.
11. ALL THE ROOF AND WALL OPENING SHALL BE FOLLOWED AS PER APPROVED ARCH. DRAWING.
12. All drawings are in compliance with HCIS-SAF-14 & NFPA-495 Standards

LEGENDS

F/FDN.-FOUNDATION
C/COL.-COLUMN
FFL-FINISH FLOOR LEVEL
FGL-FINISH GROUND LEVEL
VER-VERTICAL
GB-GRADE BEAM
S.O.G-SLAB ON GRADE
TYP-TYPICAL
HOR.-HORIZONTAL
REINF.-REINFORCEMENT
LVL.-LEVEL
RL.-REDUCED LEVEL
P.-PEDESTAL
℄ - CLINE OF COLUMN
DIA-DIAMETER

DOCUMENT NUMBER	REFERENCE DOCUMENTS	REV	DATE	REVISION DESCRIPTION	DRN	CHK	ENG	APP	EMP
		D01	13/06/2023	AS-BUILT	--	SNM	--	SJM	
MD-216-2500-EG-AR-GAD-2012	DETONATOR STORAGE ELEVATION VIEW	C02	06/05/2021	ISSUED FOR CONSTRUCTION & REVISED AS MKD (02)	--	SNM	--	SJM	
MD-216-2500-EG-AR-GAD-2011	DETONATOR STORAGE PLAN VIEW	C01	08/11/2020	ISSUED FOR CONSTRUCTION & REVISED AS MKD (01)	--	SNM	--	SJM	
MD-216-6000-EG-CV-STD-1001	REINFORCEMENT STANDARD	A02	08/10/2020	REVISED AS PER EMPLOYER COMMENTS ON 03/09/2020	--	SNM	--	SJM	
MD-216-2500-EG-CV-LAD-2001	GENERAL LAYOUT - EXPLOSIVE MAGAZINE	A01	01/08/2020	ISSUED FOR APPROVAL	--	SNM	--	SJM	

ADVACON

DRAWING NUMBER MD-216-1800-EG-CV-DDE-1018 | REVISION C02

DATE	03/28/2021	DATE	03/28/2021	DATE	03/28/2021
DRAWN	ABDUL	CHECKED	LARA	APPROVED	IHAB

LARSEN & TOUBRO DRAWING NUMBER 019045_900_C_G_24457_001 | REVISION 4

OUTOTEC DRAWING NUMBER 900707__GAU01__ZZ01__MTL01__25037 | DOCUMENT ID OU100691817 | REVISION 4

DRAWN	--	--
CHECKED	SNM	10/08/2020
ENGINEER	--	--
APPROVED	SJM	10/08/2020
EMPLOYER		
SCALE	AS SHOW	A1

MANSOURAH - MASSARAH GOLD PROJECT
GENERAL ARRANGEMENT
EXPLOSIVE MAGAZINE
DETONATOR STORAGE FOUNDATION DETAILS

DRAWING NUMBER MD-216-2500-EG-CV-GAD-2007 | REV D01

LARSEN & TOUBRO
This drawing is the property of LARSEN & TOUBRO and must not be passed on to any person or body not authorized by us to receive it nor be copied or otherwise made use either in full or in part by such person or body without our prior permission in writing.

Outotec
The content of these documents are the sole property of Outotec Oyj. Any rights not expressly granted herein are reserved. Reproduction, transfer or distribution of part or all of the contents in any form without prior written permission of Outotec is prohibited.

MA'ADEN معادن
Saudi Arabian Mining Company شركة المعادن العربية السعودية
This document and the information contained herein is Ma'aden proprietary know-how. This document or any part thereof should not be reproduced, stored in a retrieval system or transmitted by any means, electronic or otherwise, or divulged without prior written permission of Ma'aden.