

DRAWING NUMBER MD-216-2500-EG-CV-GAD-2012 REV D01

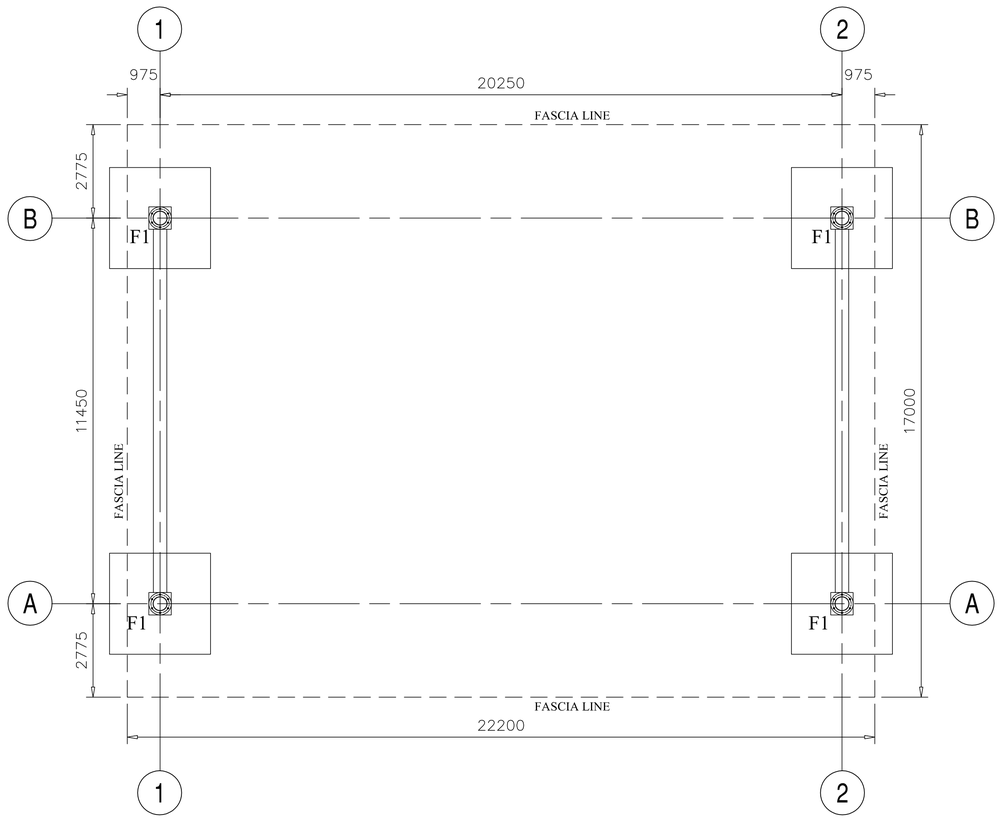


FOUNDATION LAYOUT PLAN
SCALE: 1:90

SCHEDULE OF FOOTING


MARK	REINF. CONCRETE (mm)			BOTTOM REINF.		TOP REINF.		REMARKS
	WIDTH	LENGTH	DEPTH	SHORT BARS	LONG BARS	SHORT BARS	LONG BARS	
F1	3000	3000	600	Ø18 @ 150 C/C	Ø18 @ 150 C/C	Ø14 @ 150 C/C	Ø14 @ 150 C/C	

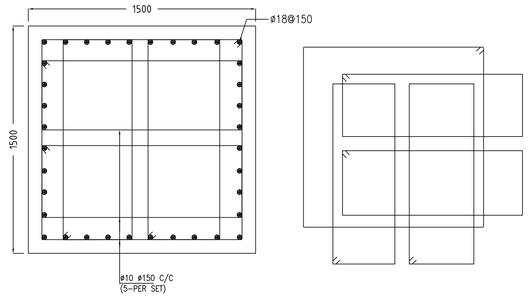

PEDESTAL SECTION DETAIL
SCALE:1:20

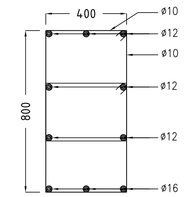


SECTION A-A
SCALE:1:15

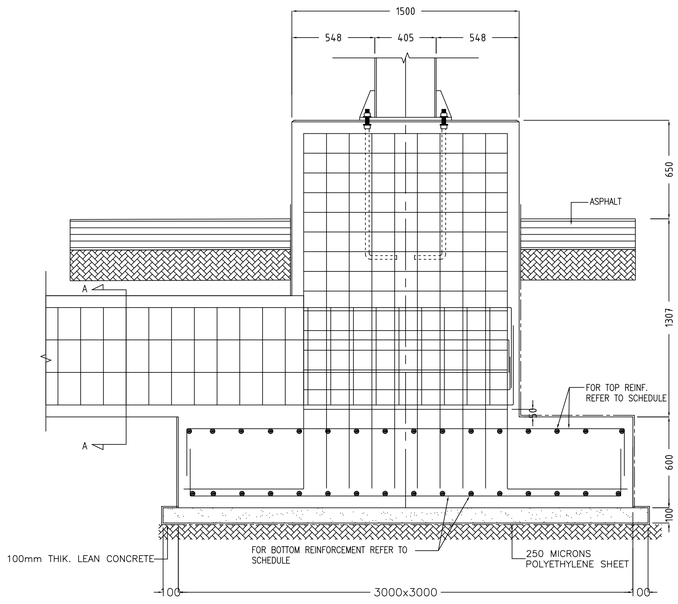


FOUNDATION SECTION
SCALE: 1:20

ANCHOR BOLT DETAILS

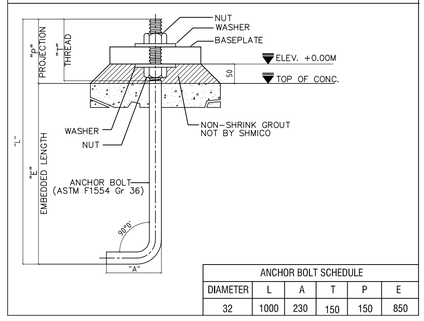

ANCHOR BOLT SCHEDULE					
DIAMETER	L	A	T	P	E
32	1000	230	150	150	850

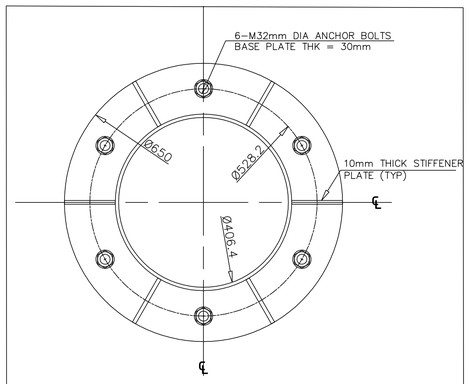

TYPICAL BASE PLATE DETAIL
SCALE: 1:5

LEGEND :-

U.N.O- UNLESS OTHERWISE NOTED
ELEV- ELEVATION
CONC- CONCRETE
Ø- DIAMETER
DIA- DIAMETER

NOTES:-

1. ALL WELDING WORKS SHALL BE REFERRED HEREWITH U. N. O.
2. THIS DRAWING SHOULD BE READ IN CONJUNCTION WITH OTHER DRAWINGS.
3. REFER TO WELD MAP (MD-216-1800-EG-AR-DLA-1012) FOR WELDING SCHEDULES.

DOCUMENT NUMBER	REFERENCE DOCUMENTS	REV	DATE	REVISION DESCRIPTION	DRN	CHK	ENG	APP	EMP
		D01	13/06/2023	AS-BUILT	--	SNM	--	SJM	
		C02	01/12/20210	ISSUED FOR CONSTRUCTION & REVISED AS MKD	--	SNM	--	SJM	
		C01	15/12/2020	ISSUED FOR CONSTRUCTION & REVISED AS MKD	--	SNM	--	SJM	
		A01	11/11/2020	ISSUED FOR APPROVAL	--	SNM	--	SJM	

DVACON

DRAWING NUMBER MD-216-1800-EG-CV-DDE-1021 REVISION C02

DRAWN	DATE	ABDUL	CHECKED	DATE	LARA	APPROVED	DATE	IHAB
	01/12/2021			01/12/2021			01/12/2021	

LARSEN & TOUBRO DRAWING NUMBER 019045_900_C_G_24462_001 REVISION 3

OUTOTEC DRAWING NUMBER 900707 __GAU01 __ZZ01 __MTL01 __25080 DOCUMENT ID OU100691860 REVISION 3

DRAWN	---	---
CHECKED	SNM	09/11/2020
ENGINEER	---	---
APPROVED	SJM	11/11/2020
EMPLOYER		
SCALE	AS SHOW	A1

MANSOURAH - MASSARAH GOLD PROJECT
GENERAL ARRANGMENT
EXPLOSIVE MAGAZINE
GUARDHOUSE SHADE FOUNDATION DETAILS

DRAWING NUMBER MD-216-2500-EG-CV-GAD-2012 REV D01

LARSEN & TOUBRO
This drawing is the property of *LARSEN & TOUBRO* and must not be passed on to any person or body not authorized by us to receive it nor be copied or otherwise made use either in full or in part by such person or body without our prior permission in writing.

Outotec
The content of these documents are the sole property of Outotec Oyj. Any rights not expressly granted herein are reserved. Reproduction, transfer or distribution of part or all of the contents in any form without prior written permission of Outotec is prohibited.

MA'ADEN معادن
Saudi Arabian Mining Company شركة معادن العربية السعودية
This document and the information contained herein is Ma'aden proprietary know-how. This document or any part thereof should not be reproduced, stored in a retrieval system or transmitted by any means, electronic or otherwise, or divulged without prior written permission of Ma'aden.