


DRAWING NUMBER MD-216-2500-EG-CV-GAD-2014 REV D01

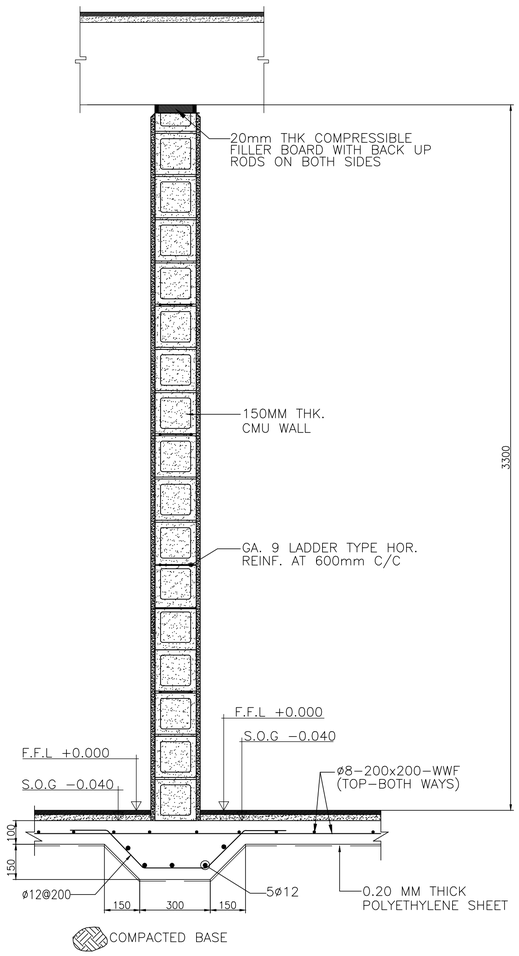


TYP INTERNAL WALL SECTION-D
SCALE 1:50

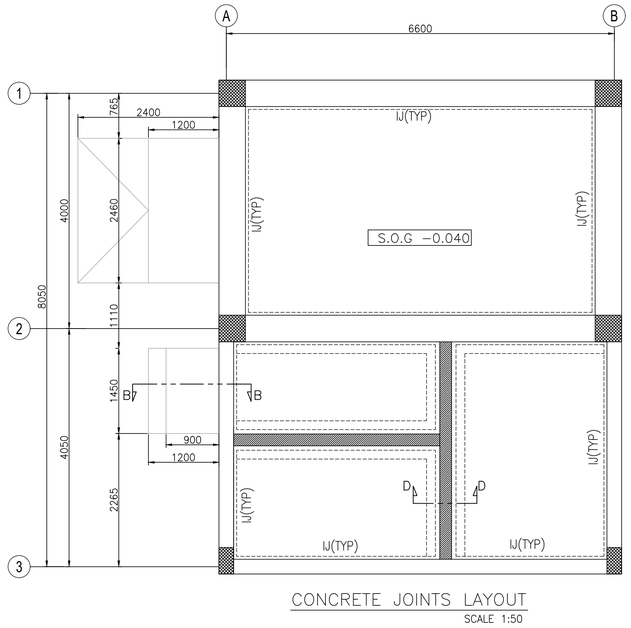


CONCRETE JOINTS LAYOUT
SCALE 1:50

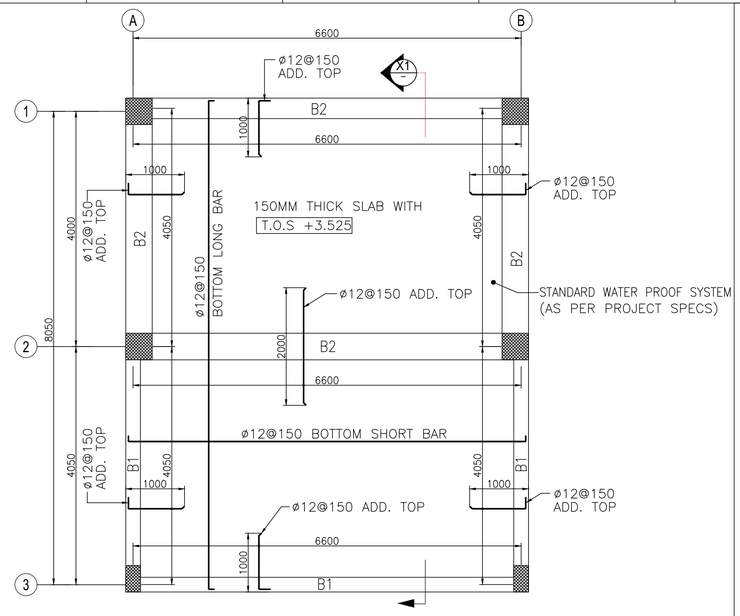


ROOF FRAMING PLAN
SCALE 1:50

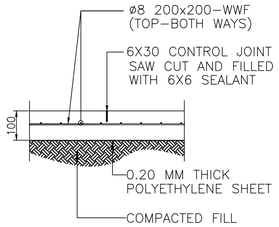


TYPICAL CONTROL JOINT DETAIL
SCALE 1:50

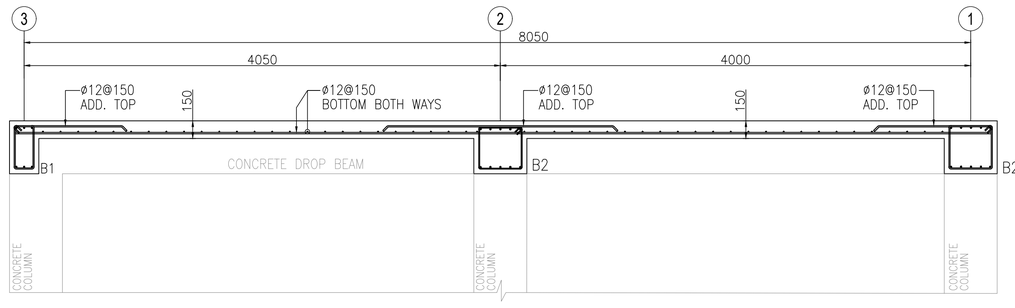

TYPICAL SLAB SECTION DETAILS-X1
SCALE 1:25

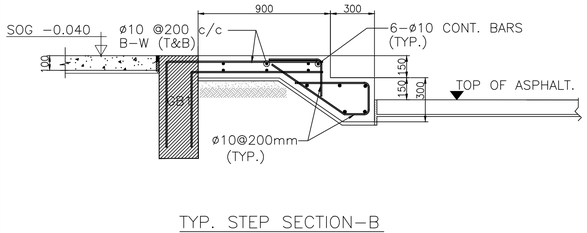

TYP. STEP SECTION-B
SCALE 1:20

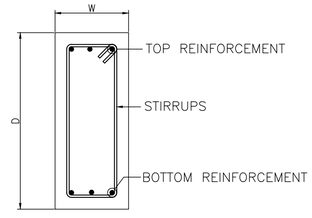

TYPICAL BEAM DETAIL
SCALE 1:50

BEAM MARK	DIMENSIONS		STEEL REINFORCEMENT				STIRRUPS	REMARKS
			TOP		BOTTOM			
	WIDTH	DEPTH	STRAIGHT	ADD.	STRAIGHT	ADD.		
B1	250	450	3ø16	–	3ø16	–	PROVIDE ø10@125 IN END SPAN & ø10@150 IN THE MID SPAN	
B2	450	450	5ø16	–	5ø16	–	PROVIDE ø10@125 BOTH IN END SPAN & MID SPAN	

LEGENDS:-

F/FDN.-FOUNDATION
CR-COLUMN NECK
C/COL.-COLUMN
FFL-FINISH FLOOR LEVEL
FGL-FINISH GROUND LEVEL
VER-VERTICAL
WWF-WELDED WIRE FABRIC
HCS-HOLLOW CORE SLAB
GB-GRADE BEAM
IJ-ISOLATION JOINT
CJ-CONTROL JOINT
BW's-BOTH WAYS
S.O.G-SLAB ON GRADE
TYP.-TYPICAL
HOR.-HORIZONTAL
REINF.-REINFORCEMENT
LVL.-LEVEL
RL.-REDUCED LEVEL
P.-PEDESTAL
℄ - CENTRE LINE OF COLUMN
T.O.S-TOP OF SCREED
DIA-DIAMETER
ø-DIAMETER

NOTES:-

1. ALL DIMENSIONS ARE GIVEN IN MILLIMETRES AND ELEVATIONS ARE IN METRES UNLESS OTHERWISE NOTED.
2. MINIMUM REINFORCED CONCRETE GRADE TO BE USED FOR SUPERSTRUCTURE & SUBSTRUCTURES IS C35(5000 PSI).
3. MINIMUM LEAN CONCRETE GRADE TO BE USED FOR THE SUB-STRUCTURES IS C15(2175 PSI).
4. ALL REINFORCING STEEL SHALL BE DEFORMED BILLET STEEL BARS CONFORMING TO ASTM-A615, WITH MINIMUM YIELD STRENGTH OF FY420 MPA .
5. THE NET SOIL BEARING CAPACITY CONSIDERED IN FOUNDATION DESIGN IS 570 KPA(REFER DOC 216-3000-EG-CV-RPT-1008)
6. WATER PROOFING INSULATION SHALL BE AS PER PROJECT SPECIFICATIONS & ITS MATERIAL TO BE APPROVED BY SITE ENGINEER.
7. MINIMUM CONCRETE COVER AS PER SBC-304-2018(TABLE 20.6.1.3.1) MEASURED FROM REBAR SHALL BE
   a. CONCRETE CAST AGAINST & PERMANENTLY EXPOSED TO EARTH (INCLUDING FOUNDATIONS OVER SUB-SLAB) FORMED CONCRETE EXPOSED TO EARTH OR WEATHER.....50MM
   b. CONCRETE NOT EXPOSED TO WEATHER NOR IN CONTACT WITH GROUND
      BEAMS, COLUMNS.....40MM
      SLABS, WALLS, JOISTS.....20MM
   c. CONCRETE SLAB OVER 50MM SUB-SLAB.....20MM
8. ALL DRAWINGS MUST BE READ IN CONJUNCTION WITH RELEVANT ARCHITECTURAL AND ENGINEERING DRAWINGS RELATED TO THE SAME SHEET AND ANY ITEM ON IT(MD-216-2500-EG-CV-LAD-2001).
9. THIS DESIGN FOLLOWS THE APPROVED PROJECT DESIGN CRITERIA.

DOCUMENT NUMBER	REFERENCE DOCUMENTS	REV	DATE	REVISION DESCRIPTION	DRN	CHK	ENG	APP	EMP
		D01	13/06/2023	AS-BUILT	--	SNM	--	SJM	
		C02	29/07/2021	ISSUED FOR CONSTRUCTION & REVISED AS MKD. C02	--	SNM	--	SJM	
MD-216-6000-EG-CV-STD-1002	HOLLOW CORE SLAB STANDARD	C01	04/01/2021	ISSUED FOR CONSTRUCTION AND REVISED AS PER EMPLOYER	--	SNM	--	SJM	
MD-216-6000-EG-CV-STD-1001	REINFORCEMENT STANDARD			COMMENTS ON 09/12/2020 & REVISED AS MKD. C01	--	SNM	--	SJM	
MD-216-2500-EG-CV-LAD-2001	GENERAL LAYOUT - EXPLOSIVE MAGAZINE	A01	11/11/2020	ISSUED FOR APPROVAL	--	SNM	--	SJM	

DVACON

LARSEN & TOUBRO

This drawing is the property of *LARSEN & TOUBRO* and must not be passed on to any person or body not authorized by us to receive it nor be copied or otherwise made use either in full or in part by such person or body without our prior permission in writing.

Outotec

The content of these documents are the sole property of Outotec Oyj. Any rights not expressly granted herein are reserved. Reproduction, transfer or distribution of part or all of the contents in any form without prior written permission of Outotec is prohibited.

MA'ADEN معادن
Saudi Arabian Mining Company شركة المعادن العربية السعودية

This document and the information contained herein is Ma'aden proprietary know-how. This document or any part thereof should not be reproduced, stored in a retrieval system or transmitted by any means, electronic or otherwise, or divulged without prior written permission of Ma'aden.

LARSEN & TOUBRO DRAWING NUMBER	O19045_900_C_G_24464_001	REVISION 3
OUTOTEC DRAWING NUMBER	900707__GAU01__ZZ01__MTL01__25084	DOCUMENT ID OU100691864 / REVISION 3

DRAWN	--	--
CHECKED	SNM	09/11/2020
ENGINEER	--	--
APPROVED	SJM	11/11/2020
EMPLOYER		
SCALE	AS SHOW	A1

MANSOURAH - MASSARAH GOLD PROJECT
GENERAL ARRANGMENT
EXPLOSIVE MAGAZINE
SUPPORT FACILITY BUILDING FOUNDATION DETAIL. & ROOF SLAB

DRAWING NUMBER MD-216-2500-EG-CV-GAD-2014 REV D01