

DRAWING NUMBER MD-216-2500-EG-CV-GAD-2015 REV D01

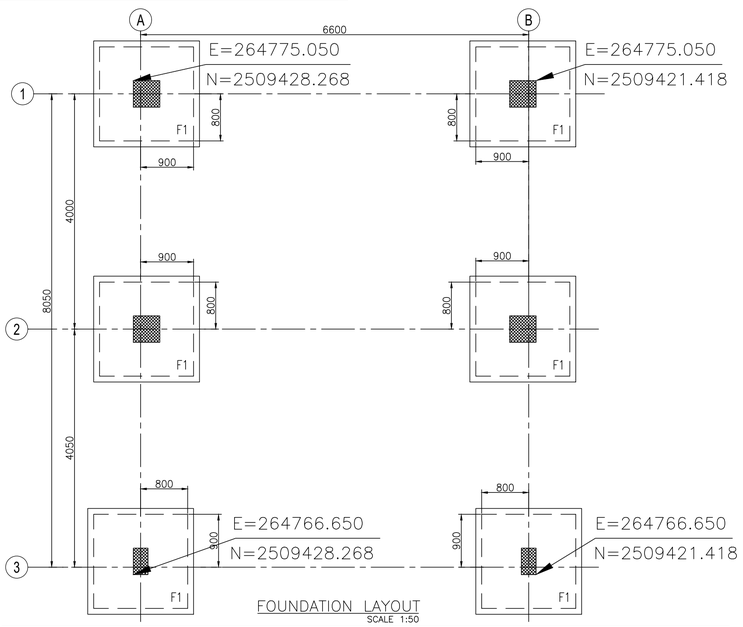


FOUNDATION LAYOUT
SCALE 1:50

FOOTING MARK	PLAIN CONCRETE			REINFORCED CONCRETE			BOTTOM REINFORCEMENT		TOP REINFORCEMENT		Ha	REMARKS
	L	W	T	L	W	T	SHORT BARS	LONG BARS	SHORT BARS	LONG BARS		
F1	1800	1800	50	1600	1600	300	ø12@200	ø12@200	–	–	1200	

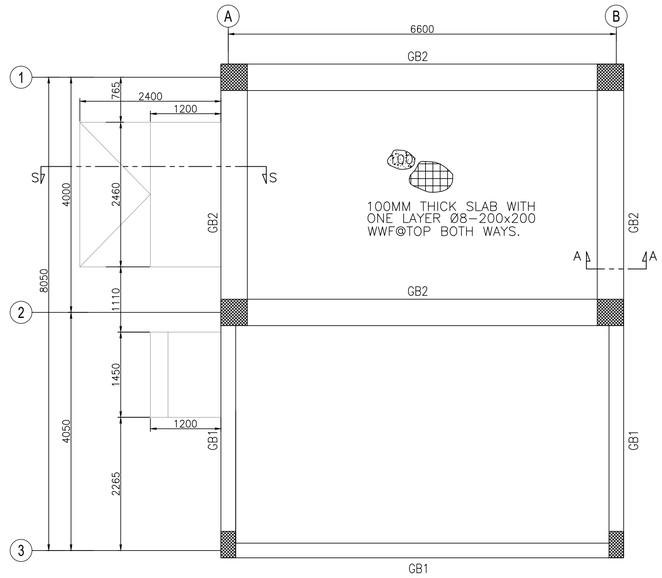


GRADE BEAM LAYOUT
SCALE 1:50

BEAM MARK	DIMENSIONS		STEEL REINFORCEMENT				SIDE BAR EACH FACE	STIRRUPS
			BOTTOM		TOP			
	WIDTH	DEPTH	STRAIGHT	ADD.	STRAIGHT	ADD.		
GB1	250	600	3ø20	–	3ø20	–	–	PROVIDE ø10@150 AT END SPAN@DISTANCE OF L/3 FROM THE SUPPORT & ø10@200 AT MIDSPAN
GB2	450	600	3ø20	–	3ø20	–	–	

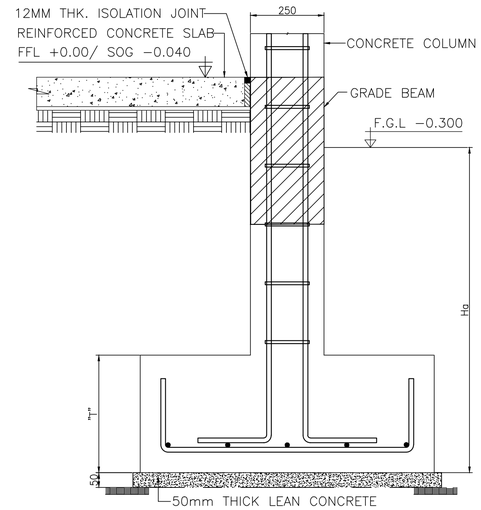


FOUNDATION SECTION
SCALE 1:50

KEY PLAN

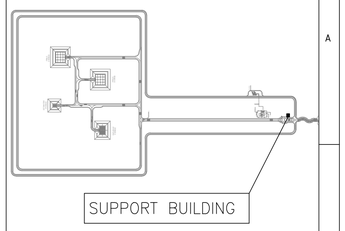


LEGENDS:–


F/FDN.–FOUNDATION
CR–COLUMN NECK
C/COL.–COLUMN
FFL–FINISH FLOOR LEVEL
FGL–FINISH GROUND LEVEL
VER–VERTICAL
WWF–WELDED WIRE FABRIC
HCS–HOLLOW CORE SLAB
GB–GRADE BEAM
IJ–ISOLATION JOINT
CJ–CONTROL JOINT
BW's–BOTH WAYS
S.O.G–SLAB ON GRADE
TYP–TYPICAL
HOR.–HORIZONTAL
REINF.–REINFORCEMENT
LVL.–LEVEL
RL–REDUCED LEVEL
P.–PEDESTAL
– CENTER LINE
EF. – EACH FACE
ØA–DIAMETER
ø–DIAMETER

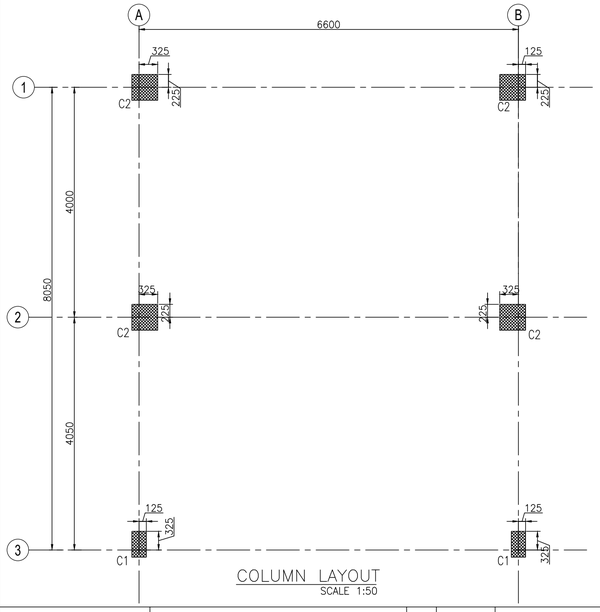

COLUMN LAYOUT
SCALE 1:50

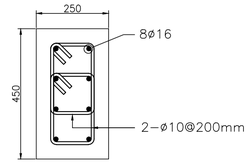

COLUMN DETAIL (C1)
SCALE 1:40

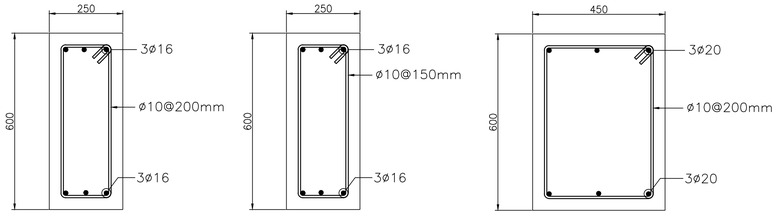


GB1 @MID SPAN
SCALE 1:50


GB1 @END SPAN
SCALE 1:50

GB2 @MID SPAN
SCALE 1:50


GB2 @END SPAN
SCALE 1:50

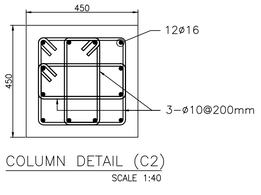

COLUMN DETAIL (C2)
SCALE 1:40

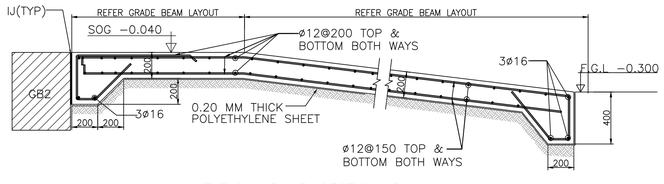

TYPICAL RAMP SECTION–S
SCALE 1:20

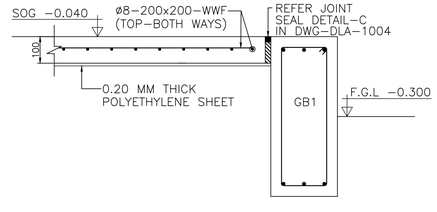

TYP SECTION (A) FOR GRADE SLAB
SCALE 1:50

NOTES:–

1. ALL DIMENSIONS ARE GIVEN IN MILLIMETRES AND ELEVATIONS ARE IN METRES UNLESS OTHERWISE NOTED.
2. MINIMUM REINFORCED CONCRETE GRADE TO BE USED FOR SUPERSTRUCTURE & SUBSTRUCTURES IS C35(5000 PSI).
3. MINIMUM LEAN CONCRETE GRADE TO BE USED FOR THE SUB–STRUCTURES IS C15(2175 PSI).
4. ALL REINFORCING STEEL SHALL BE DEFORMED BILLET STEEL BARS CONFORMING TO ASTM–A615, WITH MINIMUM YIELD STRENGTH OF FY420 MPA .
5. THE NET SOIL BEARING CAPACITY CONSIDERED IN FOUNDATION DESIGN IS 570 KPA(REFER DOC 216–3000–EG–CV–RPT–1008)
6. WATER PROOFING INSULATION SHALL BE AS PER PROJECT SPECIFICATIONS & ITS MATERIAL TO BE APPROVED BY SITE ENGINEER.
7. MINIMUM CONCRETE COVER AS PER SBC–304–2018(TABLE 20.6.1.3.1) MEASURED FROM REBAR SHALL BE
   a. CONCRETE CAST AGAINST & PERMANENTLY EXPOSED TO EARTH (INCLUDING FOUNDATIONS OVER SUB–SLAB) FORMED CONCRETE EXPOSED TO EARTH OR WEATHER.....50MM
   b. CONCRETE NOT EXPOSED TO WEATHER NOR IN CONTACT WITH GROUND
      BEAMS, COLUMNS.....40MM
      SLABS, WALLS, JOISTS.....20MM
   c. CONCRETE SLAB OVER 50MM SUB–SLAB.....20MM
8. ALL DRAWINGS MUST BE READ IN CONJUNCTION WITH RELEVANT ARCHITECTURAL AND ENGINEERING DRAWINGS RELATED TO THE SAME SHEET AND ANY ITEM ON IT(MD–216–2500–EG–CV–LAD–2001).
9. EL. (–) 0.300 CORRESPONDS TO RL.(+) 914.287 M (FGL)

DOCUMENT NUMBER	REFERENCE DOCUMENTS	REV	DATE	REVISION DESCRIPTION	DRN	CHK	ENG	APP	EMP
		D01	13/06/2023	AS-BUILT	––	SNM	––	SJM	
MD-216-6000-EG-CV-STD-1002	HOLLOW CORE SLAB STANDARD	C02	03/28/2021	ISSUED FOR CONSTRUCTION & REVISED AS MKD	––	SNM	––	SJM	
MD-216-6000-EG-CV-STD-1001	REINFORCEMENT STANDARD	C01	15/12/2020	ISSUED FOR CONSTRUCTION & REVISED AS MKD	––	SNM	––	SJM	
MD-216-2500-EG-CV-LAD-2001	GENERAL LAYOUT - EXPLOSIVE MAGAZINE	A01	11/11/2020	ISSUED FOR APPROVAL	--	SNM	--	SJM	

ADVACON

LARSEN & TOUBRO

This drawing is the property of *LARSEN & TOUBRO* and must not be passed on to any person or body not authorized by us to receive it nor be copied or otherwise made use either in full or in part by such person or body without our prior permission in writing.

Outotec

The content of these documents are the sole property of Outotec Oyj. Any rights not expressly granted herein are reserved. Reproduction, transfer or distribution of part or all of the contents in any form without prior written permission of Outotec is prohibited.

MA'ADEN معادن
Saudi Arabian Mining Company شركة المعادن العربية السعودية

This document and the information contained herein is Ma'aden proprietary know-how. This document or any part thereof should not be reproduced, stored in a retrieval system or transmitted by any means, electronic or otherwise, or divulged without prior written permission of Ma'aden.

DRAWING NUMBER					REVISION
MD-216-1800-EG-CV-DLA-1015					C02
DATE	03/28/2021	DATE	03/28/2021	DATE	03/28/2021
DRAWN	ABDUL	CHECKED	LARA	APPROVED	IHAB

LARSEN & TOUBRO DRAWING NUMBER	REVISION
019045_900_C_G_24465_001	3
OUTOTEC DRAWING NUMBER: 900707 _GAU01 _ZZ01 _MTL01 _25085	DOCUMENT ID: OU100691865 / REVISION: 3

DRAWN	--	--
CHECKED	SNM	03/28/2021
ENGINEER	--	--
APPROVED	SJM	03/28/2021
EMPLOYER		
SCALE	AS SHOW	A1

MANSOURAH - MASSARAH GOLD PROJECT
GENERAL ARRANGMENT
EXPLOSIVE MAGAZINE
SUPPORT FACILITY BUILDING ROOF DETAIL.

DRAWING NUMBER: MD-216-2500-EG-CV-GAD-2015 REV: D01