


DRAWING NUMBER: MD-216-2500-EG-CV-GAD-2020 | REV: D01

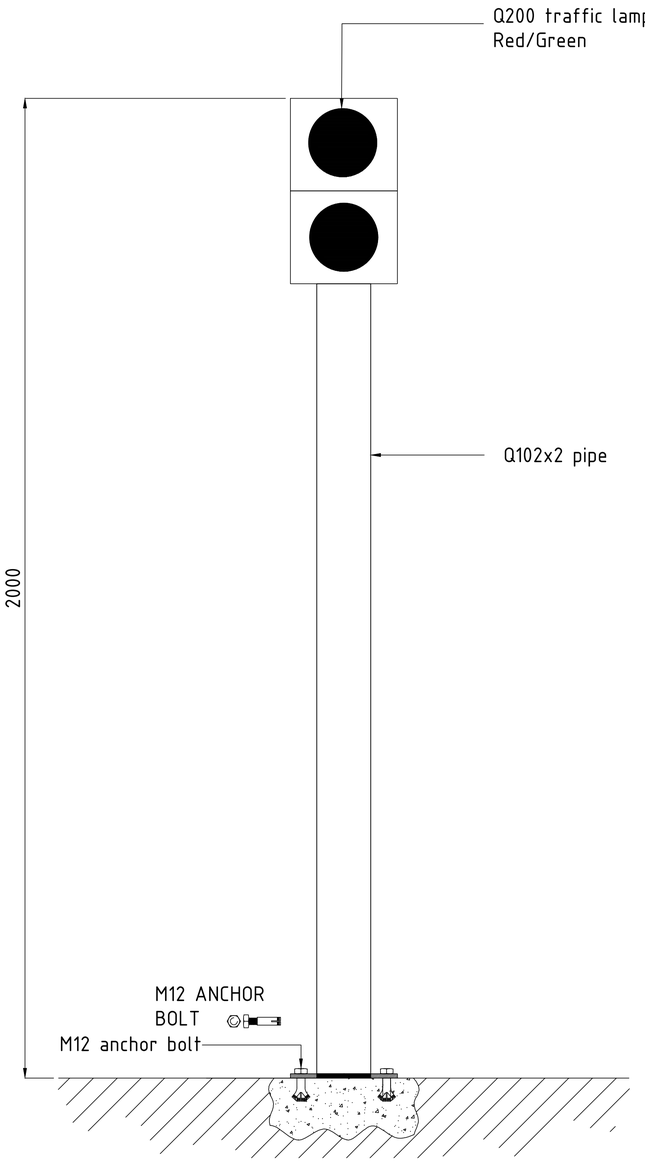

FRONT VIEW

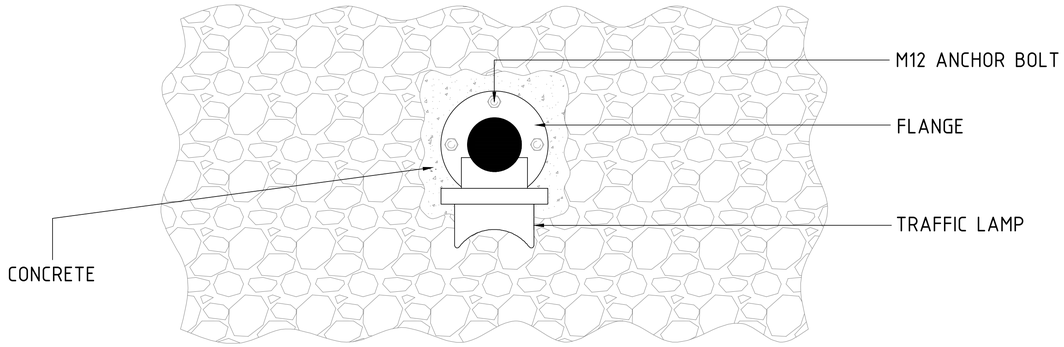

TOP VIEW

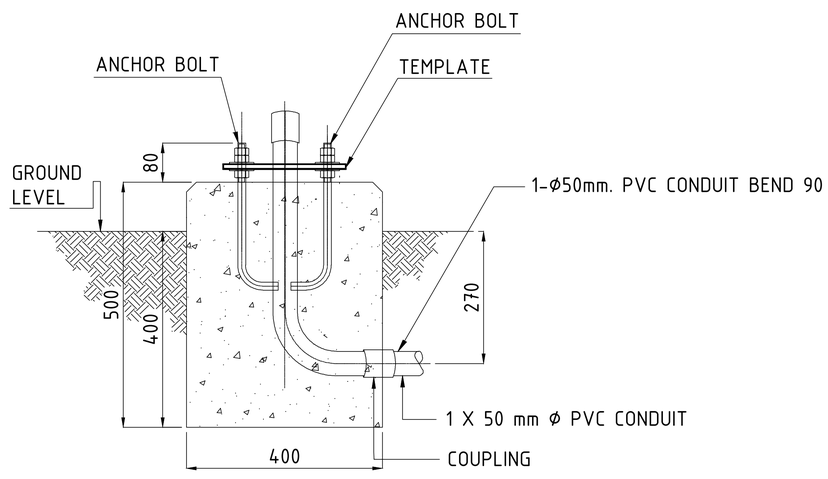

POLE FOUNDATION ELEVATION VIEW

NOTES

1. ALL DIMENSIONS ARE IN MILLIMETERS UNLESS OTHERWISE NOTED.

DOCUMENT NUMBER	REFERENCE DOCUMENTS	REV	DATE	REVISION DESCRIPTION	DRN	CHK	ENG	APP	EMP
		D01	13/06/2023	AS-BUILT	--	SNM	--	SJM	
		C01	29/12/2020	ISSUED FOR CONSTRUCTION	--	SNM	--	SJM	
		A01	12/11/2020	ISSUED FOR APPROVAL	--	SNM	--	SJM	

ADVACON

LARSEN & TOUBRO

This drawing is the property of *LARSEN & TOUBRO* and must not be passed on to any person or body not authorized by us to receive it nor be copied or otherwise made use either in full or in part by such person or body without our prior permission in writing.

Outotec

The content of these documents are the sole property of Outotec Oyj. Any rights not expressly granted herein are reserved. Reproduction, transfer or distribution of part or all of the contents in any form without prior written permission of Outotec is prohibited.

MA'ADEN معادن
Saudi Arabian Mining Company شركة معادن العربية السعودية

This document and the information contained herein is Ma'aden proprietary know-how. This document or any part thereof should not be reproduced, stored in a retrieval system or transmitted by any means, electronic or otherwise, or divulged without prior written permission of Ma'aden.

DRAWN	DATE 26/12/2020	DATE 27/12/2020	DATE 28/12/2020
	ABDUL	LARA	IHAB
CHECKED		APPROVED	

DRAWING NUMBER: MD-216-1800-EG-CV-DDE-1005 | REVISION: C01

LARSEN & TOUBRO DRAWING NUMBER: O19045_900_C_G_24470_001 | REVISION: 2

OUTOTEC DRAWING NUMBER: 900707__GAU01__ZZ01__MTL01__25058 | DOCUMENT ID: OU100691838 | REVISION: 2

DRAWN	-	---	MANSOURAH - MASSARAH GOLD PROJECT
CHECKED	SNM	10/11/2020	GENERAL ARRANGMENT
ENGINEER	---	---	EXPLOSIVE MAGAZINE
APPROVED	SJM	12/11/2020	TRAFFIC LIGHT FOUNDATION DETAILS
EMPLOYER			
SCALE	1:6	A1	

DRAWING NUMBER: MD-216-2500-EG-CV-GAD-2020 | REV: D01