


DRAWING NUMBER MD-216-2500-EG-CV-GAD-2026 REV D01

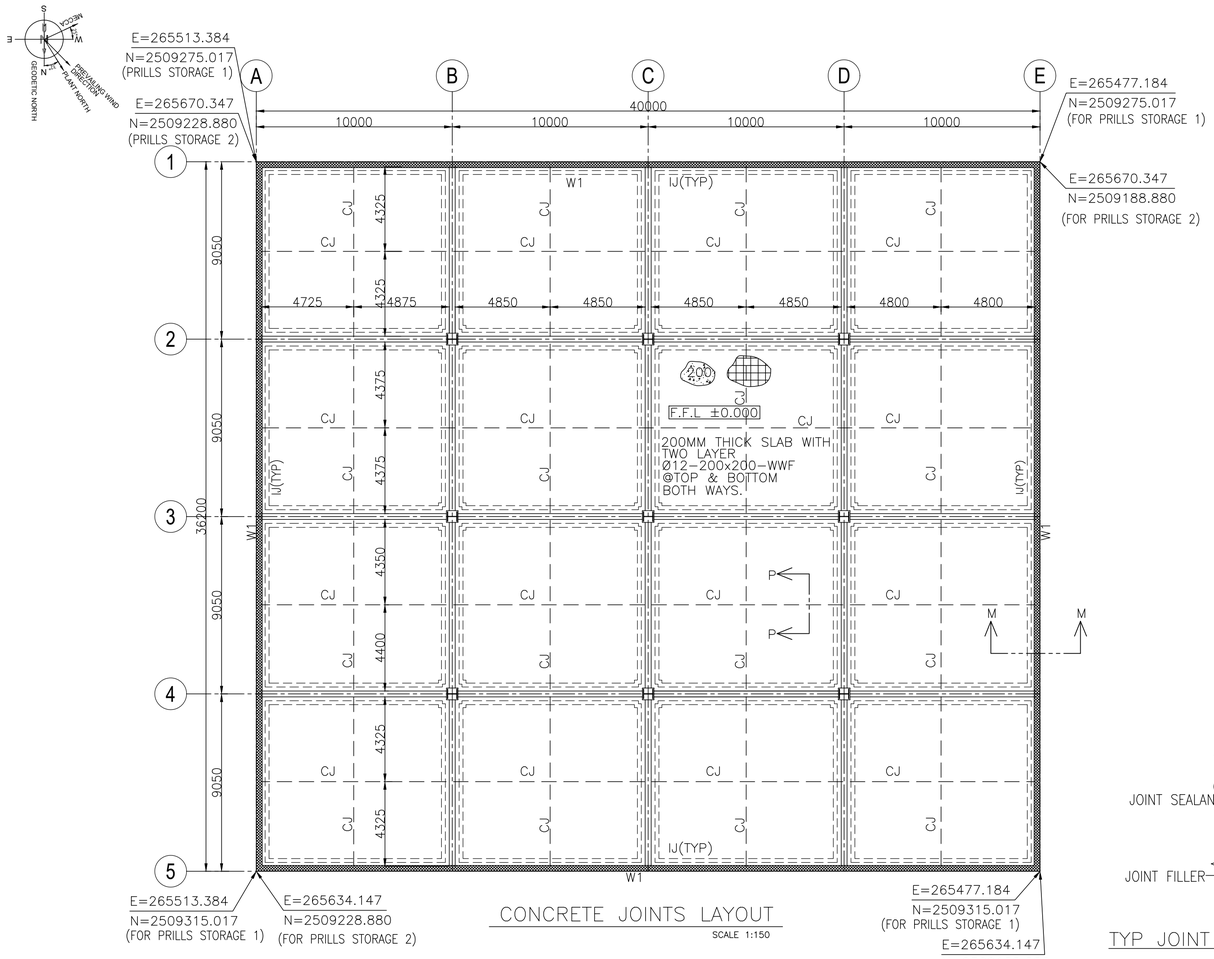

CONCRETE JOINTS LAYOUT
SCALE 1:150

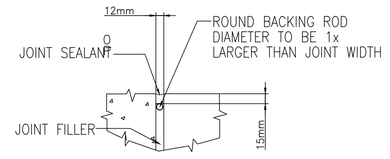


TYP JOINT SEAL DETAIL-C
SCALE 1:50

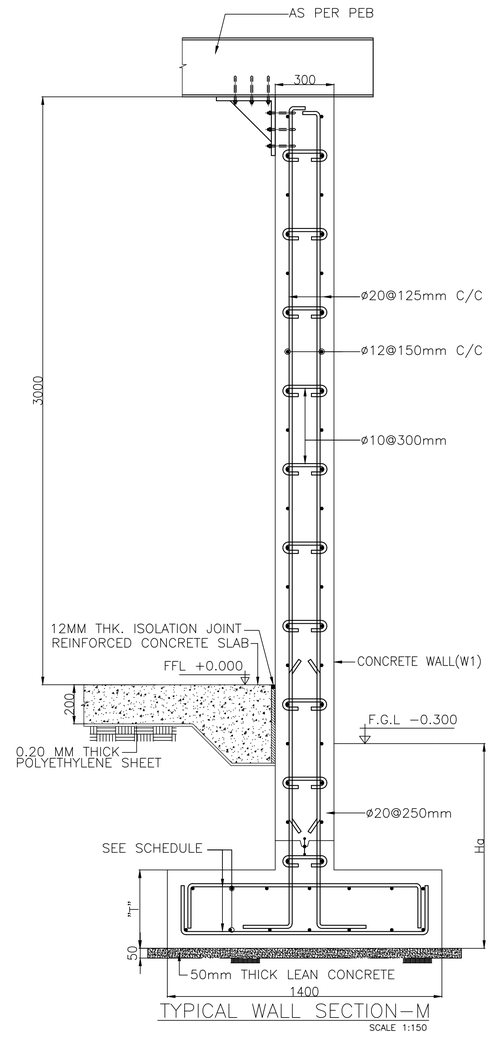


TYPICAL WALL SECTION-M
SCALE 1:150


NOTE: CONTROL JOINTS SHALL BE PROVIDED AT MAX SPACING OF 20 FT (6.10 M) AS PER ACI CODE

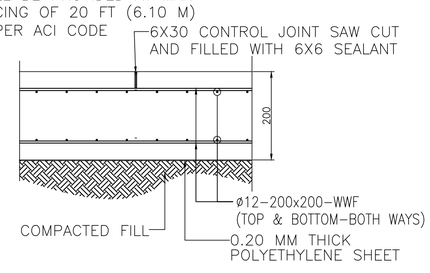

TYP CONTROL JOINT(CJ)SECTION-P
SCALE 1:50

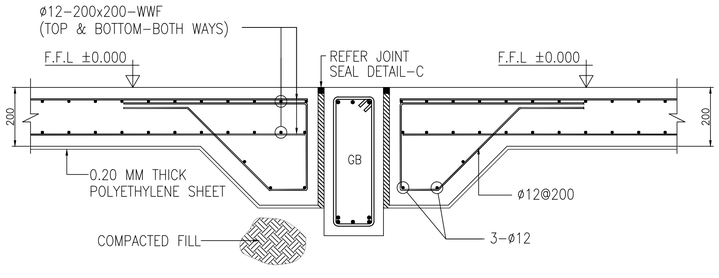


TYP SECTION FOR GRADE SLAB A SHT 001
SCALE 1:50

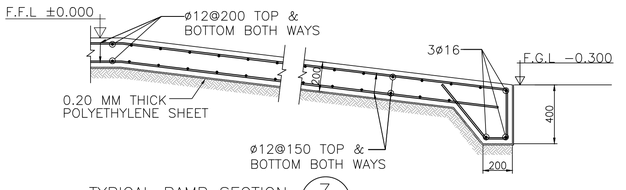

TYPICAL RAMP SECTION Z SHT 001
SCALE 1:50

KEY PLAN

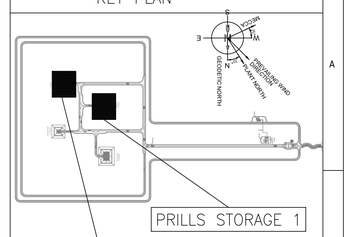

NOTES

1. ALL DIMENSIONS ARE GIVEN IN MILLIMETRES AND ELEVATIONS ARE IN METRES UNLESS OTHERWISE NOTED.
2. EL. (-) 0.300 CORRESPONDS TO RL.(+) 913.100 M (FGL) FOR PRILLS STORAGE 1 & EL. (-) 0.300 CORRESPONDS TO RL.(+) 911.800 M (FGL) FOR PRILLS STORAGE 2.
3. MINIMUM REINFORCED CONCRETE GRADE TO BE USED FOR SUPERSTRUCTURE & SUBSTRUCTURES IS C35(5000 PSI).
4. MINIMUM LEAN CONCRETE GRADE TO BE USED FOR THE SUB-STRUCTURES IS C15(2175 PSI).
5. ALL REINFORCING STEEL SHALL BE DEFORMED BILLET STEEL BARS CONFORMING TO ASTM-A615, WITH MINIMUM YIELD STRENGTH OF FY420 MPA .
6. THE NET SOIL BEARING CAPACITY CONSIDERED IN FOUNDATION DESIGN IS 570 KPA(REFER DOC 216-3000-EG-CV-RPT-1008)
7. WATER PROOFING INSULATION SHALL BE AS PER PROJECT SPECIFICATIONS & ITS MATERIAL TO BE APPROVED BY SITE ENGINEER.
8. MINIMUM CONCRETE COVER AS PER SBC-304-2018(TABLE 20.6.1.3.1) MEASURED FROM REBAR SHALL BE
   a. CONCRETE CAST AGAINST & PERMANENTLY EXPOSED TO EARTH (INCLUDING FOUNDATIONS OVER SUB-SLAB) FORMED CONCRETE EXPOSED TO EARTH OR WEATHER.....50MM
   b. CONCRETE NOT EXPOSED TO WEATHER NOR IN CONTACT WITH GROUND
      BEAMS, COLUMNS.....40MM
      SLABS, WALLS, JOISTS.....20MM
   c. CONCRETE SLAB OVER 50MM SUB-SLAB.....20MM
9. ALL DRAWINGS MUST BE READ IN CONJUNCTION WITH RELEVANT ARCHITECTURAL AND ENGINEERING DRAWINGS RELATED TO THE SAME SHEET AND ANY ITEM ON IT(MD-216-2500-EG-CV-LAD-2001).
10. THE STEEL STRUCTURE DETAILS & MEMBER SIZES SHALL BE AS PER PEB VENDOR.BRACKET & CONNECTION DESIGN IS SUBJECT TO RECEVING REACTION FROM PES VENDOR.

LEGENDS

F/FDN.-FOUNDATION
W1-CONCRETE WALL 300mm THICK
FFL-FINISH FLOOR LEVEL
FGL-FINISH GROUND LEVEL
VER-VERTICAL
WWF-WELDED WIRE FABRIC
GB-GRADE BEAM
IJ-ISOLATION JOINT
CJ-CONTROL JOINT
BW's-BOTH WAYS
S.O.G-SLAB ON GRADE
TYP-TYPICAL
HOR.-HORIZONTAL
REINF.-REINFORCEMENT
LVL.-LEVEL

DOCUMENT NUMBER	REFERENCE DOCUMENTS	REV	DATE	REVISION DESCRIPTION	DRN	CHK	ENG	APP	EMP
		D01	13/06/2023	AS-BUILT	--	SNM	--	SJM	
		C02	24/05/2021	ISSUED FOR CONSTRUCTION & REVISED AS MKD	--	SNM	--	SJM	
		C01	07/12/2020	ISSUED FOR CONSTRUCTION	--	SNM	--	SJM	
MD-216-6000-EG-CV-STD-1001	REINFORCEMENT STANDARD	A02	02/11/2020	REVISED AS PER EMPLOYER COMMENTS ON 26/08/2020	--	SNM	--	SJM	
MD-216-2500-EG-CV-LAD-2001	GENERAL LAYOUT - EXPLOSIVE MAGAZINE	A01	01/08/2020	ISSUED FOR APPROVAL	--	SNM	--	SJM	

ADVACON





LARSEN & TOUBRO
This drawing is the property of LARSEN & TOUBRO and must not be passed on to any person or body not authorized by us to receive it nor be copied or otherwise made use either in full or in part by such person or body without our prior permission in writing.

Outotec
The content of these documents are the sole property of Outotec Oyj. Any rights not expressly granted herein are reserved. Reproduction, transfer or distribution of part or all of the contents in any form without prior written permission of Outotec is prohibited.

MA'ADEN معادن
Saudi Arabian Mining Company شركة التعدين العربية السعودية
This document and the information contained herein is Ma'aden proprietary know-how. This document or any part thereof should not be reproduced, stored in a retrieval system or transmitted by any means, electronic or otherwise, or divulged without prior written permission of Ma'aden.

DRAWN	--	--
CHECKED	SNM	31/07/2020
ENGINEER	--	--
APPROVED	SJM	01/08/2020
EMPLOYER		
SCALE	AS SHOW	A1

MANSOURAH - MASSARAH GOLD PROJECT
GENERAL ARRANGMENT
EXPLOSIVE MAGAZINE
PRILLS STORAGE GRADE SLAB & WALL DETAILS

DRAWING NUMBER MD-216-2500-EG-CV-GAD-2026 REV D01