


DRAWING NUMBER: MD-216-2500-EG-CV-GAD-2027 | REV: D01

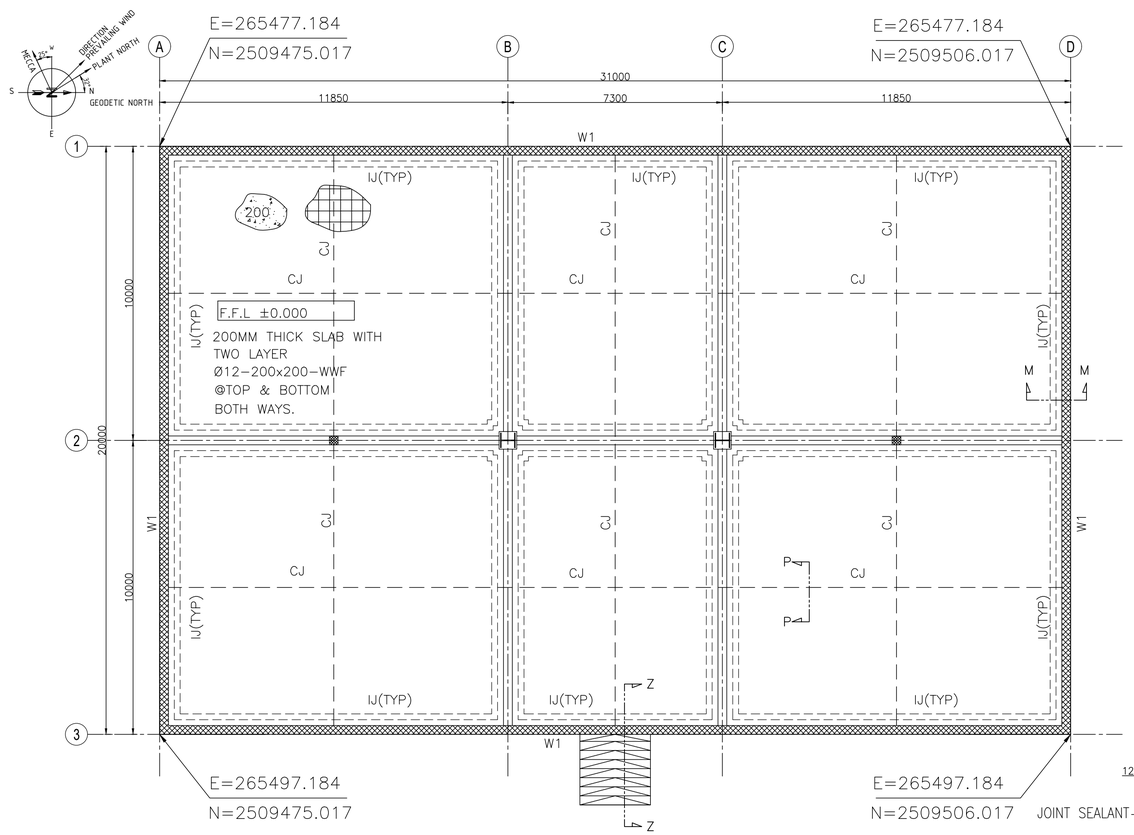

CONCRETE JOINTS LAYOUT
SCALE 1:150

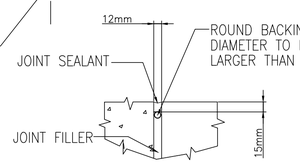


TYP JOINT SEAL DETAIL-C
SCALE 1:50

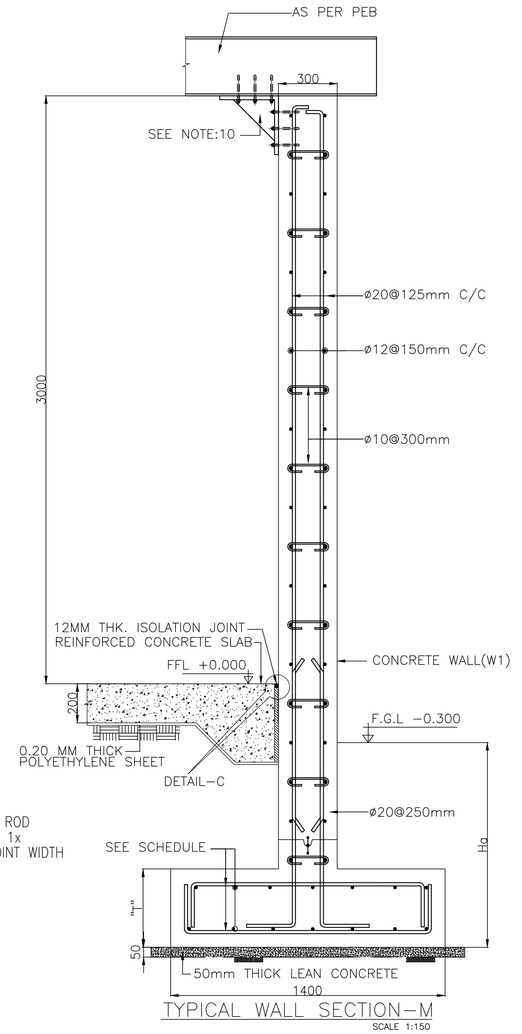


TYPICAL WALL SECTION-M
SCALE 1:150


NOTE: CONTROL JOINTS
SHALL BE PROVIDED AT MAX
SPACING OF 20 FT (6.10 M)
AS PER ACI CODE

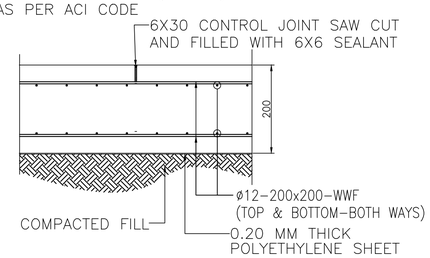

TYP CONTROL JOINT(CJ)SECTION-P
SCALE 1:50

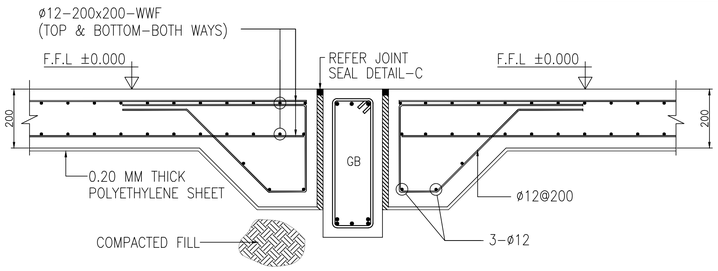


TYP SECTION FOR GRADE SLAB (A / 2028)
SCALE 1:50

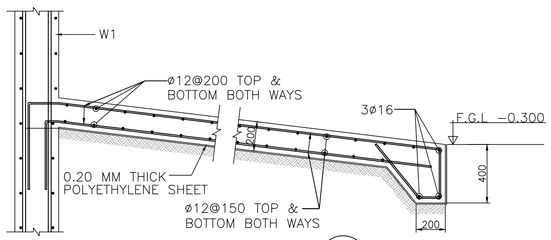

TYPICAL RAMP SECTION (Z / -)
SCALE 1:50

KEY PLAN

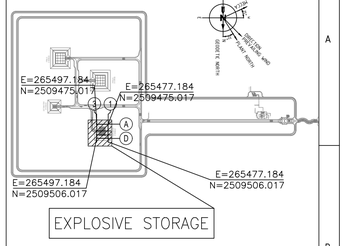

NOTES

1. ALL DIMENSIONS ARE GIVEN IN MILLIMETRES AND ELEVATIONS ARE IN METRES UNLESS OTHERWISE NOTED.
2. EL. (-) 0.300 CORRESPONDS TO RL.(+) 912.750 M (FGL)
3. MINIMUM REINFORCED CONCRETE GRADE TO BE USED FOR SUPERSTRUCTURE & SUBSTRUCTURES IS C35(5000 PSI).
4. MINIMUM LEAN CONCRETE GRADE TO BE USED FOR THE SUB-STRUCTURES IS C15(2175 PSI).
5. ALL REINFORCING STEEL SHALL BE DEFORMED BILLET STEEL BARS CONFORMING TO ASTM-A615, WITH MINIMUM YIELD STRENGTH OF FY420 MPA .
6. THE NET SOIL BEARING CAPACITY CONSIDERED IN FOUNDATION DESIGN IS 570 KPA(REFER DOC 216-3000-EG-CV-RPT-1008)
7. WATER PROOFING INSULATION SHALL BE AS PER PROJECT SPECIFICATIONS & ITS MATERIAL TO BE APPROVED BY SITE ENGINEER.
8. MINIMUM CONCRETE COVER AS PER SBC-304-2018(TABLE 20.6.1.3.1) MEASURED FROM REBAR SHALL BE
   a. CONCRETE CAST AGAINST & PERMANENTLY EXPOSED TO EARTH (INCLUDING FOUNDATIONS OVER SUB-SLAB) FORMED CONCRETE EXPOSED TO EARTH OR WEATHER.....50MM
   b. CONCRETE NOT EXPOSED TO WEATHER NOR IN CONTACT WITH GROUND
      BEAMS, COLUMNS.....40MM
      SLABS, WALLS, JOISTS.....20MM
   c. CONCRETE SLAB OVER 50MM SUB-SLAB.....20MM
9. ALL DRAWINGS MUST BE READ IN CONJUNCTION WITH RELEVANT ARCHITECTURAL AND ENGINEERING DRAWINGS RELATED TO THE SAME SHEET AND ANY ITEM ON IT(MD-216-2500-EG-CV-LAD-2001).
10. THE STEEL STRUCTURE DETAILS & MEMBER SIZES SHALL BE AS PER PEB VENDOR.BRACKET & CONNECTION DESIGN IS SUBJECT TO RECEIVING REACTION FROM PES VENDOR.
11. ALL THE ROOF AND WALL OPENING SHALL BE FOLLOWED AS PER APPROVED ARCH. DRAWING.
12. All drawings are in compliance with HCIS-SAF-14 & NFPA-495 Standards

LEGENDS

F/FDN.-FOUNDATION
W1-CONCRETE WALL 300mm THICK
FFL-FINISH FLOOR LEVEL
FGL-FINISH GROUND LEVEL
VER-VERTICAL
WWF-WELDED WIRE FABRIC
GB-GRADE BEAM
IJ-ISOLATION JOINT
CJ-CONTROL JOINT
BW's-BOTH WAYS
S.O.G-SLAB ON GRADE
TYP-TYPICAL
HOR.-HORIZONTAL
REINF.-REINFORCEMENT
LVL.-LEVEL

DOCUMENT NUMBER	REFERENCE DOCUMENTS	REV	DATE	REVISION DESCRIPTION	DRN	CHK	ENG	APP	EMP
		D01	13/06/2023	AS-BUILT	--	SNM	--	SJM	
MD-216-2500-EG-AR-GAD-2007	EXPLOSIVE STORAGE ELEVATION VIEW	C02	06/05/2021	ISSUED FOR CONSTRUCTION & REVISED AS MKD (4)	--	SNM	--	SJM	
MD-216-2500-EG-AR-GAD-2006	EXPLOSIVE STORAGE PLAN VIEW	C01	08/11/2020	ISSUED FOR CONSTRUCTION & REVISED AS MKD (4)	--	SNM	--	SJM	
MD-216-6000-EG-CV-STD-1001	REINFORCEMENT STANDARD	A02	08/10/2020	REVISED AS PER EMPLOYER COMMENTS ON 26/08/2020	--	SNM	--	SJM	
MD-216-2500-EG-CV-LAD-2001	GENERAL LAYOUT - EXPLOSIVE MAGAZINE	A01	01/08/2020	ISSUED FOR APPROVAL	--	SNM	--	SJM	

ADVACON

DRAWING NUMBER: MD-216-1800-EG-CV-DDE-1024 | REVISION: C02

DATE	03/28/2021	DATE	03/28/2021	DATE	03/28/2021
DRAWN	ABDUL	CHECKED	LARA	APPROVED	IHAB

LARSEN & TOUBRO DRAWING NUMBER: 019045_900_C_G_24486_001 | REVISION: 4

OUTOTEC DRAWING NUMBER: 900707__GAU01__ZZ01__MTL01__25024 | DOCUMENT ID: OU100691804 | REVISION: 4

DRAWN	--	--
CHECKED	SNM	10/08/2020
ENGINEER	--	--
APPROVED	SJM	10/08/2020
EMPLOYER		
SCALE	AS SHOWN	A1

MANSOURAH - MASSARAH GOLD PROJECT
DETAIL DRAWING
EXPLOSIVE MAGAZINE
EXPLOSIVE STORAGE GRADE SLAB & WALL DETAILS

DRAWING NUMBER: MD-216-2500-EG-CV-GAD-2027 | REV: D01

LARSEN & TOUBRO
This drawing is the property of LARSEN & TOUBRO and must not be passed on to any person or body not authorized by us to receive it nor be copied or otherwise made use either in full or in part by such person or body without our prior permission in writing.

Outotec
The content of these documents are the sole property of Outotec Oyj. Any rights not expressly granted herein are reserved. Reproduction, transfer or distribution of part or all of the contents in any form without prior written permission of Outotec is prohibited.

MA'ADEN معادن
Saudi Arabian Mining Company شركة معادن العربية السعودية
This document and the information contained herein is Ma'aden proprietary know-how. This document or any part thereof should not be reproduced, stored in a retrieval system or transmitted by any means, electronic or otherwise, or divulged without prior written permission of Ma'aden.