


DRAWING NUMBER MD-216-2500-EG-CV-GAD-2028 REV D01

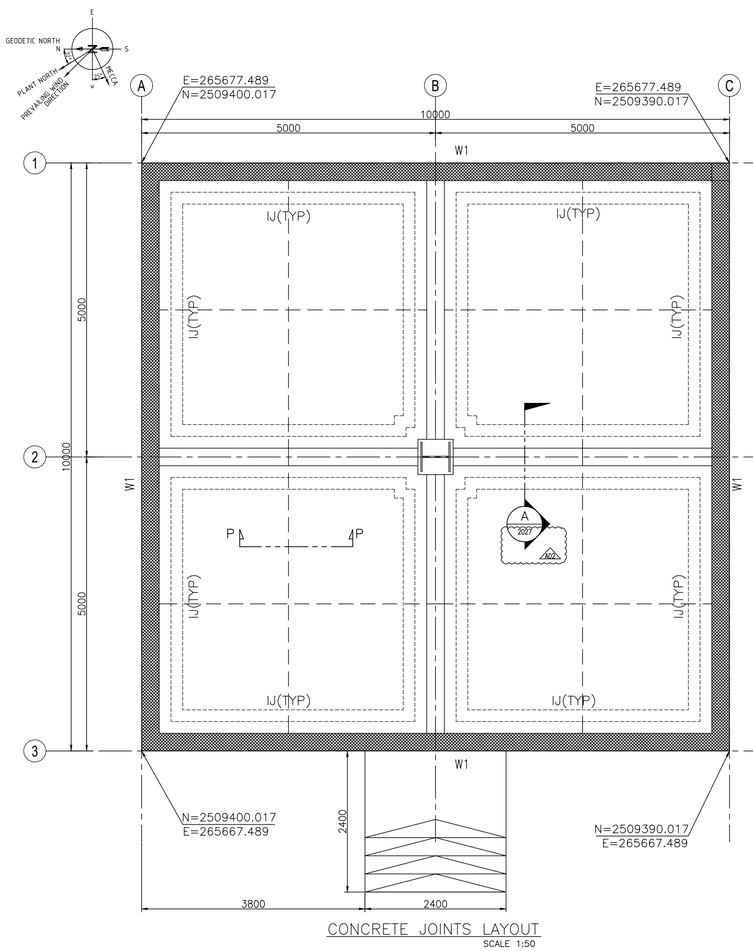



CONCRETE JOINTS LAYOUT
SCALE 1:50

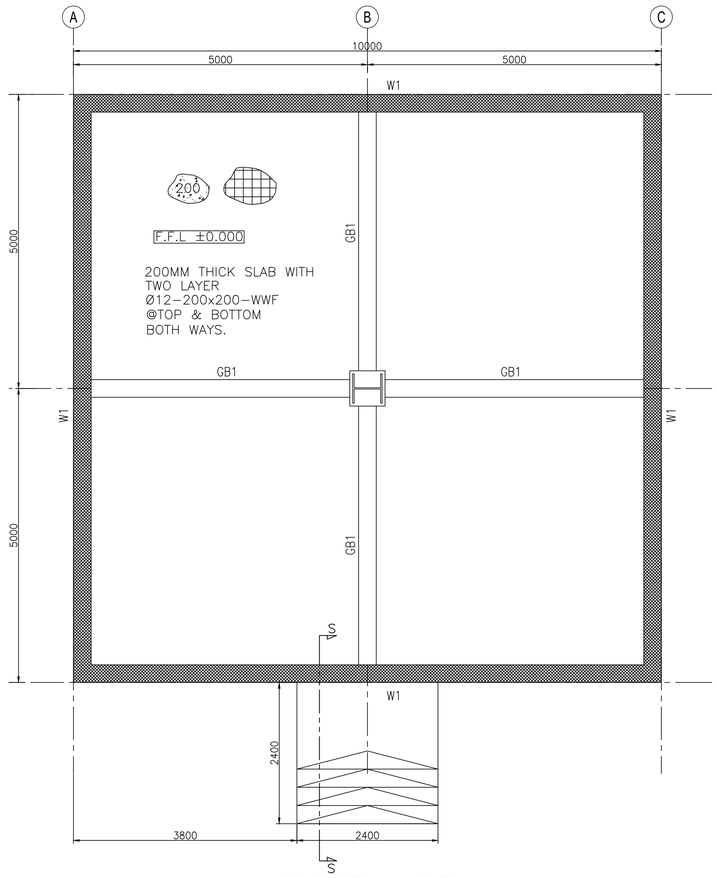



GRADE BEAM LAYOUT
SCALE 1:50

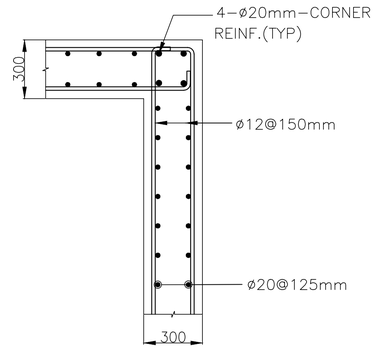


WALL CORNER REINF. DETAIL
SCALE: 1:100

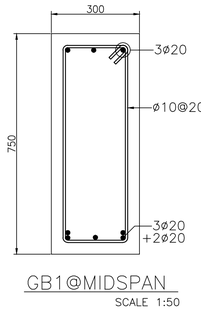



GB1@MIDSPAN
SCALE 1:50

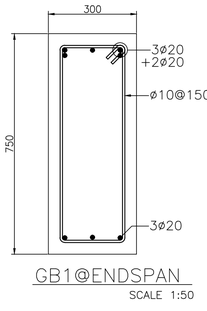


GB1@ENDSPAN
SCALE 1:50


NOTE : CONTROL JOINTS
SHALL BE PROVIDED AT MAX
SPACING OF 20 FT (6.10 M)
AS PER ACI CODE

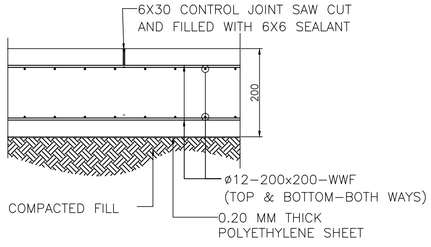


TYP CONTROL JOINT(CJ)SECTION-P
SCALE 1:50


## SCHEDULE OF GRADE BEAMS

| BEAM MARK | DIMENSIONS | | STEEL REINFORCEMENT | | | | STIRRUPS |
|---|---|---|---|---|---|---|---|
| | | | BOTTOM | | TOP | | |
| | WIDTH | DEPTH | STRAIGHT | ADD. | STRAIGHT | ADD. | |
| GB1 | 300 | 750 | 3ø20 | 2ø20 | 3ø20 | 2ø20 | PROVIDE ø10@150 AT END SPAN@DISTANCE OF L/3 FROM THE SUPPORT & ø10@200 AT MIDSPAN |
| | | | | | | | |

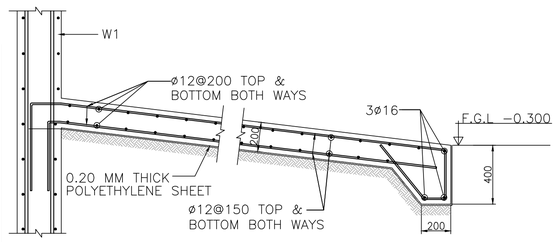


TYPICAL RAMP SECTION-S
SCALE 1:50

## KEY PLAN

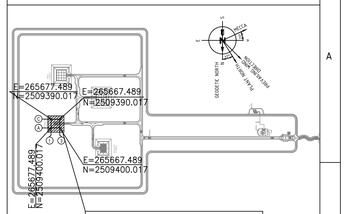


## NOTES

1. ALL DIMENSIONS ARE GIVEN IN MILLIMETRES AND ELEVATIONS ARE IN METRES UNLESS OTHERWISE NOTED.
2. MINIMUM REINFORCED CONCRETE GRADE TO BE USED FOR SUPERSTRUCTURE & SUBSTRUCTURES IS C35(5000 PSI).
3. MINIMUM LEAN CONCRETE GRADE TO BE USED FOR THE SUB-STRUCTURES IS C15(2175 PSI).
4. ALL REINFORCING STEEL SHALL BE DEFORMED BILLET STEEL BARS CONFORMING TO ASTM-A615, WITH MINIMUM YIELD STRENGTH OF FY420 MPA .
5. THE NET SOIL BEARING CAPACITY CONSIDERED IN FOUNDATION DESIGN IS 570 KPA(REFER DOC 216-3000-EG-CV-RPT-1008)
6. WATER PROOFING INSULATION SHALL BE AS PER PROJECT SPECIFICATIONS & ITS MATERIAL TO BE APPROVED BY SITE ENGINEER.
7. MINIMUM CONCRETE COVER AS PER SBC-304-2018(TABLE 20.6.1.3.1) MEASURED FROM REBAR SHALL BE
   a. CONCRETE CAST AGAINST & PERMANENTLY EXPOSED TO EARTH (INCLUDING FOUNDATIONS OVER SUB-SLAB) FORMED CONCRETE EXPOSED TO EARTH OR WEATHER.....50MM
   b. CONCRETE NOT EXPOSED TO WEATHER NOR IN CONTACT WITH GROUND
      BEAMS, COLUMNS.....40MM
      SLABS, WALLS, JOISTS.....20MM
   c. CONCRETE SLAB OVER 50MM SUB-SLAB.....20MM
8. ALL DRAWINGS MUST BE READ IN CONJUNCTION WITH RELEVANT ARCHITECTURAL AND ENGINEERING DRAWINGS RELATED TO THE SAME SHEET AND ANY ITEM ON IT(MD-216-2500-EG-CV-LAD-2001).
9. THE STEEL STRUCTURE DETAILS & MEMBER SIZES SHALL BE AS PER PEB VENDOR.BRACKET & CONNECTION DESIGN IS SUBJECT TO RECEVING REACTION FROM PES VENDOR.
10. ALL THE ROOF AND WALL OPENING SHALL BE FOLLOWED AS PER APPROVED ARCH. DRAWING.

## LEGENDS

FFL-FINISH FLOOR LEVEL
FGL-FINISH GROUND LEVEL
VER-VERTICAL
WWF-WELDED WIRE FABRIC
GB-GRADE BEAM
IJ-ISOLATION JOINT
CJ-CONTROL JOINT
BW's-BOTH WAYS
S.O.G-SLAB ON GRADE
TYP-TYPICAL
HOR.-HORIZONTAL
REINF.-REINFORCEMENT
LVL.-LEVEL
RL.-REDUCED LEVEL
P.-PEDESTAL
℄ -LINE OF COLUMN
EF. - EACH FACE
DIA-DIAMETER

| DOCUMENT NUMBER | REFERENCE DOCUMENTS | REV | DATE | REVISION DESCRIPTION | DRN | CHK | ENG | APP | EMP |
|---|---|---|---|---|---|---|---|---|---|
| MD-216-2500-EG-AR-GAD-2012 | DETONATOR STORAGE ELEVATION VIEW | | | | | | | | |
| MD-216-2500-EG-AR-GAD-2011 | DETONATOR STORAGE PLAN VIEW | D01 | 13/06/2023 | AS-BUILT | -- | SNM | -- | SJM | |
| MD-216-6000-EG-CV-STD-1002 | HOLLOW CORE SLAB STANDARD | C01 | 08/11/2020 | ISSUED FOR CONSTRUCTION | -- | SNM | -- | SJM | |
| MD-216-6000-EG-CV-STD-1001 | REINFORCEMENT STANDARD | A02 | 08/10/2020 | REVISED AS PER EMPLOYER COMMENTS ON 26/08/2020 | -- | SNM | -- | SJM | |
| MD-216-2500-EG-CV-LAD-2001 | GENERAL LAYOUT - EXPLOSIVE MAGAZINE | A01 | 01/08/2020 | ISSUED FOR APPROVAL | -- | SNM | -- | SJM | |

ADVACON

DRAWING NUMBER MD-216-1800-EG-CV-DDE-1025 | REVISION C01

| DATE | 05/11/2020 | DATE | 07/11/2020 | DATE | 08/11/2020 |
|---|---|---|---|---|---|
| DRAWN | ABDUL | CHECKED | LARA | APPROVED | IHAB |

LARSEN & TOUBRO DRAWING NUMBER 019045_900_C_G_24487_001 | REVISION 3

OUTOTEC DRAWING NUMBER 900707__GAU01__ZZ01__MTL01__25040 | DOCUMENT ID OU100691820 | REVISION 3

LARSEN & TOUBRO
This drawing is the property of LARSEN & TOUBRO and must not be passed on to any person or body not authorized by us to receive it nor be copied or otherwise made use either in full or in part by such person or body without our prior permission in writing.

Outotec
The content of these documents are the sole property of Outotec Oyj. Any rights not expressly granted herein are reserved. Reproduction, transfer or distribution of part or all of the contents in any form without prior written permission of Outotec is prohibited.

MA'ADEN معادن
Saudi Arabian Mining Company شركة معادن العربية السعودية
This document and the information contained herein is Ma'aden proprietary know-how. This document or any part thereof should not be reproduced, stored in a retrieval system or transmitted by any means, electronic or otherwise, or divulged without prior written permission of Ma'aden.

| | | |
|---|---|---|
| DRAWN | -- | -- |
| CHECKED | SNM | 10/08/2020 |
| ENGINEER | -- | -- |
| APPROVED | SJM | 10/08/2020 |
| EMPLOYER | | |
| SCALE | AS SHOW | A1 |

MANSOURAH - MASSARAH GOLD PROJECT
GENERAL ARRANGEMENT
EXPLOSIVE MAGAZINE
DETONATOR STORAGE SLAB & WALL DETAILS

DRAWING NUMBER MD - 216 - 2500 - EG - CV - GAD - 2028 | REV D01