

DRAWING NUMBER: MD-216-2500-EG-CV-GAD-2031 REV D01

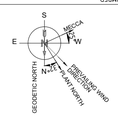


E=265835.789 N=2509030.430 T.O.R+912.200
E=265827.489 N=2509042.730
E=265823.489 N=2509038.730
500ø R.C HUME PIPE SLOPE=1:200 (START IL+911.300)
E=265331.184 N=2509038.730
E=265318.884 N=2509030.430 T.O.R+912.200
E=265327.184 N=2509042.730
E=265713.189
500ø R.C HUME PIPE SLOPE=1:200 (START IL+911.400)
E=265451.484
R15
E=265813.189 N=2509053.030 T.O.R+912.200
E=265341.484 N=2509053.030 T.O.R+912.200
4800
PRILLS STORAGE
E=265631.537 N=2509208.730
E=265577.384 N=2509208.730
E=265577.384 N=2509243.267 T.O.R+912.200
E=265608.184 N=2509243.267 T.O.R+912.200
E=265546.434 N=2509243.267 T.O.R+912.200
E=265341.484 N=2509215.323
E=265343.184 N=2509243.267 T.O.R+912.200
32300
25000
7000
E=265546.434 N=2509295.017
E=265516.144 N=2509295.017
E=265318.884 N=2509361.023 T.O.R+912.200
912.200 LS
400ø R.C HUME PIPE SLOPE=1:200 (START IL+911.800)
E=265327.184 N=2509370.823
E=265242.594 N=2509361.023
E=264942.594 N=2509361.023
E=264928.294 N=2509361.023
E=264866.917 N=2509361.023
E=264742.594 N=2509361.023 T.O.R+913.600
200ø R.C HUME PIPE SLOPE=1:200 (START IL+913.100)
E=264916.694 N=2509349.423
913.600 S L
FUEL DISPENSING AREA
400ø R.C HUME PIPE SLOPE=1:200 (START IL+912.900)
E=264878.517 N=2509349.423
E=264760.894 N=2509370.823
7500
3-400ø R.C HUME PIPE SLOPE=1:200 (START IL+911.300)
3-400ø R.C HUME PIPE SLOPE=1:200 (START IL+911.200)
N=2509342.217
DETONATOR STORAGE
E=265664.729 N=2509395.017
3-400ø R.C HUME PIPE SLOPE=1:250 (START IL+911.500)
E=265608.184 N=2509395.017 T.O.R+912.200
E=265530.234 N=2509443.267 T.O.R+912.200
E=265608.184 N=2509443.267 T.O.R+912.200
EXPLOSIVE MAGAZINE INTERNAL SEPARATION GATE
912.200 LS
E=265343.184 N=2509443.267 T.O.R+912.200
E=265242.594 N=2509443.267
E=265341.484 N=2509471.212
E=265530.234 N=2509490.517
E=26549.994 N=2509490.517
EXPLOSIVE STORAGE
913.600 INSTRUMENTATION ROOM
ELECTRICAL ROOM
E=264942.594 N=2509443.267
E=264868.894 N=2509443.267
SECURITY SUPPORT BUILDING
OG AREA
GATE HOUSE
E=264742.594 N=2509443.267 T.O.R+913.600
E=264665.376 N=2509443.265 T.O.R+915.00 (MATCH WITH MAIN ROAD)
10000
21000
16150
50895
3000
CAR PARKING
E=265327.184 N=2509495.817
60000
E=265242.594 N=2509505.617
4000ø R.C HUME PIPE SLOPE=1:200 (START IL+911.800)
CATEGORY 3 FENCE
E=264942.594 N=2509505.617
90000
E=264760.894 N=2509495.817
4000ø R.C HUME PIPE SLOPE=1:200 (START IL+912.900)
E=264742.594 N=2509505.617 T.O.R+913.600
E=265318.884 N=2509505.617 T.O.R+912.200
E=265813.189 N=2509641.717 T.O.R+912.200
E=265341.484 N=2509641.717 T.O.R+912.200
E=265713.189
E=265451.484
E=265327.184 N=2509652.017
E=265318.884 N=2509664.317 T.O.R+912.200
E=265827.489 N=2509652.017
E=265835.789 N=2509664.317 T.O.R+912.200
E=265823.489 N=2509656.017
E=265331.184 N=2509656.017
CATEGORY 1 FENCE

CUT AND FILL SLOPES


TERRAIN TYPE	DEPTH	CUT SLOPE (H : V)	FILL SLOPE (H : V)
ROLLING	0.00 - 1.00	3 : 1	4 : 1
	1.00 - 3.00	2 : 1	4 : 1
	3.00 - 5.00	2 : 1	3 : 1
	> 5.00	2 : 1	2 : 1

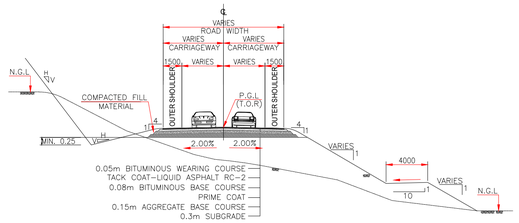

TYPICAL ROAD CROSS SECTION

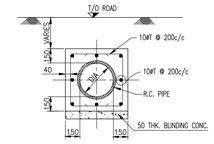

TYPICAL CROSS SECTION OF R.C. HUME PIPE UNDER ROAD
SCALE 1:20

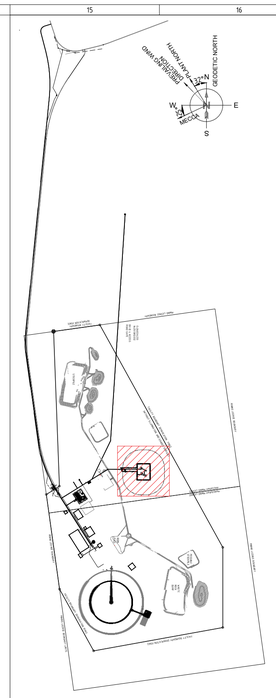

KEY PLAN

LEGEND:

— x — x —	CATEGORY 1 FENCE
— x — x —	CATEGORY 3 FENCE
	NEW ROAD (L&T SCOPE)
N.G.L.	NATURAL GROUND LEVEL
T.O.R.	TOP OF ROAD
R.C	REINFORCED CONCRETE
IL	INVERT LEVEL

NOTE:

1. ALL DIMENSIONS ARE IN MILLIMETRES UNLESS OTHERWISE SPECIFIED.
2. WORLD MAPPING GRID BASED ON UTM (WGS 84) Q38N.
3. TOP OF ROAD (T.O.R). LEVEL SHOWN THUS..... 911.6 / 3.4
4. INSIDE RADIUS OF CURVATURE OF ROAD SHOWN THUS.....15R, INDICATES RADIUS = 15M.
5. SYMBOL USED AS:- `S' = SLOPE AND `L' = LEVEL.

DOCUMENT NUMBER	REFERENCE DOCUMENTS	REV	DATE	REVISION DESCRIPTION	DRN	CHK	ENG	APP	EMP
		D01	13/06/2023	AS-BUILT	APEX	SNM	APEX	SJM	
		C01	07/01/2021	ISSUED FOR CONSTRUCTION	APEX	SNM	APEX	SJM	
MD-216-2500-EG-CV-LAD-2001	GENERAL LAYOUT-EXPLOSIVE MAGAZINE	A01	02/12/2020	ISSUED FOR REFERENCE	APEX	SNM	APEX	SJM	

DOCUMENT NUMBER	REFERENCE DOCUMENTS	REV	DATE	REVISION DESCRIPTION	DRN	CHK	ENG	APP	EMP

RESERVER FOR VENDOR LOGO AND DRAWING NUMBER

LARSEN & TOUBRO

This drawing is the property of LARSEN & TOUBRO and must not be passed on to any person or body not authorized by us to receive it nor be copied or otherwise made use either in full or in part by such person or body without our prior permission in writing.

Outotec

The content of these documents are the sole property of Outotec Oy. Any rights not expressly granted herein are reserved. Reproduction, transfer or distribution of part or all of the contents in any form without prior written permission of Outotec is prohibited.

MA'ADEN Saudi Arabian Mining Company معادن

This document and the information contained herein is Ma'aden proprietary know-how. This document or any part thereof should not be reproduced, stored in a retrieval system or transmitted by any means, electronic or otherwise, or divulged without prior written permission of Ma'aden.

LARSEN & TOUBRO DRAWING NUMBER			REVISION
O19045_900_C_G_24499_001			2
OUTOTEC DRAWING NUMBER		DOCUMENT ID	REVISION
900707__GAU01__ZZ01__MTL01__25098		OU100706137	2
DRAWN	APEX	27/11/2020	MANSOURAH - MASSARAH GOLD PROJECT
CHECKED	SNM	30/11/2020	GENERAL ARRANGEMENT
ENGINEER	APEX	26/11/2020	EXPLOSIVE MAGAZINE
APPROVED	SJM	02/12/2020	ROAD LAYOUT, CROSS SECTIONAL & DETAIL
EMPLOYER			
SCALE 1:1250	A0		DRAWING NUMBER: MD-216-2500-EG-CV-GAD-2031 REV: D01