


DRAWING NUMBER MD-216-2500-EG-CV-GAD-2032 REV D01

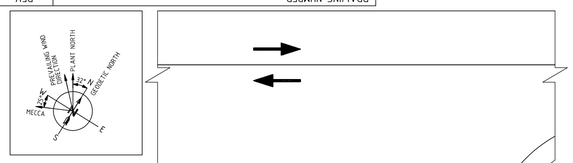

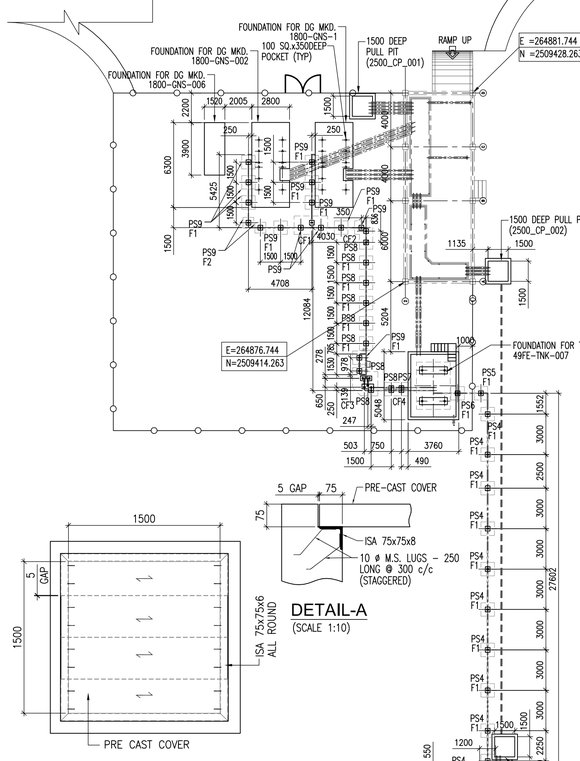


PLAN AT TOP OF PIT
(SCALE-1:30)


DETAIL-A
(SCALE 1:10)

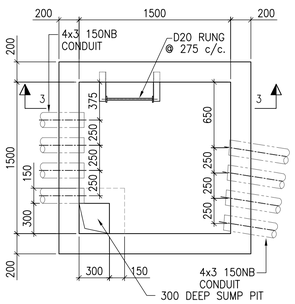


PLAN AT BASE RAFT LEVEL
(DETAIL OF PULL PIT MKD 2500_CP_001)
(SCALE-1:30)

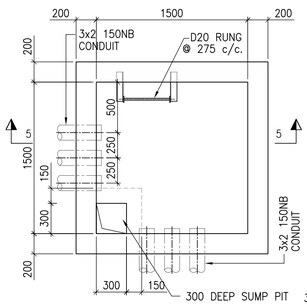


PLAN AT BASE RAFT LEVEL
(DETAIL OF PULL PIT MKD 2500_CP_002)
(SCALE-1:30)

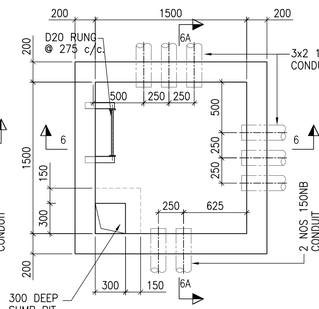


PLAN AT BASE RAFT LEVEL
(DETAIL OF PULL PIT MKD 2500_CP_003)
(SCALE-1:30)

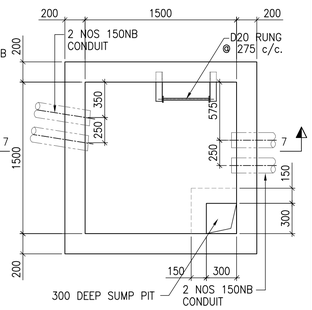


PLAN AT BASE RAFT LEVEL
(DETAIL OF PULL PIT MKD 2500_CP_004)
(SCALE-1:30)

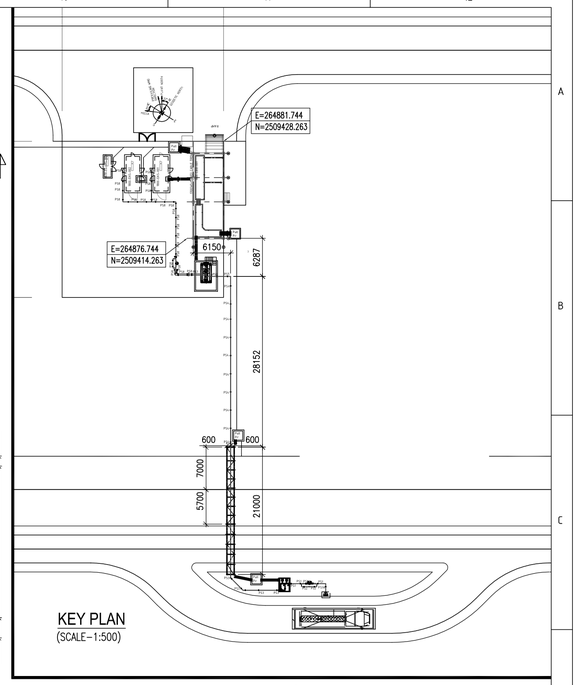


KEY PLAN
(SCALE-1:500)

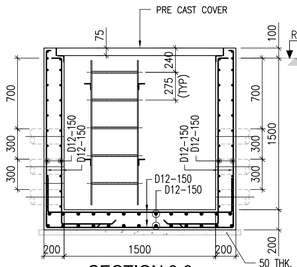


SECTION 3-3
(SCALE 1:30)

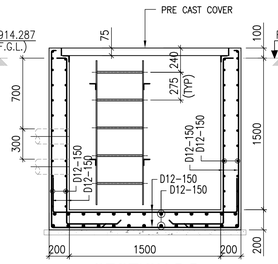


SECTION 5-5
(SCALE 1:30)

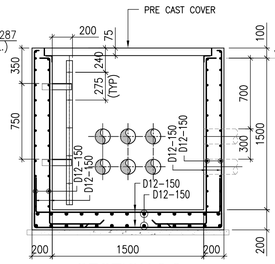


SECTION 6-6
(SCALE 1:30)

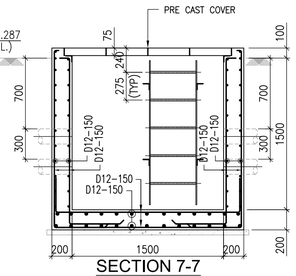

SECTION 7-7
(SCALE 1:30)

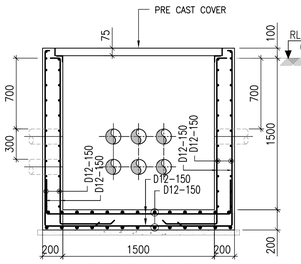


SECTION 6A-6A
(SCALE 1:30)

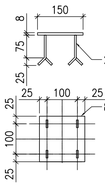


DETAIL OF 150 SQ. INSERT PL.
(SCALE 1:10)

SECTION 4-4
(SCALE 1:40)

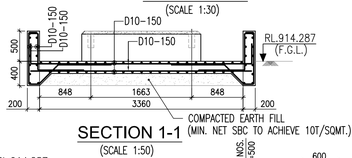


SECTION 1-1 (MIN. NET SBC TO ACHIEVE 10T/SQMT.)
(SCALE 1:50)


SECTION 2A-2A
(SCALE 1:50)

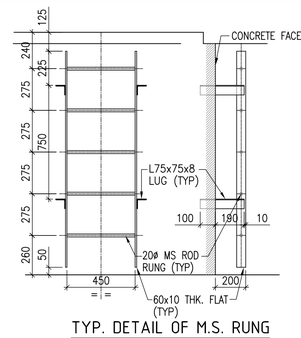

TYP. DETAIL OF M.S. RUNG
(SCALE 1:20)

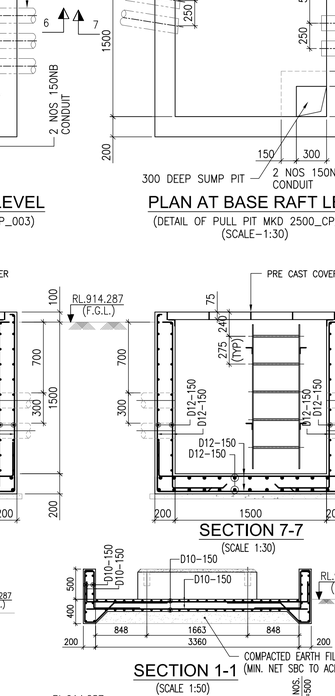


SECTION 2-2
(SCALE 1:50)

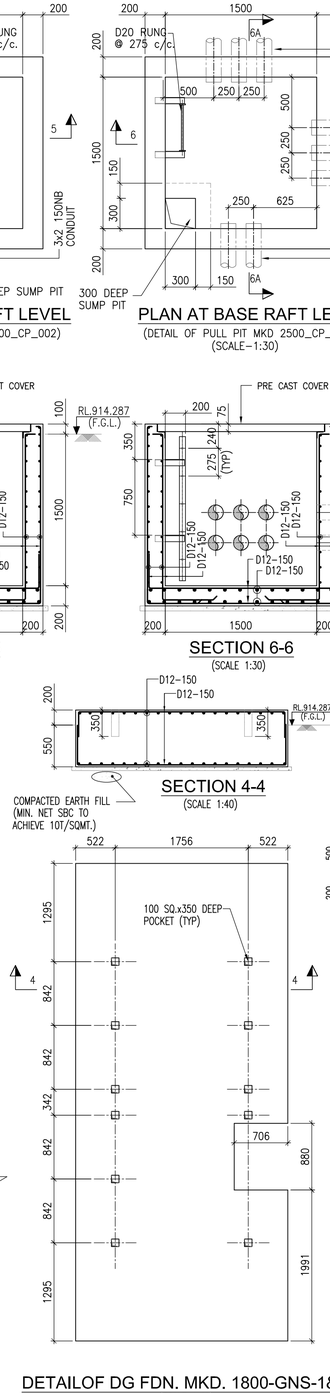

DETAILOF DG FDN. MKD. 1800-GNS-1&2
(SCALE 1:40)

PLAN OF DIESEL TANK DYKE AREA
(SCALE 1:50)

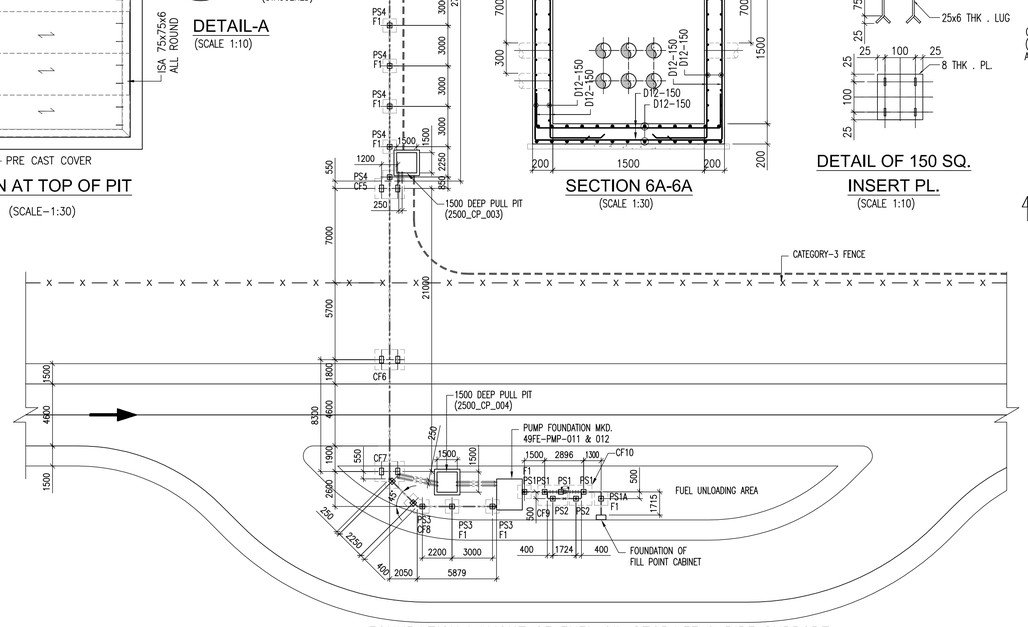

FOUNDATION LAYOUT OF FUEL OIL STORAGE & PIPE SUPPORT

QUANTITY	
PCC – 4.12 CUM	
RCC – 57.13 CUM	

LEGEND :-

R.L. – REDUCED LEVEL
℄ – CENTRE LINE
T.O.C. – TOP OF CONCRETE
TYP. – TYPICAL
F.G.L. – FINISHED GROUND LEVEL
F.F.L. – FINISHED FLOOR LEVEL
B.O.F. – BOTTOM OF FOUNDATION
MKD. – MARKED
P.C.C – PLAIN CEMENT CONCRETE
DET. – DETAIL
BOTTOM REINFORCEMENT (B) - - - - -
TOP REINFORCEMENT (T) ———
SQ. – SQUARE
R.C. – REINFORCED CONCRETE
FDN. – FOUNDATION
THK. – THICK

NOTES:-

1. ALL DIMENSIONS ARE IN MILLIMETRES AND LEVELS AND CO-ORDINATES ARE IN METRES UNLESS OTHERWISE STATED.
2. NET SAFE BEARING CAPACITY OF SOIL AT BOTTOM OF FOUNDATION CONSIDER 200KN/ SQ. M
3. GRADE OF CONCRETE SHALL BE C35 (35MPa) FOR FOUNDATION & C15 (15MPa) FOR BLINDING CONCRETE.
4. GRADE OF REINFORCEMENT SHALL BE DEFORMED BAR 420 MPa (GRADE 60) – ASTM A615/A615M.
5. IF ANY PART OF FOUNDATION COMES ON BACKFILL ZONE OF ADJACENT FOUNDATION OR ANY LOOSE SOIL ARE ENCOUNTERED BELOW FOUNDATION LEVEL THE SAME SHALL BE REMOVED AND FILLED WITH PCC (C15).
6. CLEAR COVER TO REINFORCEMENT SHALL BE
   a. FOUNDATIONS = 50 MM., b. COLUMNS = 50 MM.
7. FOR STANDARD REINFORCEMENT DETAIL & GENERAL NOTES FOR CIVIL WORKS REFER DRAWING NO. MD-216-1000-EG-CV-DED-1005 & 1001.

DOCUMENT NUMBER	REFERENCE DOCUMENTS	REV	DATE	REVISION DESCRIPTION	DRN	CHK	ENG	APP	EMP
		D01	24/7/2023	AS BUILT					
		C03	25/07/2022	ISSUED FOR CONSTRUCTION & REVISED AS MKD. C03	SYA	SJM	SNM	SJM	
		C02	29/05/2021	ISSUED FOR CONSTRUCTION & REVISED AS MKD. C02	SC	TG	SNM	SJM	
MD-216-3310-EG-ME-GAD-1055	GENERAL LAYOUT-EXPLOSIVE MAGAZINE	C01	07/01/2021	ISSUED FOR CONSTRUCTION	SC	TG	SNM	SJM	
MD-216-3310-EG-CV-GAD-1177	EXPLOSIVE MAGAZINE LAYOUT	A01	05/12/2020	ISSUED FOR APPROVAL	SC	TG	SNM	SJM	

RESERVED FOR VENDOR LOGO AND DRAWING NUMBER

LARSEN & TOUBRO
This drawing is the property of LARSEN & TOUBRO and must not be passed on to any person or body not authorized by us to receive it nor be copied or otherwise made use either in full or in part by such person or body without our prior permission in writing.

Outotec
The content of these documents are the sole property of Outotec Oyj. Any rights not expressly granted herein are reserved. Reproduction, transfer or distribution of part or all of the contents in any form without prior written permission of Outotec is prohibited.

MA'ADEN معادن
Saudi Arabian Mining Company شركة التعدين العربية السعودية
This document and the information contained herein is Ma'aden proprietary know-how. This document or any part thereof should not be reproduced, stored in a retrieval system or transmitted by any means, electronic or otherwise, or divulged without prior written permission of Ma'aden.

LARSEN & TOUBRO DRAWING NUMBER: 019045_900_C_G_24460_001 — REVISION: 4
OUTOTEC DRAWING NUMBER: 900707 _GAU01 _ZZ01 _MTL01 _25099 — DOCUMENT ID: OU100706722 — REVISION: 4

DRAWN	SC	04/12/2020
CHECKED	TG	05/12/2020
ENGINEER	SNM	01/12/2020
APPROVED	SJM	05/12/2020
EMPLOYER		
SCALE	1:20, 1:50, 1:150	A1

MANSOURAH - MASSARAH GOLD PROJECT
GENERAL ARRANGEMENT
EXPLOSIVE MAGAZINE
GA AND DETAILS OF OF FUEL AREA FOUNDATIONS

DRAWING NUMBER: MD-216-2500-EG-CV-GAD-2032 — REV: D01