MD - 216 - 2500 - EG - CV - GAD - 2033
DRAWING NUMBER
D01
REV

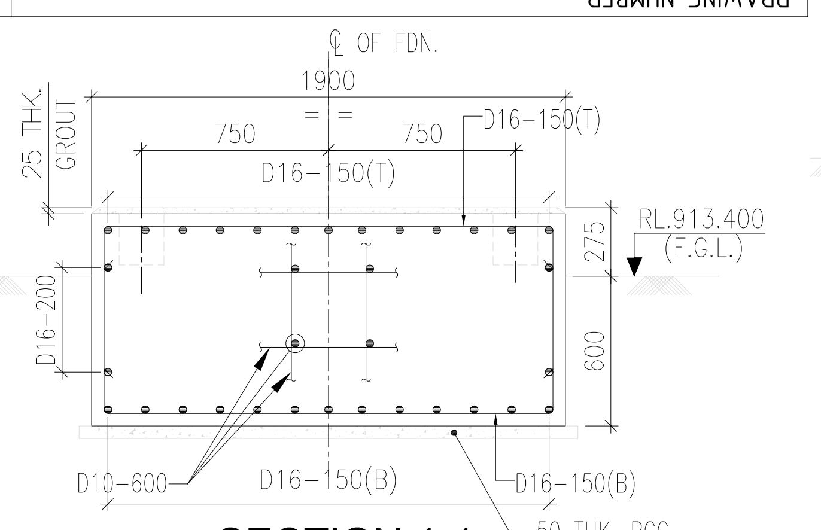

SECTION 1-1
(SCALE 1:30)

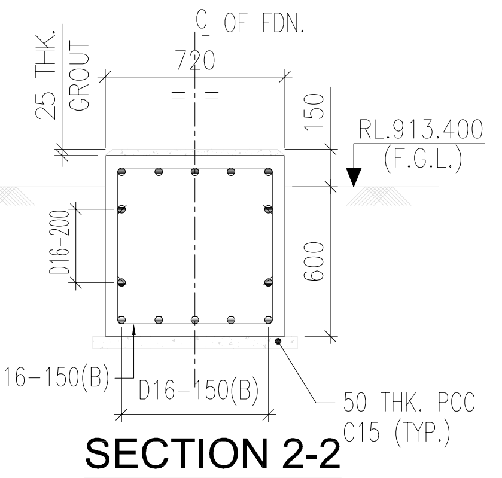

SECTION 2-2
(SCALE 1:30)

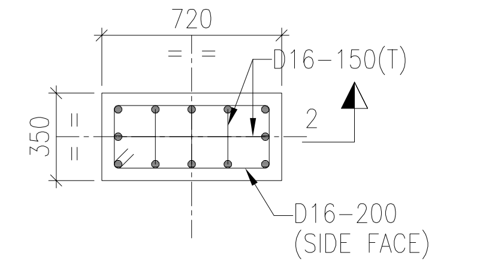

DETAIL OF FDN. FOR FILL POINT CABINET
(SCALE 1:30)

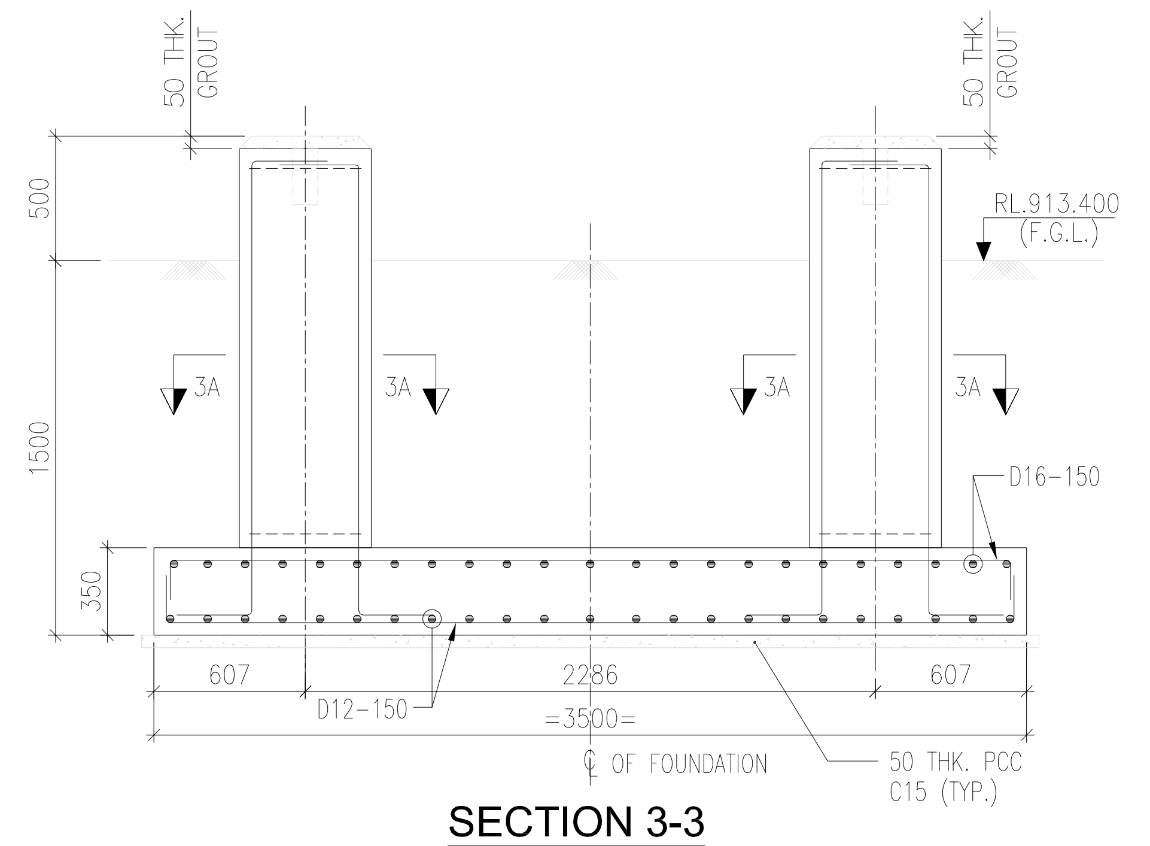

SECTION 3-3
(SCALE 1:30)

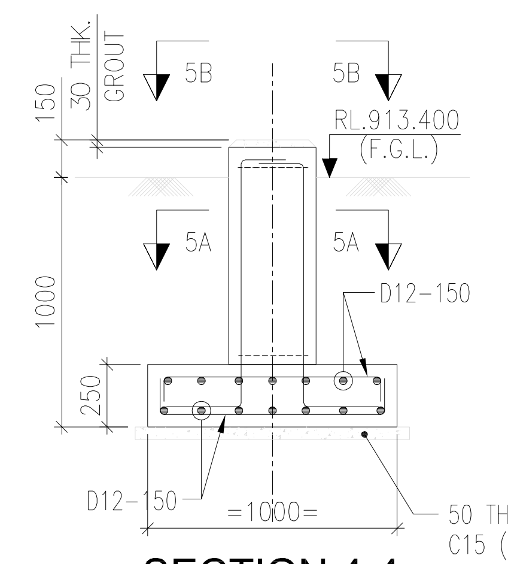

SECTION 4-4
(SCALE 1:30)

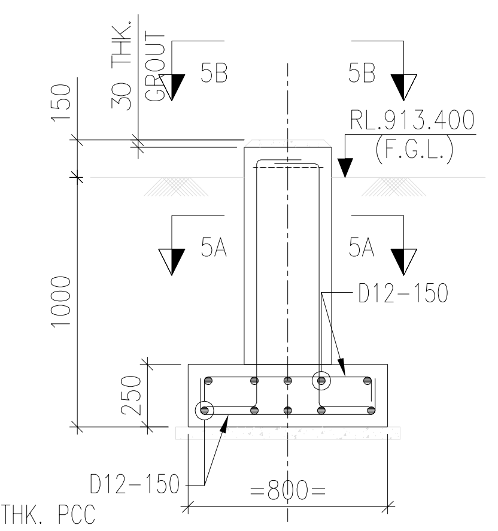

SECTION 4A-4A
(SCALE 1:30)

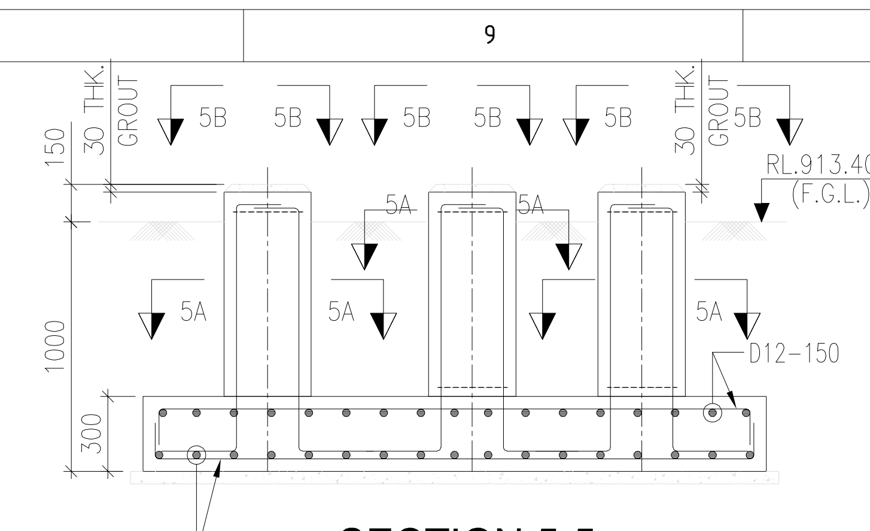

SECTION 5-5
(SCALE 1:30)

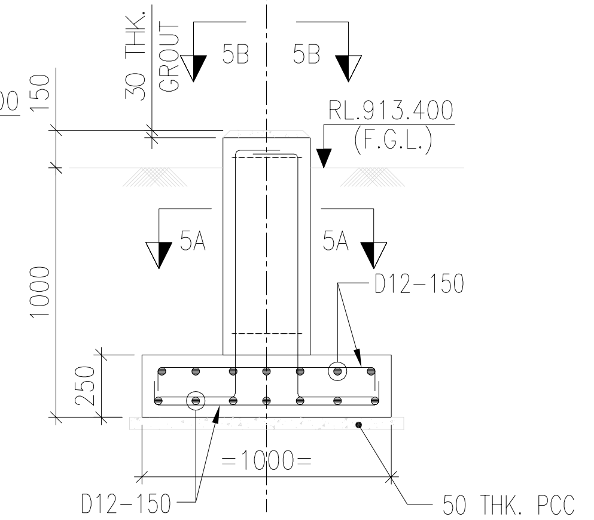

SECTION 6-6
(SCALE 1:30)

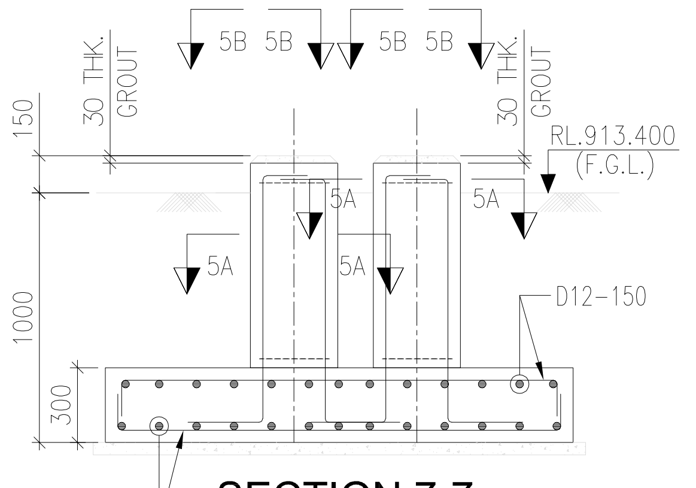

SECTION 7-7
(SCALE 1:30)

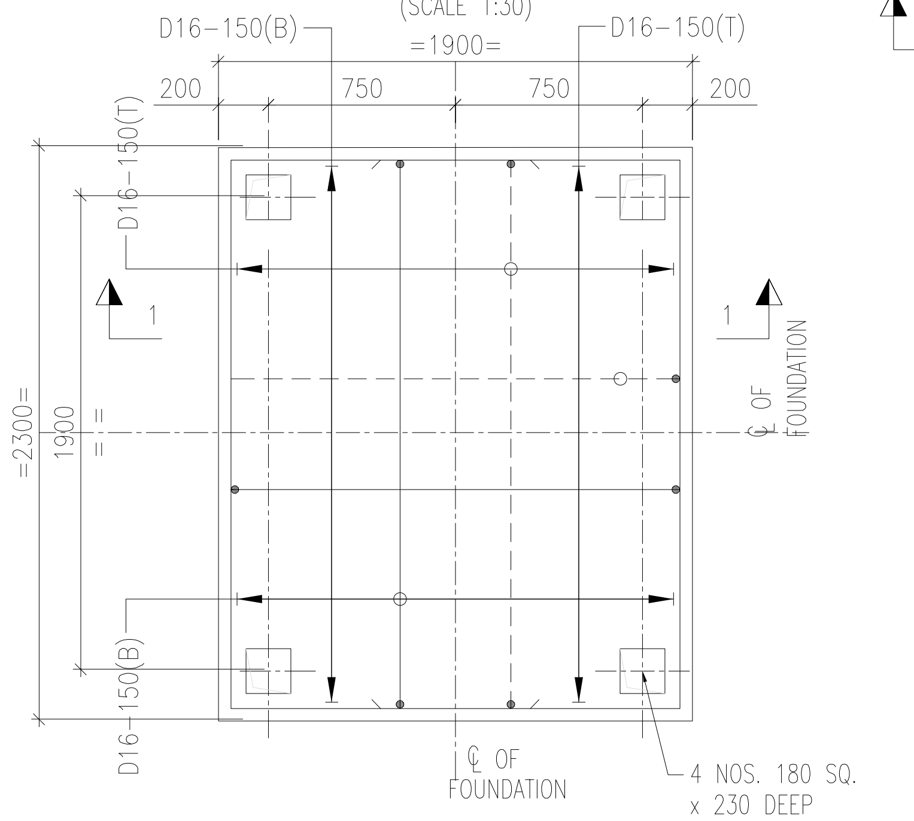

DETAIL OF FDN. MKD. 49FE-PMP-011 & 012
(SCALE 1:30)

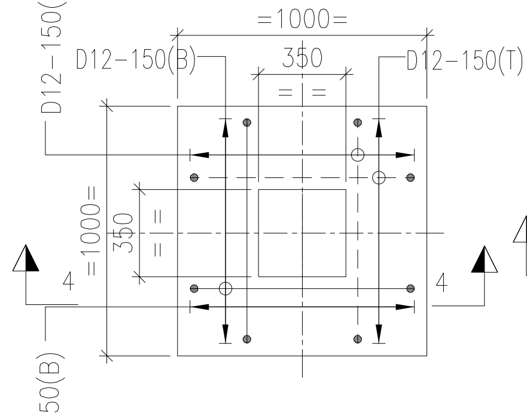

DETAIL OF FDN. MKD. F1
(SCALE 1:30)

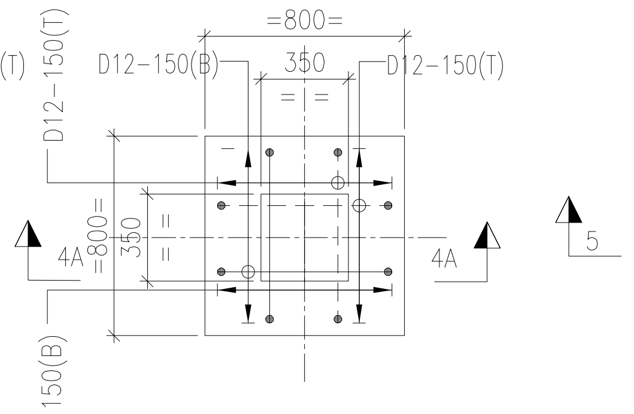

DETAIL OF FDN. MKD. F2
(SCALE 1:30)

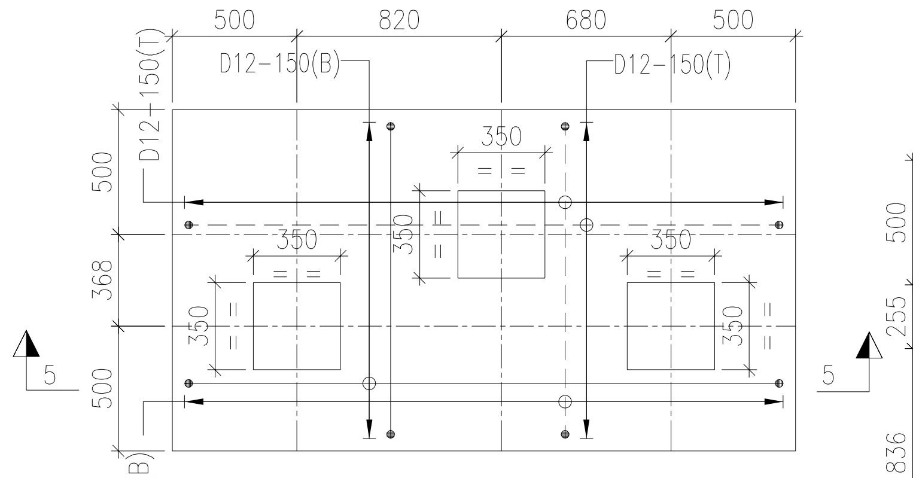

DETAIL OF FDN. MKD. CF1
(SCALE 1:30)

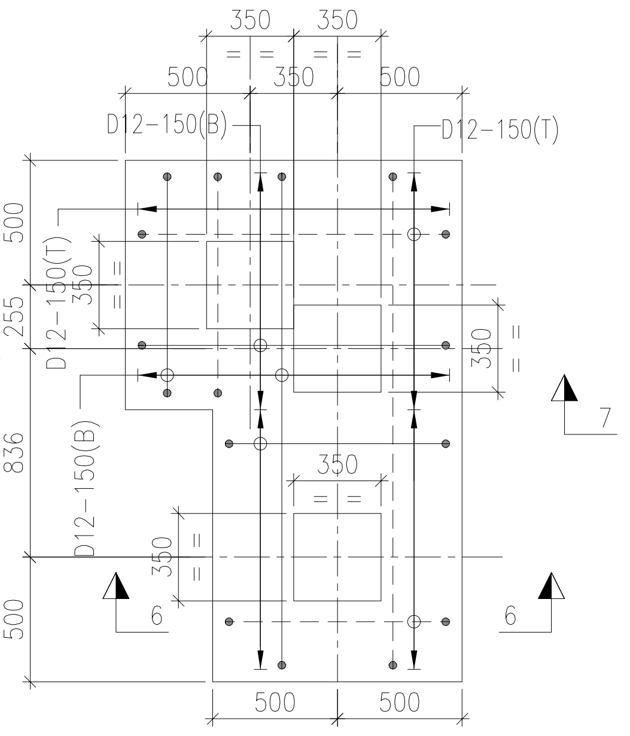

C02

DETAIL OF FDN. MKD. CF2
(SCALE 1:30)

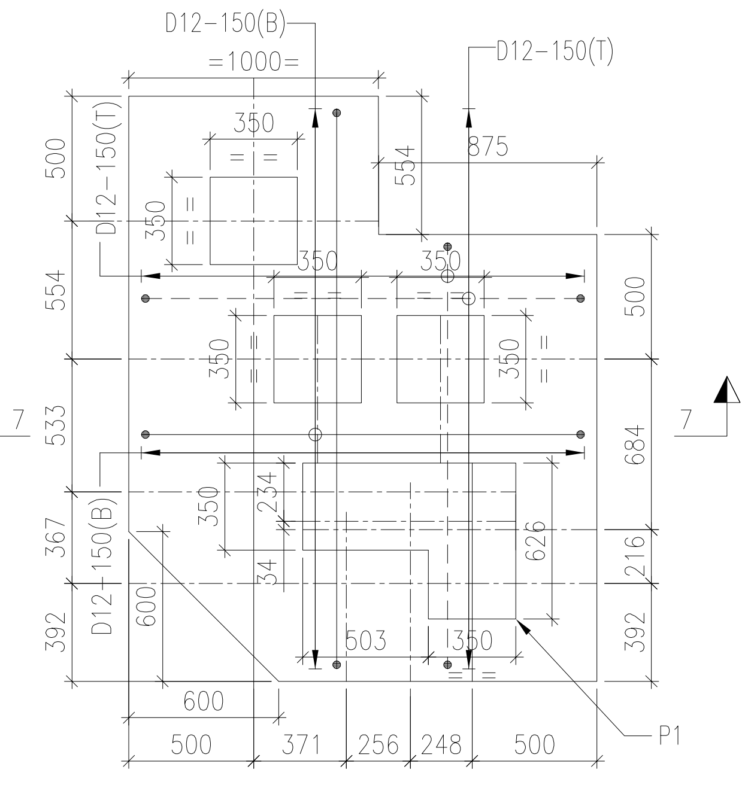

DETAIL OF FDN. MKD. CF3
(SCALE 1:30)

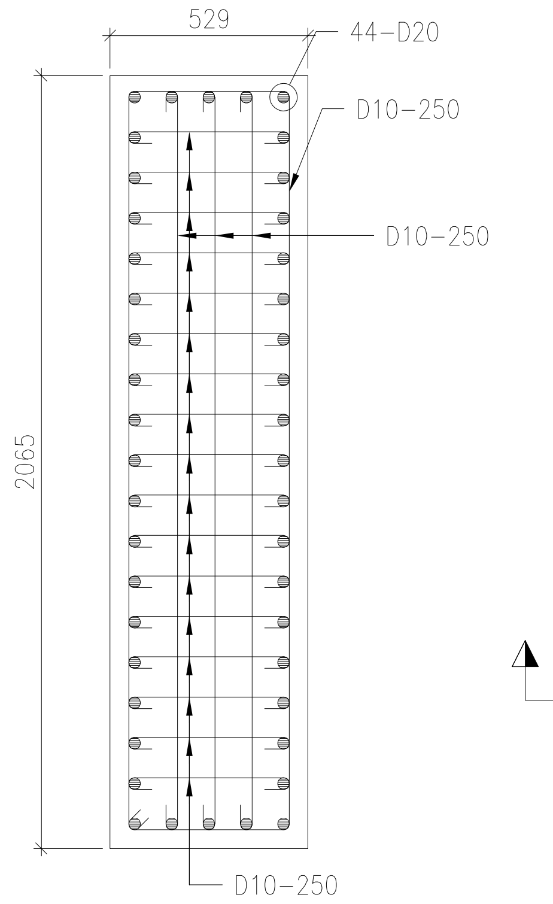

SECTION 3A-3A
(SCALE 1:20)

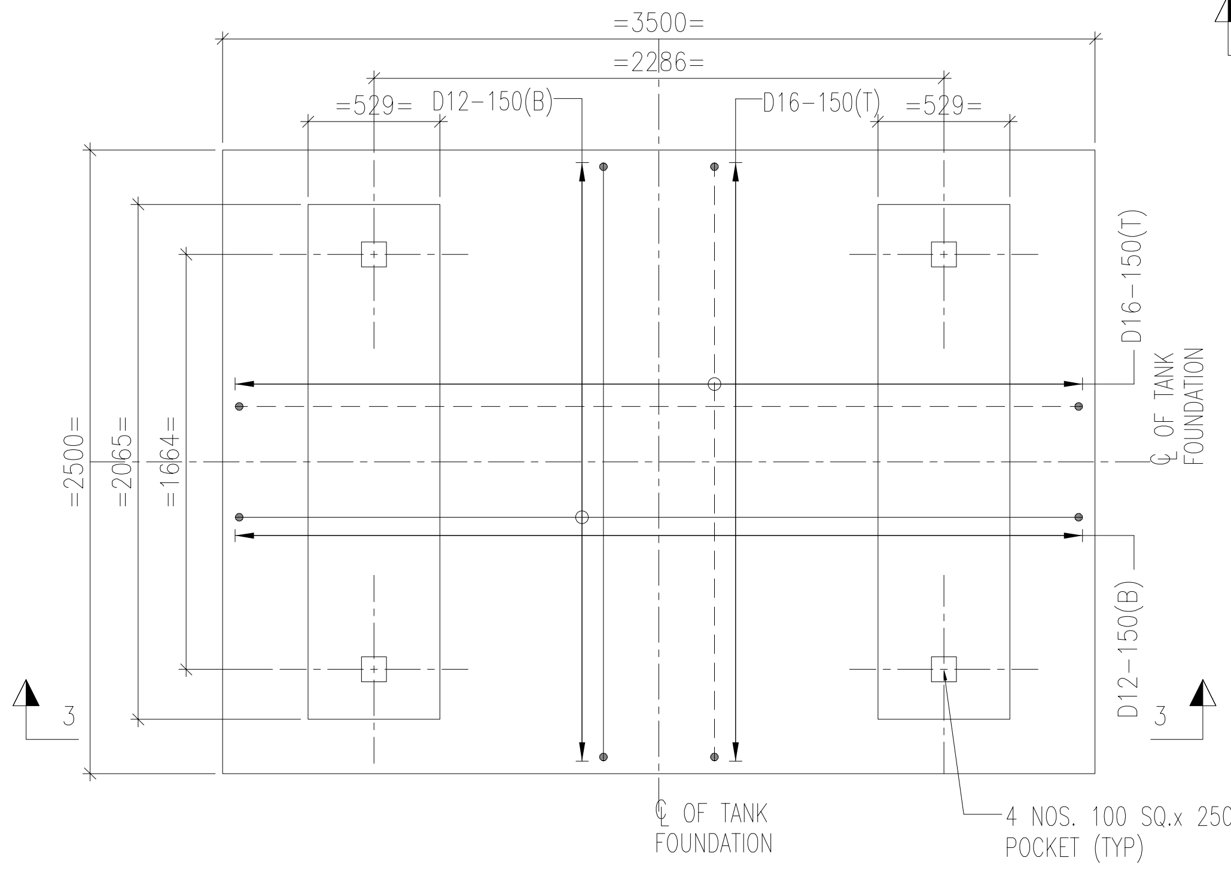

DETAIL OF FDN. FOR TANK
(SCALE 1:30)

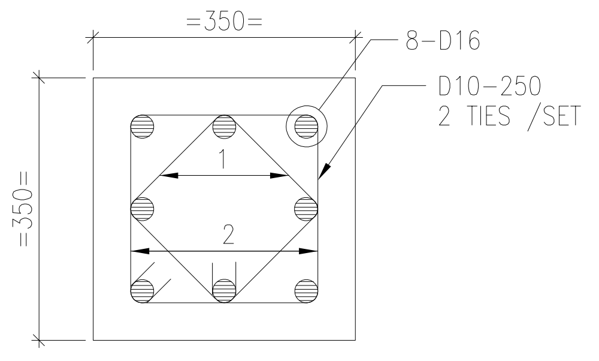

SECTION 5A-5A
(SCALE 1:10)

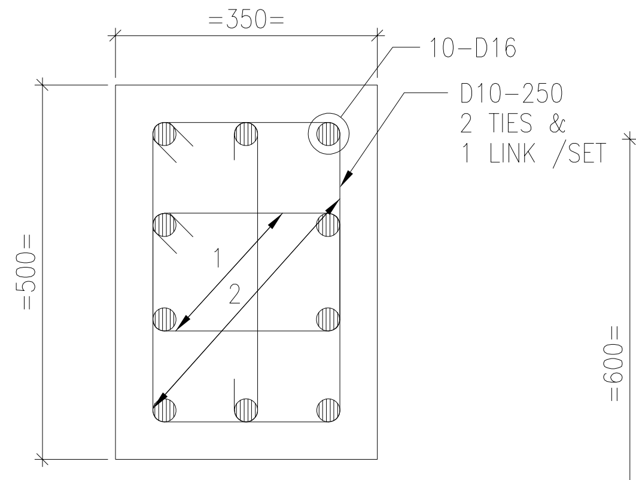

SECTION 8A-8A
(SCALE 1:10)

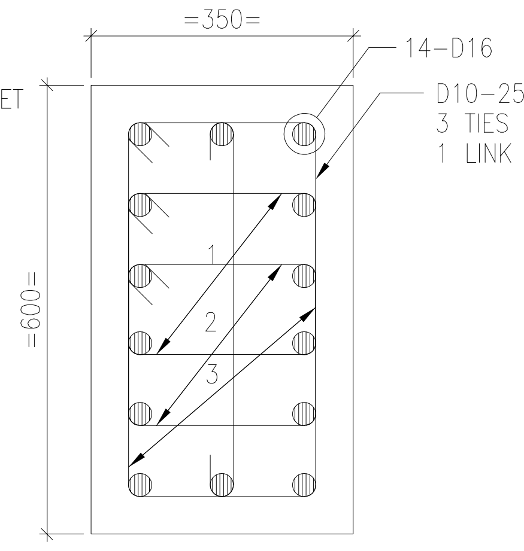

SECTION 9A-9A
(SCALE 1:10)

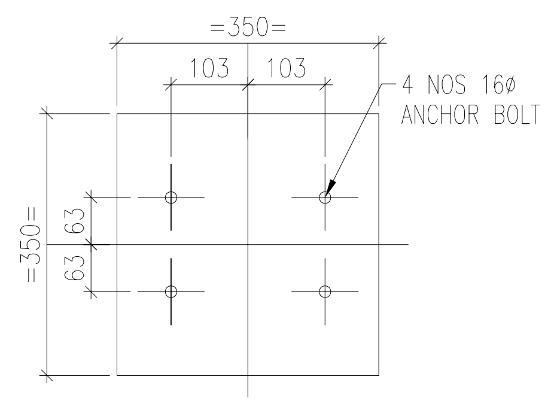

VIEW 5B-5B
(SCALE 1:10)

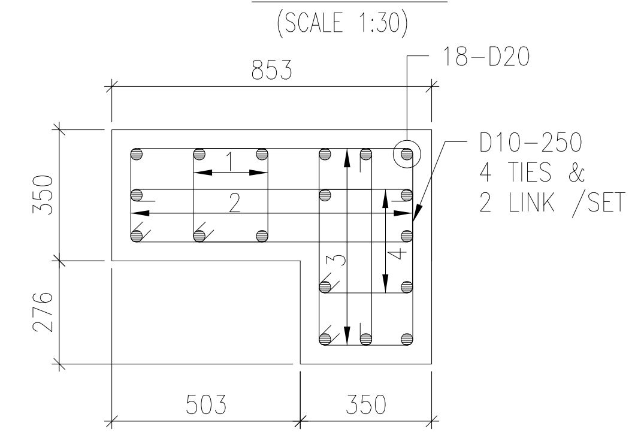

REINF. DET. OF P1
(SCALE 1:20)

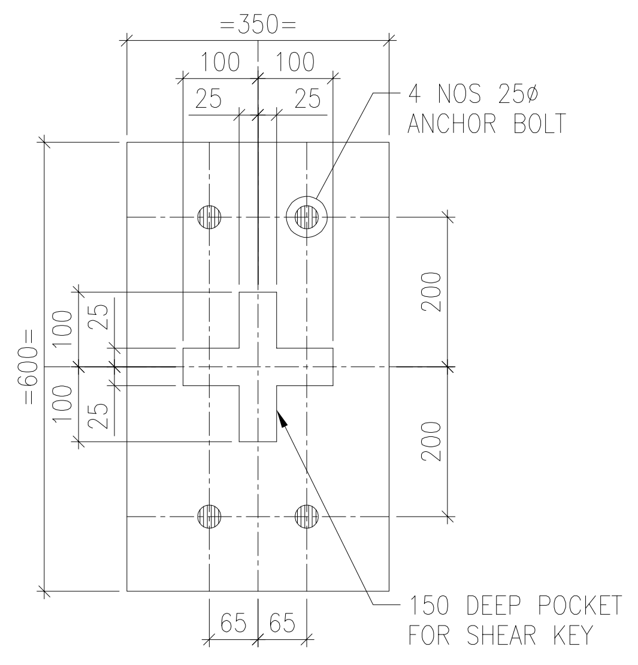

SECTION 9B-9B
(SCALE 1:10)

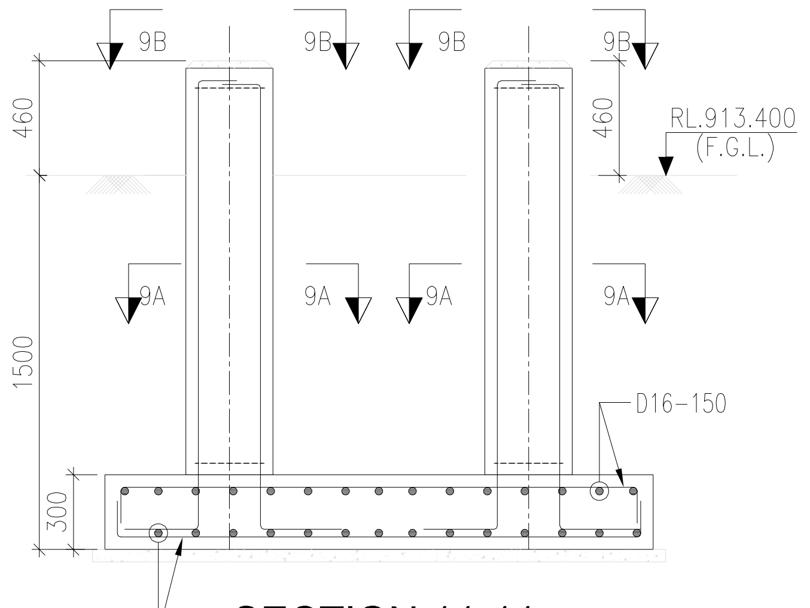

SECTION 11-11
(SCALE 1:30)

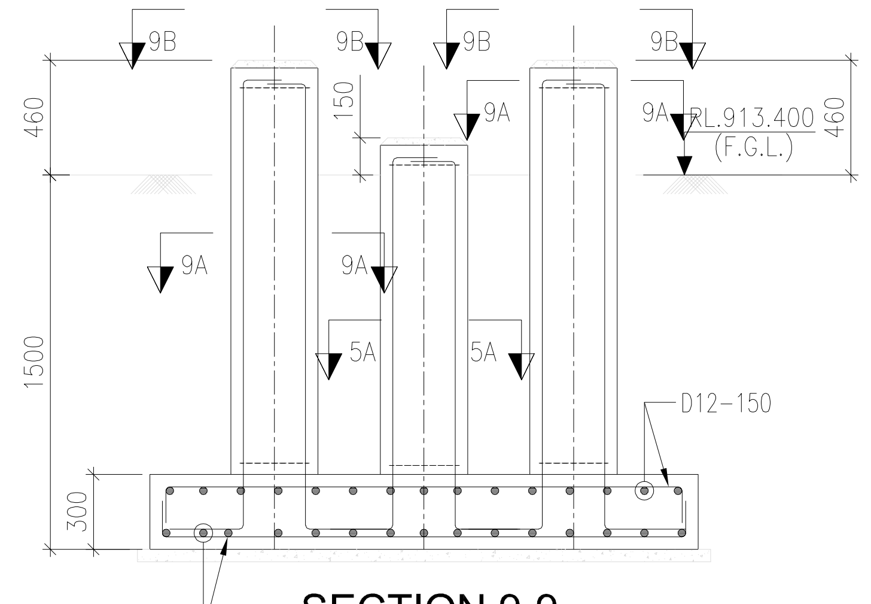

SECTION 9-9
(SCALE 1:30)

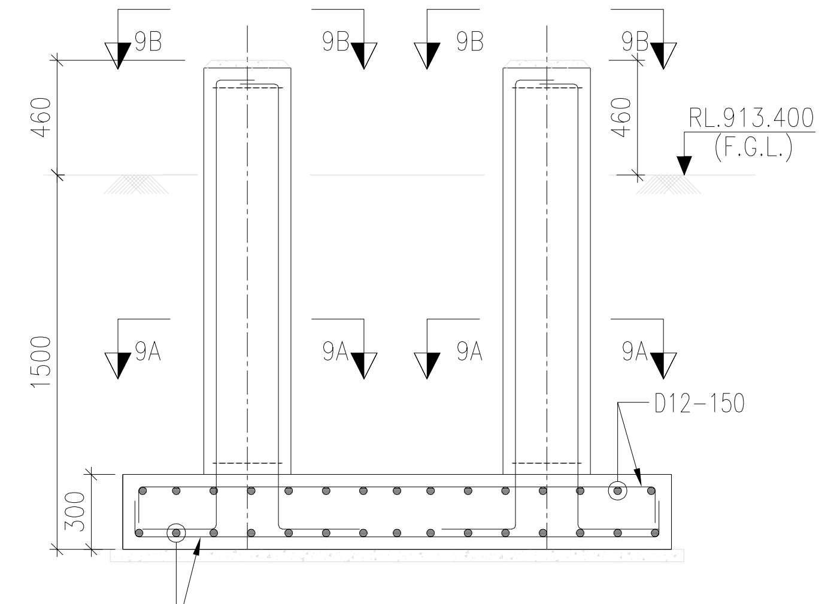

SECTION 10-10
(SCALE 1:30)

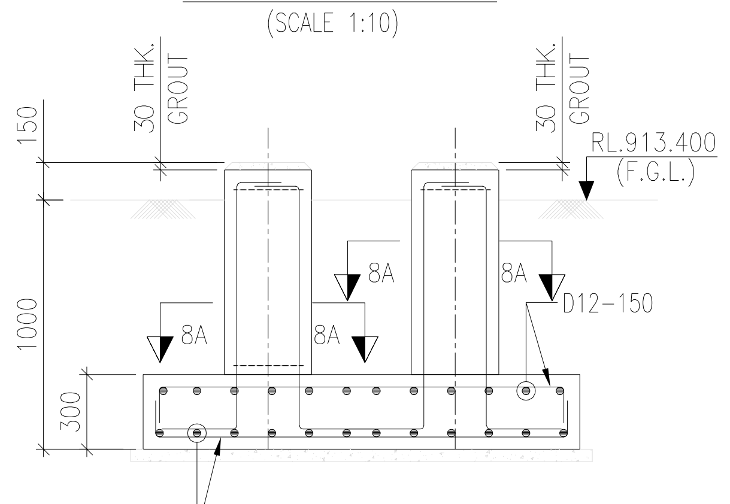

SECTION 8-8
(SCALE 1:30)

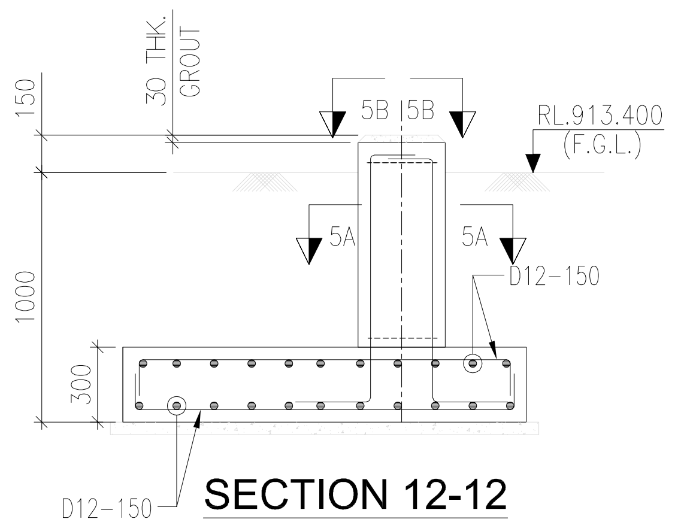

SECTION 12-12
(SCALE 1:30)

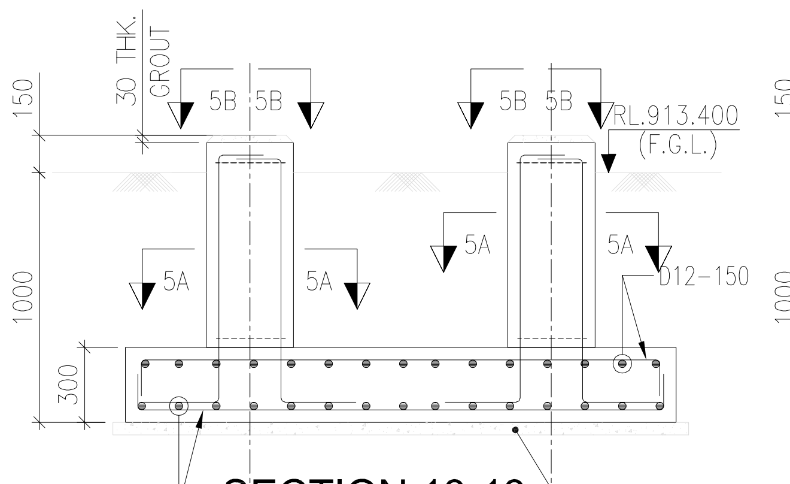

SECTION 13-13
(SCALE 1:30)

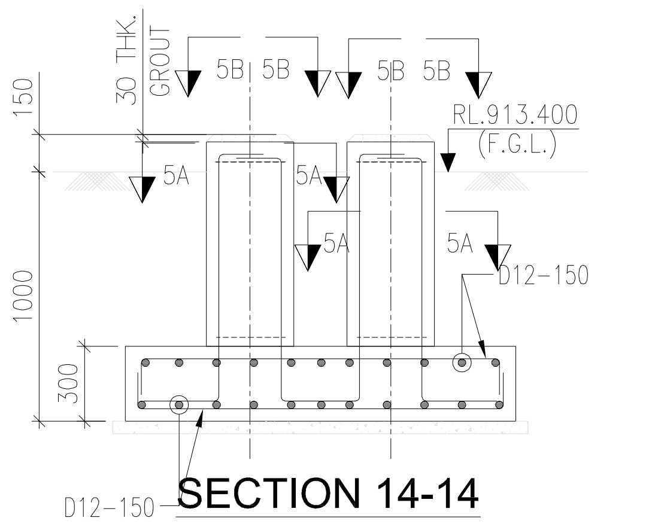

SECTION 14-14
(SCALE 1:30)

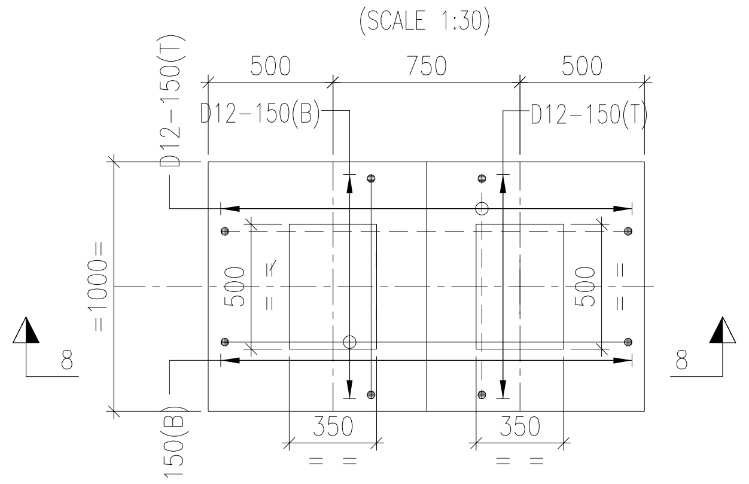

DETAIL OF FDN. MKD. CF4
(SCALE 1:30)

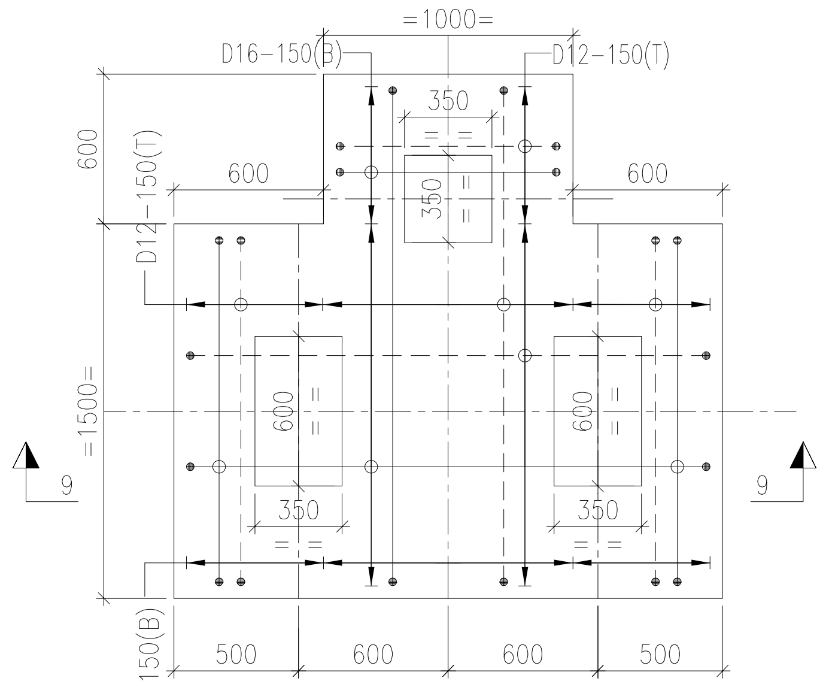

DETAIL OF FDN. MKD. CF5
(SCALE 1:30)

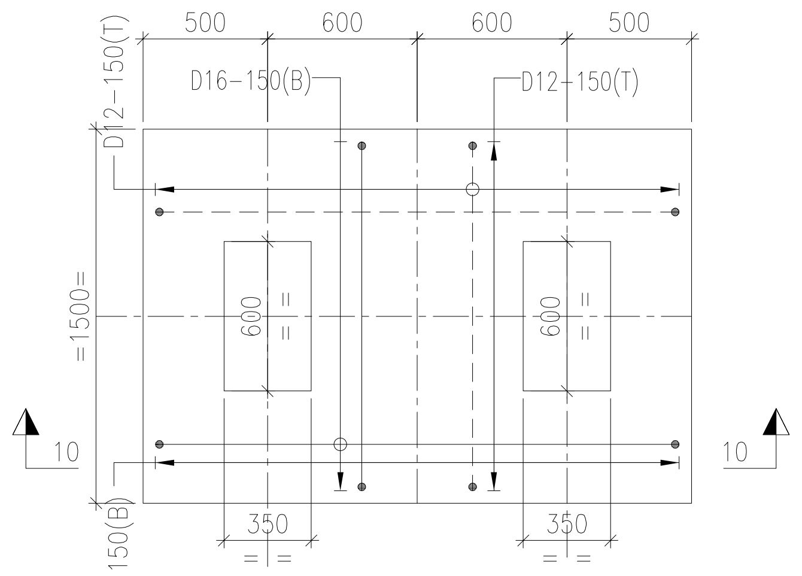

DETAIL OF FDN. MKD. CF6
(SCALE 1:30)

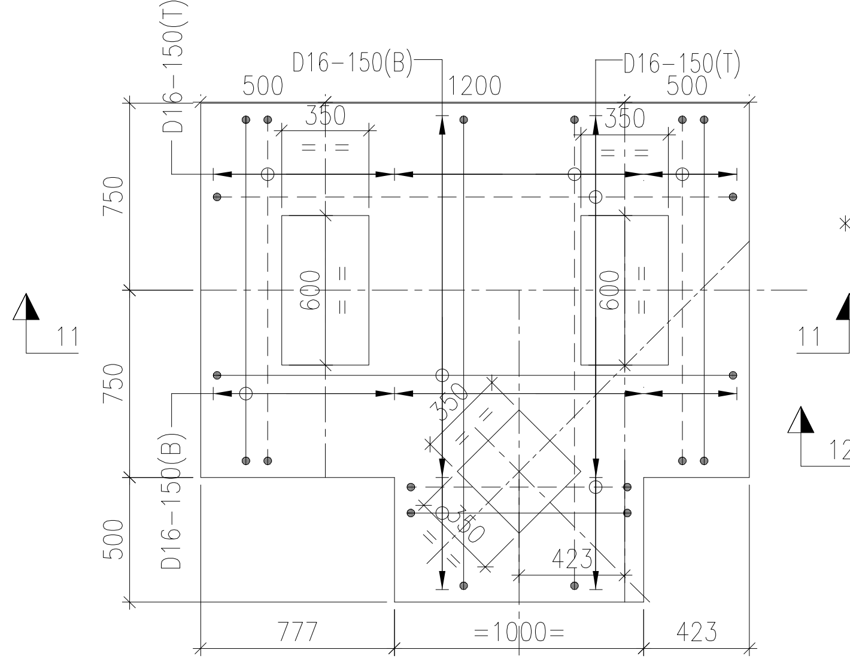

DETAIL OF FDN. MKD. CF7
(SCALE 1:30)

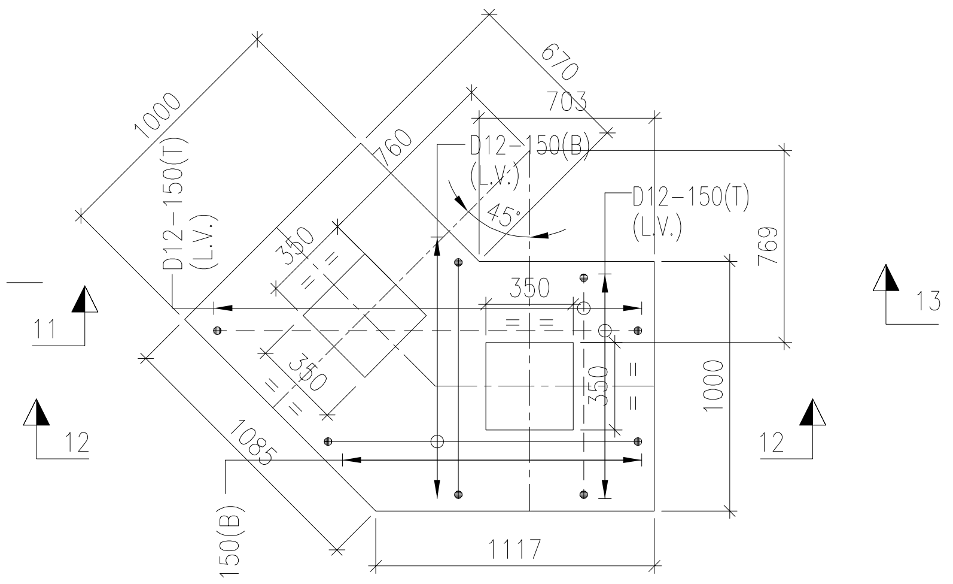

DETAIL OF FDN. MKD. CF8
(SCALE 1:30)

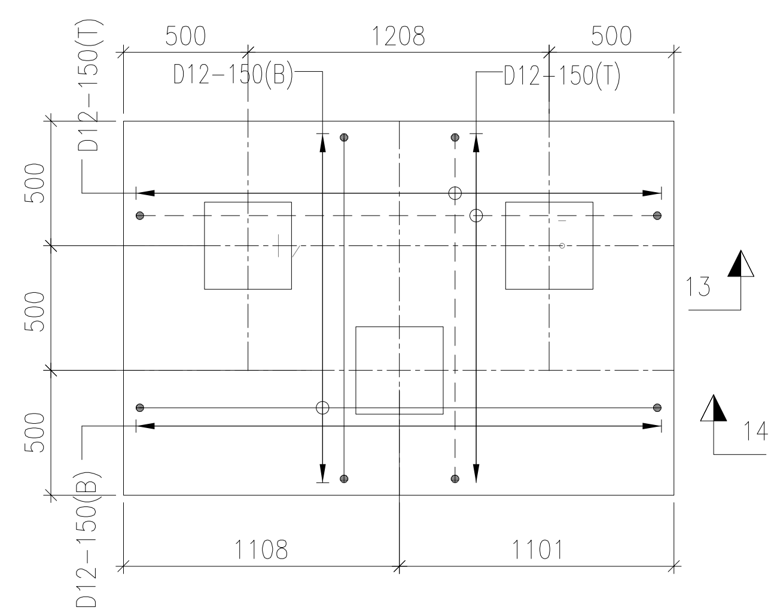

DETAIL OF FDN. MKD. CF9
(SCALE 1:30)

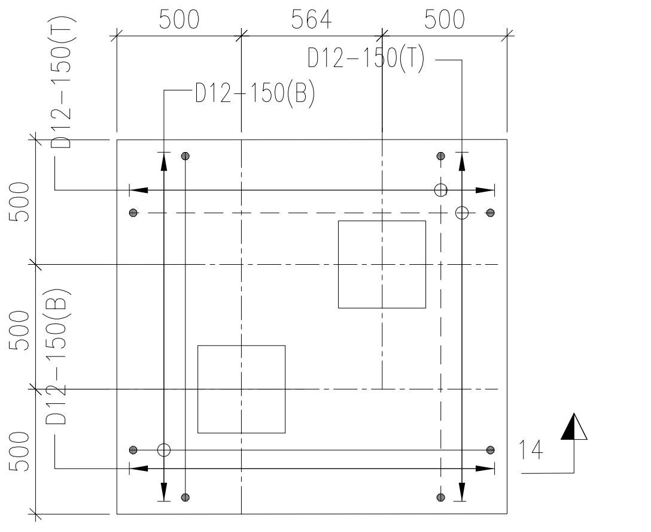

DETAIL OF FDN. MKD. CF10
(SCALE 1:30)

NOTES:-

1. ALL DIMENSIONS ARE IN MILLIMETRES AND LEVELS AND CO-ORDINATES ARE IN METRES UNLESS OTHERWISE STATED.
2. FOR ALL OTHER NOTES REFER DRAWING NO-MD-216-2500-EG-CV-GAD-2032

		D01	05/10/2023	AS BUILT	SC	TG	SNM	SJM	
		C02	29/05/2021	ISSUED FOR CONSTRUCTION REVISED AS MKD. C02	SC	TG	SNM	SJM	
MD-216-3310-EG-ME-GAD-1055	GENERAL LAYOUT-EXPLOSIVE MAGAZINE	C01	07/01/2021	ISSUED FOR CONSTRUCTION	SC	TG	SNM	SJM	
MD-216-3310-EG-CV-GAD-1177	EXPLOSIVE MAGAZINE LAYOUT	A01	05/12/2020	ISSUED FOR APPROVAL	SC	TG	SNM	SJM	
DOCUMENT NUMBER	REFERENCE DOCUMENTS	REV	DATE	REVISION DESCRIPTION	DRN	CHK	ENG	APP	EMP

RESERVED FOR VENDOR LOGO AND DRAWING NUMBER

LARSEN & TOUBRO

This drawing is the property of LARSEN & TOUBRO and must not be passed on to any person or body not authorized by us to receive it nor be copied or otherwise made use either in full or in part by such person or body without our prior permission in writing.

Outotec

The content of these documents are the sole property of Outotec Oyj. Any rights not expressly granted herein are reserved. Reproduction, transfer or distribution of part or all of the contents in any form without prior written permission of Outotec is prohibited.

MA'ADEN معادن
Saudi Arabian Mining Company شركة التعدين العربية السعودية

This document and the information contained herein is Ma'aden proprietary know-how. This document or any part thereof should not be reproduced, stored in a retrieval system or transmitted by any means, electronic or otherwise, or divulged without prior written permission of Ma'aden.

LARSEN & TOUBRO DRAWING NUMBER		REVISION
019045_900_C_G_24461_001		3
OUTOTEC DRAWING NUMBER	**DOCUMENT ID**	**REVISION**
900707 __GAU01 __ZZ01 __MTL01 __25100	0U100706723	3

DRAWN	SC	04/12/2020
CHECKED	TG	05/12/2020
ENGINEER	SNM	01/12/2020
APPROVED	SJM	05/12/2020
EMPLOYER		
SCALE	1:20, 1:50, 1:150	A1

MANSOURAH - MASSARAH GOLD PROJECT
GENERAL ARRANGEMENT
EXPLOSIVE MAGAZINE
GA AND DETAILS OF OF FUEL AREA FOUNDATIONS

DRAWING NUMBER
MD - 216 - 2500 - EG- CV - GAD - 2033
REV
D01