


DRAWING NUMBER: MD-216-2500-EG-CV-GAD-2034
REV: D01

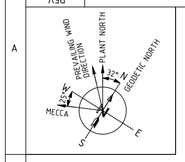

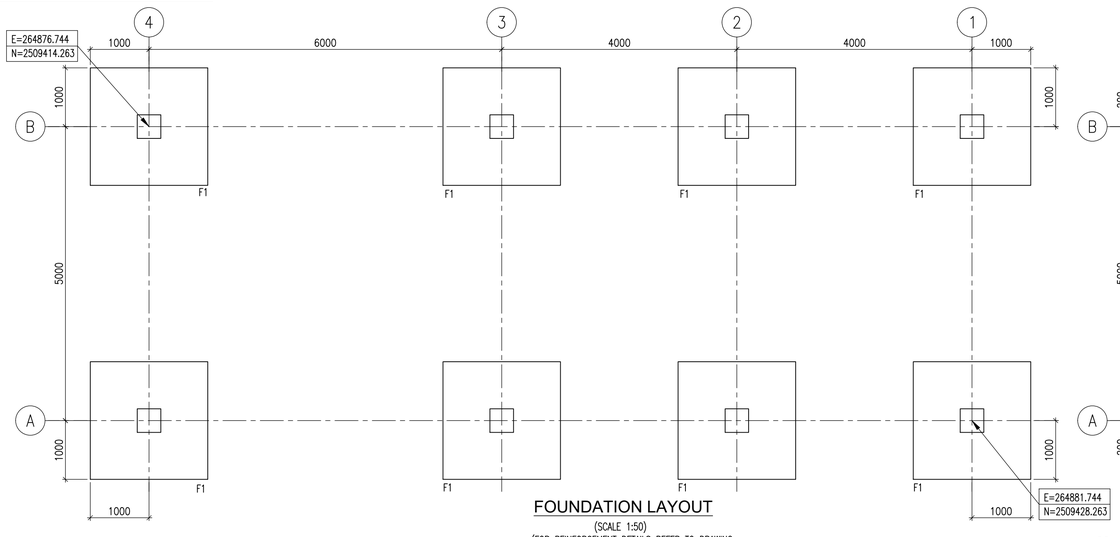


FOUNDATION LAYOUT

(SCALE 1:50)
(FOR REINFORCEMENT DETAILS REFER TO DRAWING NUMBER MD-216-2500-EG-CV-GAD-2035)

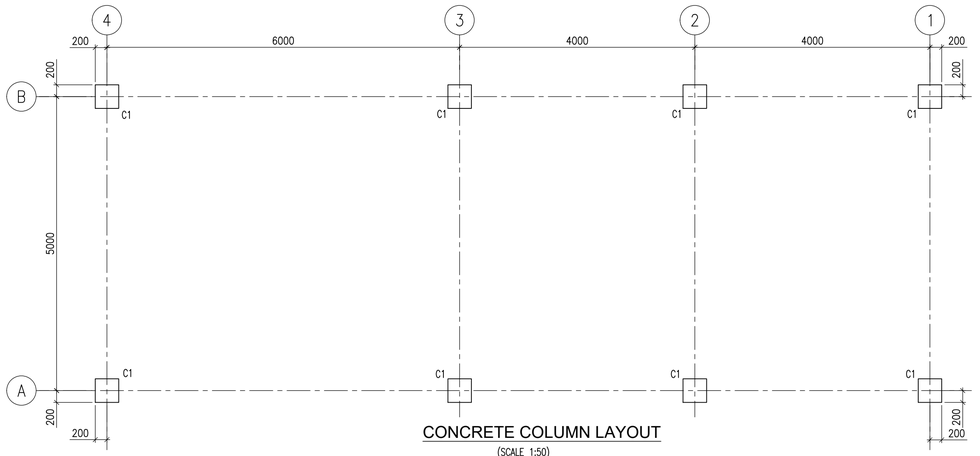


CONCRETE COLUMN LAYOUT

(SCALE 1:50)
(FOR REINFORCEMENT DETAILS REFER TO DRAWING NUMBER MD-216-2500-EG-CV-GAD-2035)

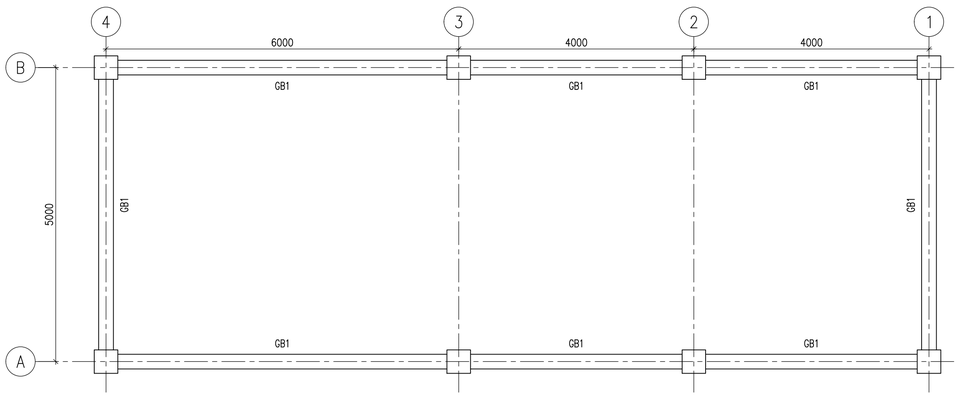


GRADE BEAM LAYOUT

(SCALE 1:50)
(FOR REINFORCEMENT DETAILS REFER TO DRAWING NUMBER MD-216-2500-EG-CV-GAD-2035)

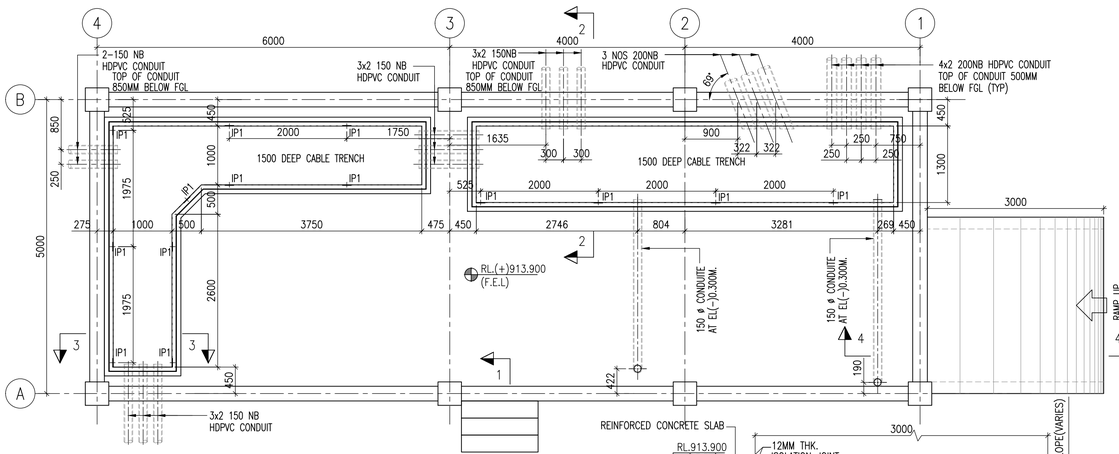


GROUND FLOOR LAYOUT

(SCALE 1:50)

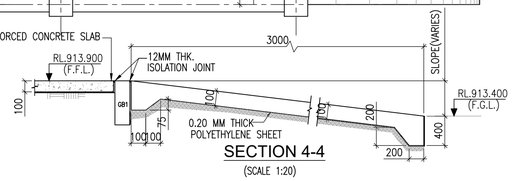

SECTION 4-4

(SCALE 1:20)

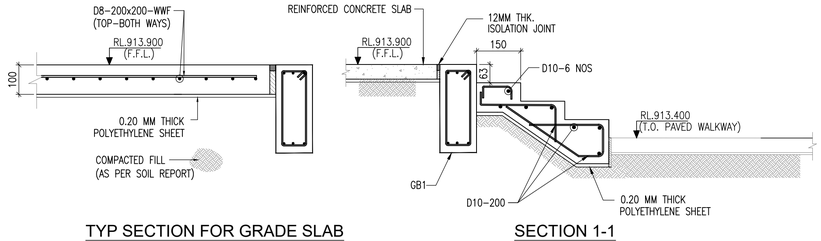


TYP SECTION FOR GRADE SLAB

(SCALE 1:10)


SECTION 1-1

(SCALE 1:10)

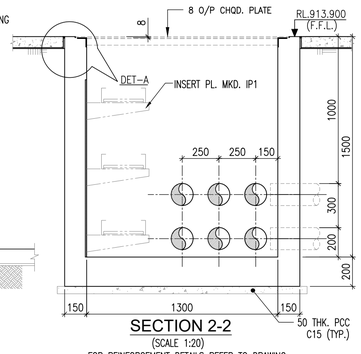


SECTION 2-2

(SCALE 1:20)
FOR REINFORCEMENT DETAILS REFER TO DRAWING NUMBER MD-216-2500-EG-CV-GAD-2035

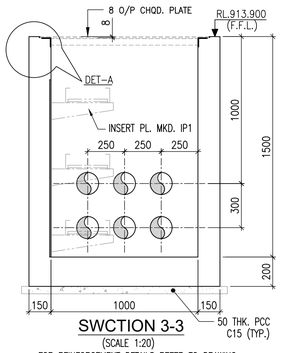

SWCTION 3-3

(SCALE 1:20)
FOR REINFORCEMENT DETAILS REFER TO DRAWING NUMBER MD-216-2500-EG-CV-GAD-2035

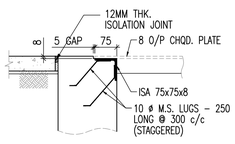

DETAIL-A

(SCALE 1:10)

LEGEND :-

R.L. – REDUCED LEVEL
℄ – CENTRE LINE
T.O.C. – TOP OF CONCRETE
TYP. – TYPICAL
F.G.L. – FINISHED GROUND LEVEL
F.F.L. – FINISHED FLOOR LEVEL
B.O.F. – BOTTOM OF FOUNDATION
MKD. – MARKED
P.C.C – PLAIN CEMENT CONCRETE
DET. – DETAIL
BOTTOM REINFORCEMENT (B) – – – – – – –
TOP REINFORCEMENT (T) – ————
SQ. – SQUARE
R.C. – REINFORCED CONCRETE
FDN. – FOUNDATION
THK. – THICK

NOTES:-

1. ALL DIMENSIONS ARE IN MILLIMETRES AND LEVELS AND CO-ORDINATES ARE IN METRES UNLESS OTHERWISE STATED.
2. NET SAFE BEARING CAPACITY OF SOIL AT BOTTOM OF FOUNDATION CONSIDER 450KN/ SQ. M
3. GRADE OF CONCRETE SHALL BE C35 (35MPa) FOR FOUNDATION & C15 (15MPa) FOR BLINDING CONCRETE.
4. GRADE OF REINFORCEMENT SHALL BE DEFORMED BAR 420 MPa (GRADE 60) – ASTM A615/A615M.
5. IF ANY PART OF FOUNDATION COMES ON BACKFILL ZONE OF ADJACENT FOUNDATION OR ANY LOOSE SOIL ARE ENCOUNTERED BELOW FOUNDATION LEVEL THE SAME SHALL BE REMOVED AND FILLED WITH PCC (C15).
6. CLEAR COVER TO REINFORCEMENT SHALL BE
   a. FOUNDATIONS = 50 MM., b. COLUMNS = 50 MM.
7. FOR STANDARD REINFORCEMENT DETAIL & GENERAL NOTES FOR CIVIL WORKS REFER DRAWING NO. MD-216-1000-EG-CV-DED-1005 & 1001.
8. THIS DRAWING SHALL BE READ IN CONJUNCTION WITH DRAWING NO. MD-216-2500-EG-CV-GAD-2035

DOCUMENT NUMBER	REFERENCE DOCUMENTS	REV	DATE	REVISION DESCRIPTION	DRN	CHK	ENG	APP	EMP
MD-216-2500-EG-CV-GAD-2035	EXPLOSIVE MAGAZINEFOUNDATION DET. OF ELECTRICAL ROOM								
MD-216-2500-EG-EL-LAD-2013	EXPLOSIVE MAGAZINE CABLE ROUTE LAYOUT	D01	13/06/2023	AS-BUILT	SC	TG	SNM	SJM	
MD-216-2500-EG-EL-LAD-2012	EXPLOSIVE MAGAZINE CABLE ROUTE LAYOUT	C02	08/10/2021	ISSUED FOR CONSTRUCTION AND REVISED AS MKD. C01	SC	TG	SNM	SJM	
MD-216-3310-EG-ME-GAD-1055	GENERAL LAYOUT-EXPLOSIVE MAGAZINE	C01	30/04/2021	ISSUED FOR CONSTRUCTION AND REVISED AS MKD. C01	SC	TG	SNM	SJM	
MD-216-3310-EG-CV-GAD-1177	EXPLOSIVE MAGAZINE LAYOUT	A01	11/03/2021	ISSUED FOR REVIEW	SC	TG	SNM	SJM	

RESERVED FOR VENDOR LOGO AND DRAWING NUMBER

LARSEN & TOUBRO

This drawing is the property of LARSEN & TOUBRO and must not be passed on to any person or body not authorized by us to receive it nor be copied or otherwise made use either in full or in part by such person or body without our prior permission in writing.

Outotec

The content of these documents are the sole property of Outotec Oyj. Any rights not expressly granted herein are reserved. Reproduction, transfer or distribution of part or all of the contents in any form without prior written permission of Outotec is prohibited.

MA'ADEN معادن
Saudi Arabian Mining Company شركة المعادن العربية السعودية

This document and the information contained herein is Ma'aden proprietary know-how. This document or any part thereof should not be reproduced, stored in a retrieval system or transmitted by any means, electronic or otherwise, or divulged without prior written permission of Ma'aden.

LARSEN & TOUBRO DRAWING NUMBER	019045_900_C_G_24644_001		REVISION 3
OUTOTEC DRAWING NUMBER	900707__GAU01__ZZ01__MTL01__25104	DOCUMENT ID 0U100717473	REVISION 3
DRAWN	SC	08/03/2021	MANSOURAH - MASSARAH GOLD PROJECT
CHECKED	TG	10/03/2021	GENERAL ARRANGEMENT DRAWING
ENGINEER	SNM	08/03/2021	EXPLOSIVE MAGAZINE
APPROVED	SJM	11/03/2021	FOUNDATION LAYOUT & DET. OF ELECTRICAL ROOM
EMPLOYER			
SCALE	1:20, 1:50, 1:10	A1	DRAWING NUMBER MD-216-2500-EG-CV-GAD-2034 REV D01