

DRAWING NUMBER MD-216-2500-EG-CV-LAD-2001 REV D01

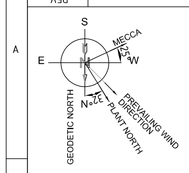

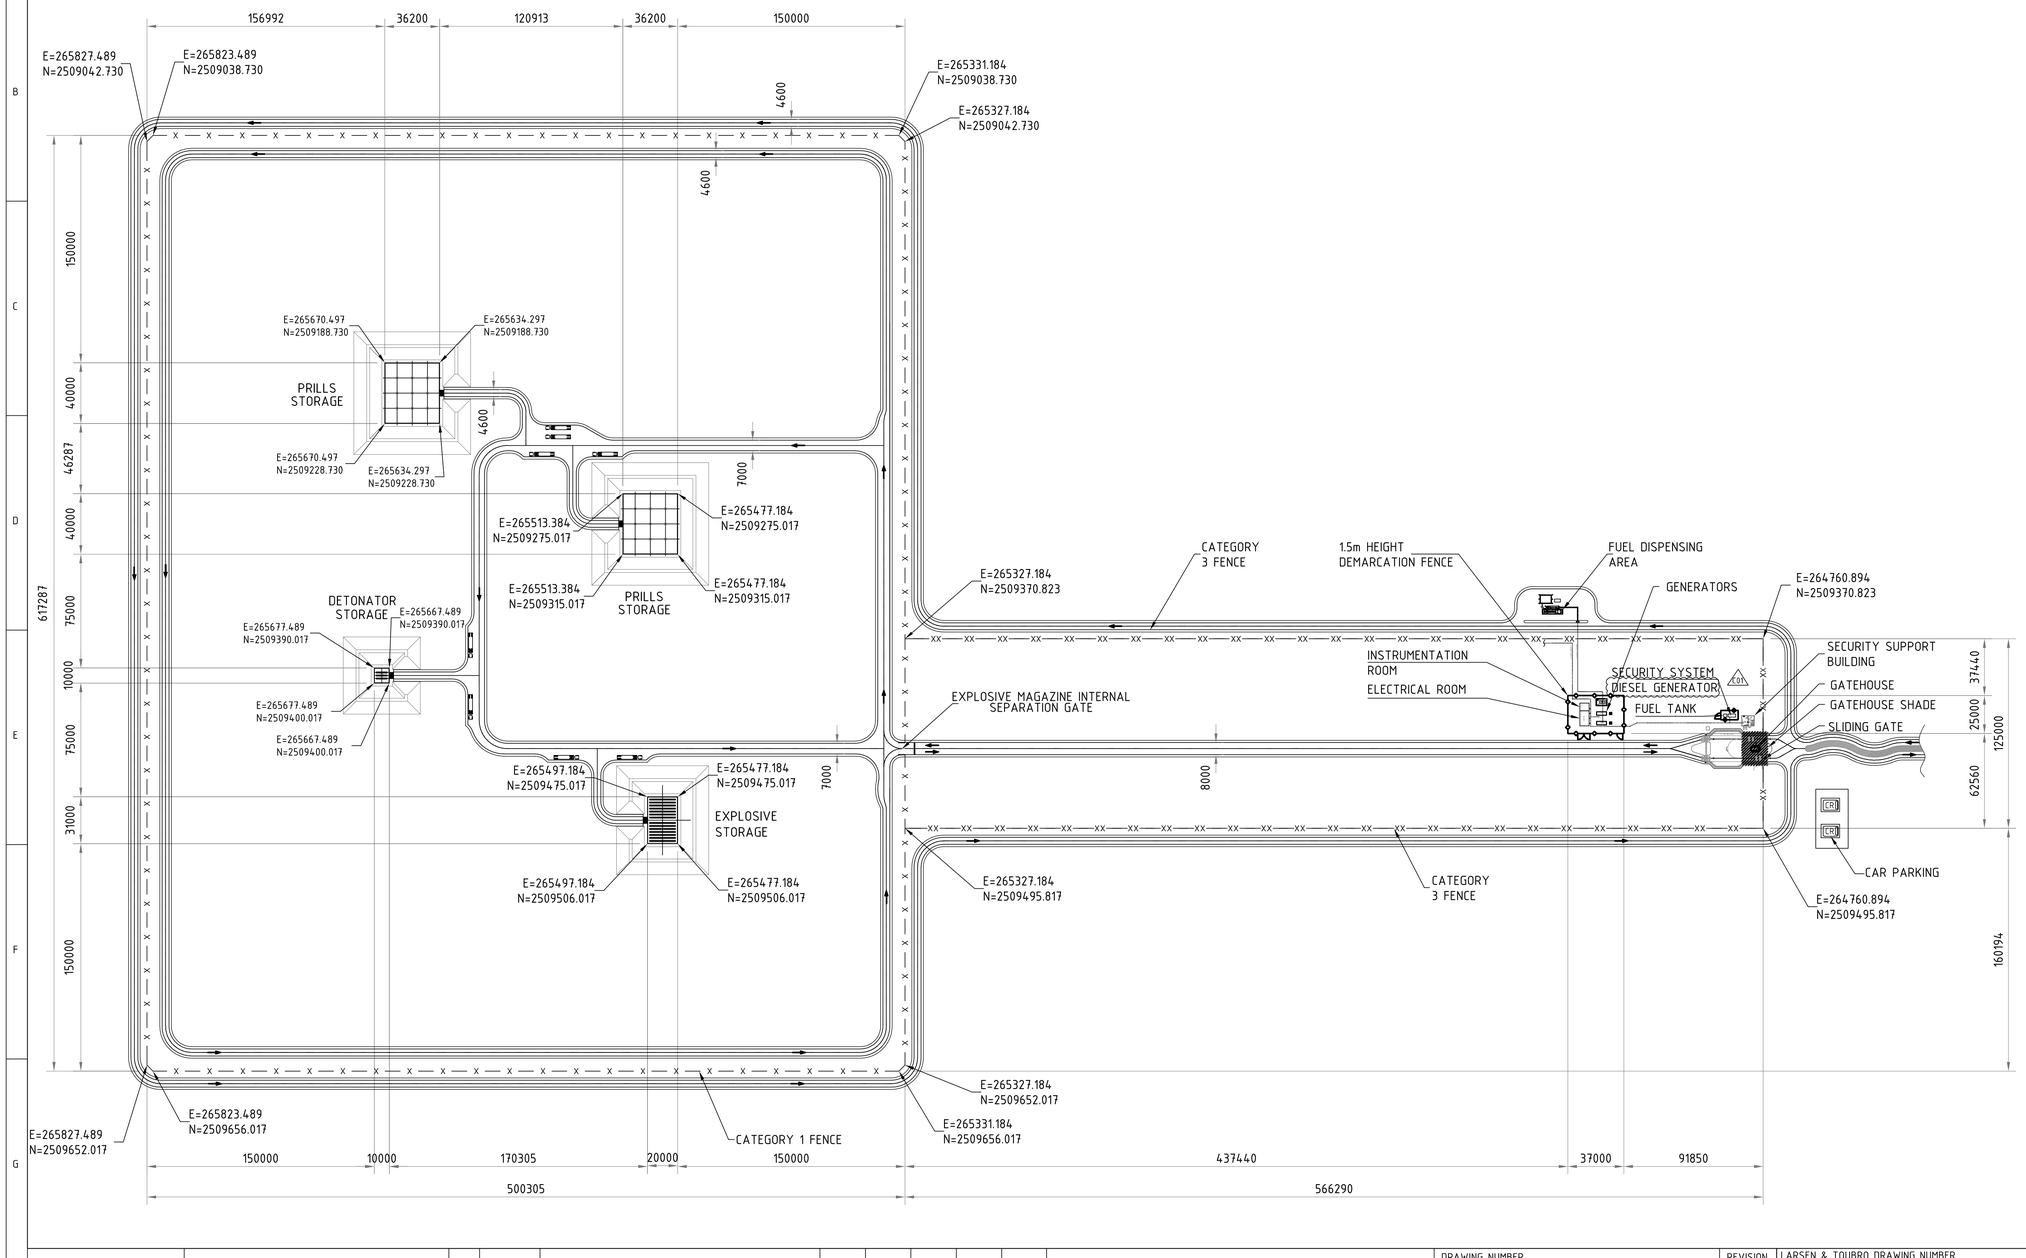

NOTE:

1. ALL DIMENSIONS ARE IN MILLIMETER UNLESS OTHERWISE SPECIFIED.
2. CLASS I FENCE GATE IS MANUAL SWING GATE WITH MANUAL SECURE LOCKING MECHANISM AS PER HCIS STANDARDS SEC 09


C01

LEGEND:

— x — x — CATEGORY 1 FENCE

—xx—xx— CATEGORY 3 FENCE

KEY PLAN

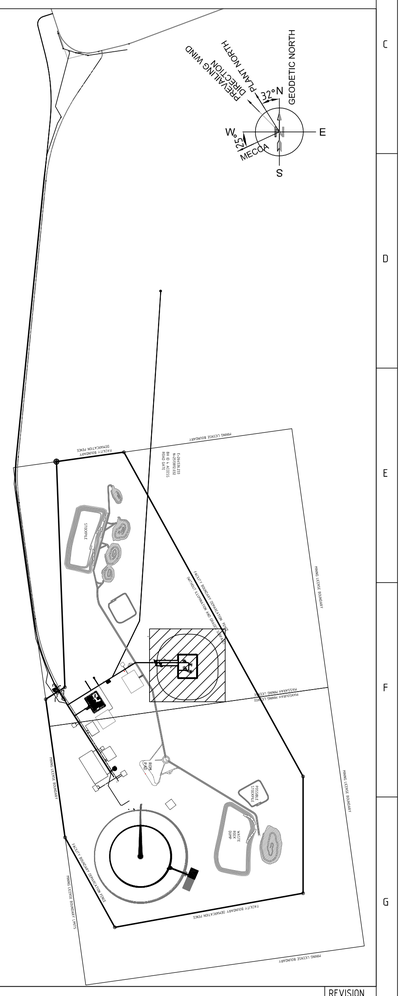

REV	DATE	REVISION DESCRIPTION	DRN	CHK	ENG	APP	EMP
D01	11/10/2023	AS BUILT		SNM		SJM	
C01	08/11/2020	ISSUED FOR CONSTRUCTION & REVISED AS MKD C01	--	SNM	--	SJM	
A02	09/10/2020	REVISED AS PER EMPLOYER COMMENTS ON 11/08/2020	--	SNM	--	SJM	
A01	10/07/2020	ISSUED FOR APPROVAL	--	SNM	--	SJM	

DOCUMENT NUMBER | REFERENCE DOCUMENTS

DVACON

LARSEN & TOUBRO

This drawing is the property of LARSEN & TOUBRO and must not be passed on to any person or body not authorized by us to receive it nor be copied or otherwise made use either in full or in part by such person or body without our prior permission in writing.

Outotec

The content of these documents are the sole property of Outotec Oyj. Any rights not expressly granted herein are reserved. Reproduction, transfer or distribution of part or all of the contents in any form without prior written permission of Outotec is prohibited.

MA'ADEN معادن Saudi Arabian Mining Company شركة التعدين العربية السعودية

This document and the information contained herein is Ma'aden proprietary know-how. This document or any part thereof should not be reproduced, stored in a retrieval system or transmitted by any means, electronic or otherwise, or divulged without prior written permission of Ma'aden.

DRAWING NUMBER MD-216-1800-EG-CV-DLA-1001 | REVISION C01

DATE	05/11/2020	DATE	07/11/2020	DATE	08/11/2020
DRAWN	ABDUL	CHECKED	LARA	APPROVED	IHAB

LARSEN & TOUBRO DRAWING NUMBER O19045_900_C_D_24483_001 | REVISION 3

OUTOTEC DRAWING NUMBER 900707__GAU01__ZZ01__CLD01__25001 | DOCUMENT ID OU100690692 | REVISION 3

DRAWN	--	--
CHECKED	SNM	09/07/2020
ENGINEER	--	--
APPROVED	SJM	10/07/2020
EMPLOYER		
SCALE	1:2	A1

MANSOURAH - MASSARAH GOLD PROJECT
LAYOUT
EXPLOSIVE MAGAZINE
GENERAL LAYOUT - EXPLOSIVE MAGAZINE

DRAWING NUMBER MD-216-2500-EG-CV-LAD-2001 | REV D01

Mansourah Massarah Gold Project
Comment Resolution Log Sheet / Compliance Report

PROJECT: MANSOURAH MASSARAH GOLD PROJECT **PROJECT NO.:** 216

STAGE: 4 - PROJECT EXECUTION. **REVIEW LOG DOC. NO. & REV.:**

ACONEX REF. NO. & DATE: BECHTEL-WTRAN-005885, 28 October 2020

STATUS CODE: A - APPROVED, C - APPROVED WITH COMMENTS, R - REVISE & RESUBMIT & O - OTHERS (INFORMATION, REFERENCE, REVIEWED)

DOCUMENT NUMBER	Area / Title	Comment No.	PMC/PMT COMMENT DATE: 28 October 2020	Comment by	EPC Response DATE: 10 November 2020	Status	Remarks
			General Comments (cc)				
MD-216-2500-EG-CV-LAD-2001-RA02	2500	1	This shall be considered to describe the type of gate: 5.4.11.Locks used on this gate shall be fully compliant with SEC 09. 5.4.12.The gate shall use either a motorised sliding or swing mechanism for deployment	Mr. Doron Golan (BECHTEL)	Explosive Magazine internal separation gate is manually operated according to HCIS approved stage -02 FEED. Please refer to Stage-3 installation details under layout number MD-216-1800-HS-SY-GAD-V516-1625-A02 (Sheet #6) where contains PAD lock detail to comply SEC-9.	Closed	
MD-216-2500-EG-CV-LAD-2001-RA02	2500	2	What security system "DG" means?, use HCIS terminology	Mr. Doron Golan (BECHTEL)	Emergency Power Diesel Generator (DG) is required for security system and devices, Security lighting, Security building HVAC system to comply SEC-7 (5.2).	Closed	

MA'ADEN معادن
Saudi Arabian Mining Company شركة التعدين العربية السعودية

BECHTEL

Mansourah Massarah Gold Project
Comment Resolution Log Sheet / Compliance Report

Outotec
LARSEN & TOUBRO

PROJECT: MANSOURAH MASSARAH GOLD PROJECT **PROJECT NO.: 216**

STAGE: 4 - PROJECT EXECUTION. **REVIEW LOG DOC. NO. & REV.:**

ACONEX REF. NO. & DATE: BECHTEL-WTRAN-004181, 11 August 2020

STATUS CODE: A - APPROVED, C - APPROVED WITH COMMENTS, R - REVISE & RESUBMIT & O - OTHERS (INFORMATION, REFERENCE, REVIEWED)

DOCUMENT NUMBER	Area / Title	Comment No.	PMC/PMT COMMENT DATE: 11 Auhust 2020	Comment by	EPC Response DATE: 8 October 2020	Status	Remarks
			General Comments (cc)				
MD-216-2500-EG-CV-LAD-2001-A01	2500	1	This drawing nees to be submitted as part of the overall HCIS security package for Approval on Aug 15 2020 as Instructed previously	Mr. Doron Golan (BECHTEL)	Resubmitted for approval as advised by employer	Closed	