


DRAWING NUMBER MD-216-2500-EG-CV-LAD-2002 REV D01

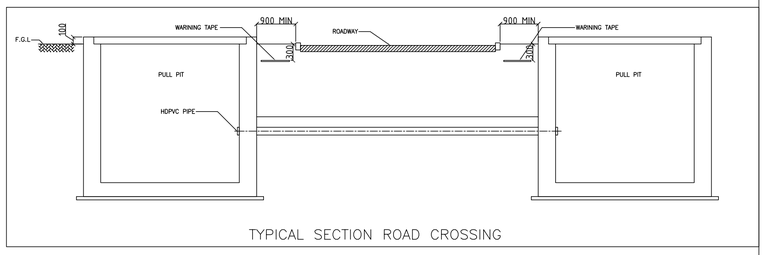


TYPICAL SECTION ROAD CROSSING

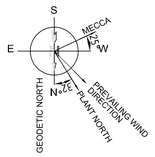

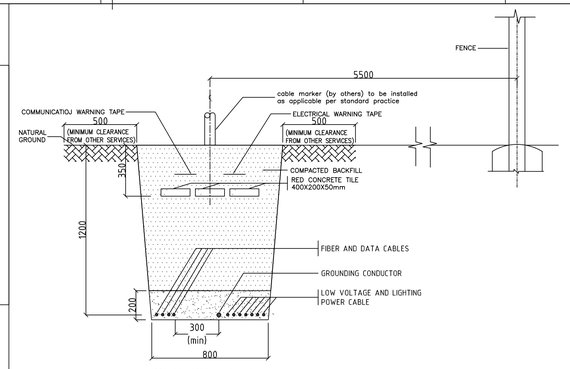


SECTION A–A
MAIN TRENCH

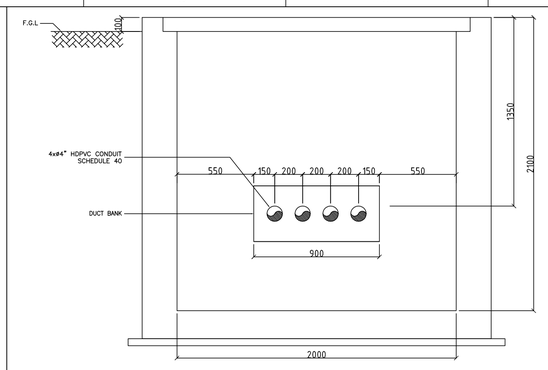


TYPICAL PULL PIT CROSS SECTION

SECTION B–B
SECONDARY TRENCH

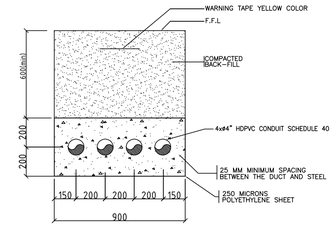

TYPICAL DUCT & FENCE
PENETRATION CROSS SECTION

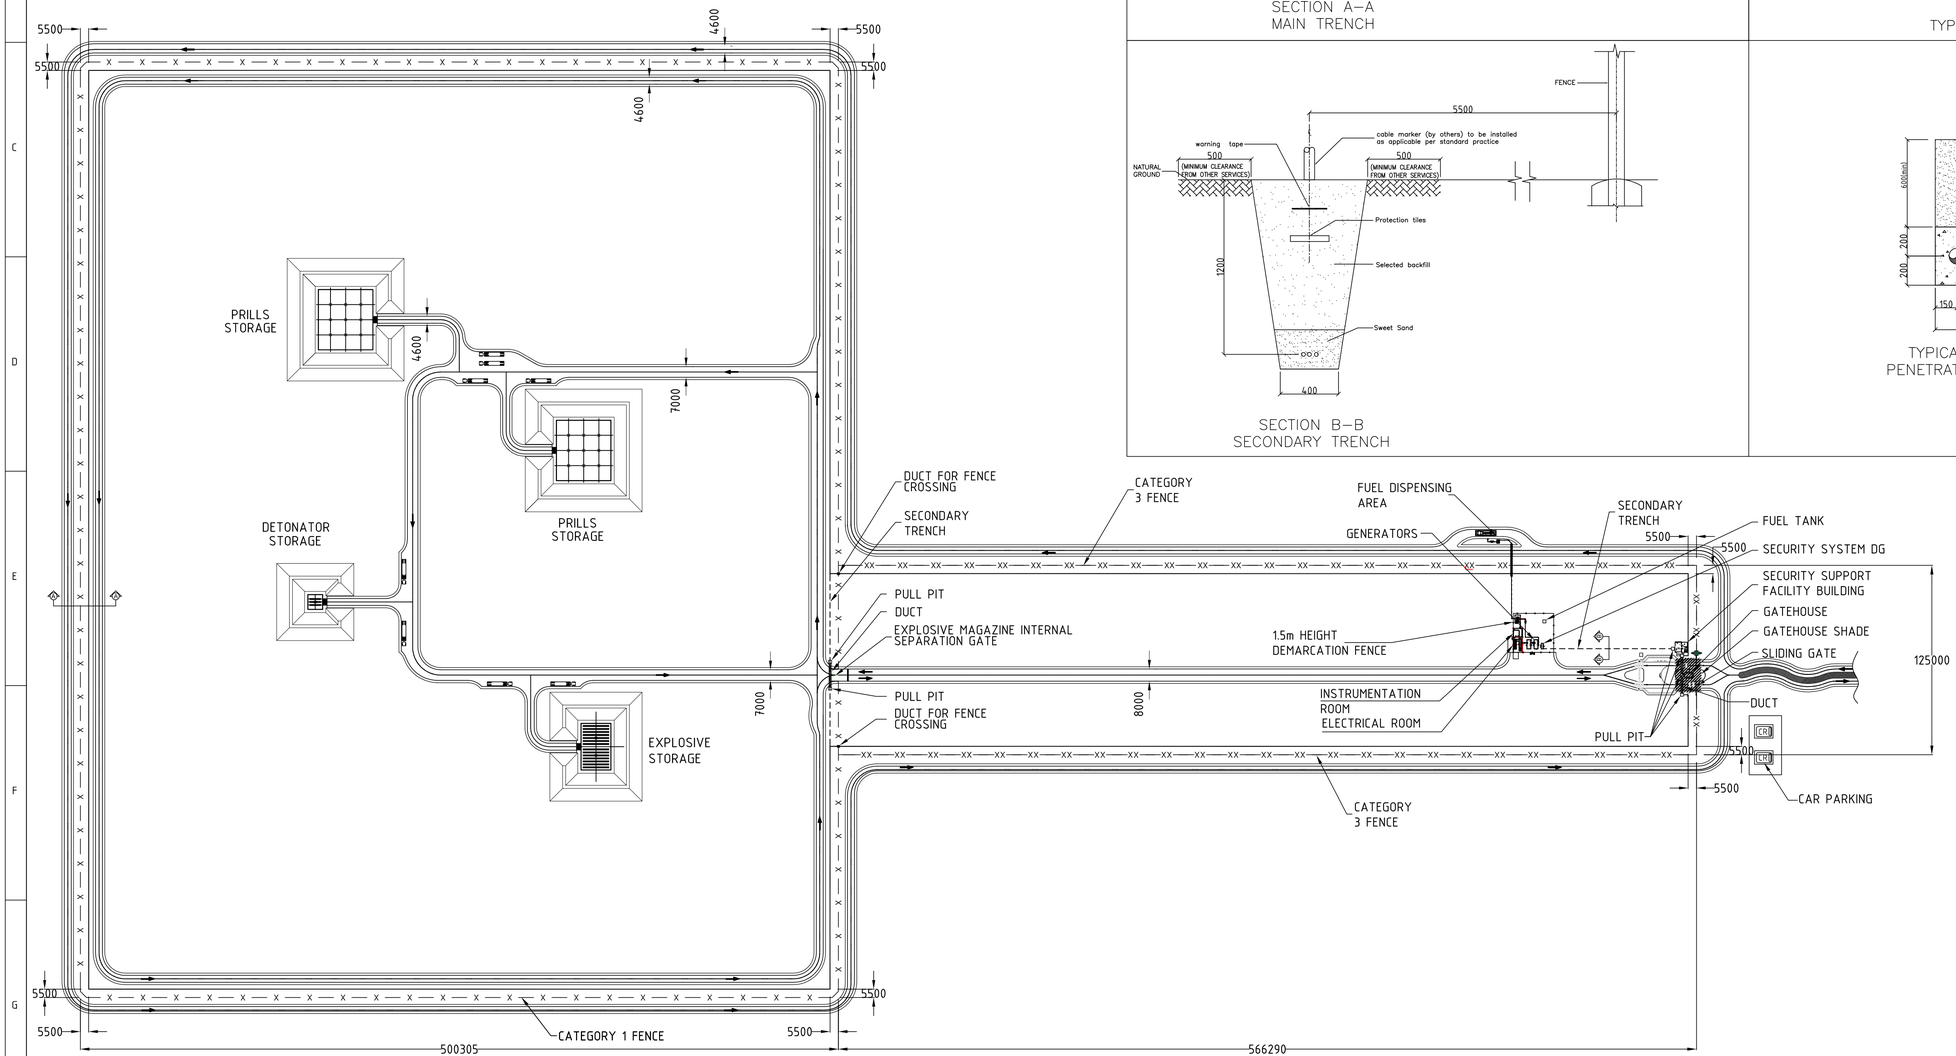

DOCUMENT NUMBER	REFERENCE DOCUMENTS	REV	DATE	REVISION DESCRIPTION	DRN	CHK	ENG	APP	EMP
		D01	28/12/2023	AS BUILT	--	SNM	--	SJM	
		C01	29/12/2020	ISSUED FOR CONSTRUCTION	--	SNM	--	SJM	
		A01	12/11/2020	ISSUED FOR APPROVAL	--	SNM	--	SJM	

ADVACON

LARSEN & TOUBRO

This drawing is the property of LARSEN & TOUBRO and must not be passed on to any person or body not authorized by us to receive it nor be copied or otherwise made use either in full or in part by such person or body without our prior permission in writing.

Outotec

The content of these documents are the sole property of Outotec Oyj. Any rights not expressly granted herein are reserved. Reproduction, transfer or distribution of part or all of the contents in any form without prior written permission of Outotec is prohibited.

MA'ADEN معادن
Saudi Arabian Mining Company شركة التعدين العربية السعودية

This document and the information contained herein is Ma'aden proprietary know-how. This document or any part thereof should not be reproduced, stored in a retrieval system or transmitted by any means, electronic or otherwise, or divulged without prior written permission of Ma'aden.

DRAWING NUMBER	MD-216-1800-EG-CV-DLA-1002	REVISION	C01
DATE / DRAWN	26/12/2020 / ABDUL	DATE / CHECKED	27/12/2020 / LARA
DATE / APPROVED	28/12/2020 / IHAB		

LARSEN & TOUBRO DRAWING NUMBER	019045_900_C_D_24484_001	REVISION	2
OUTOTEC DRAWING NUMBER	900707__GAU01__ZZ01__CLD01__25002	DOCUMENT ID	OU100690693
		REVISION	2

DRAWN	--	--
CHECKED	SNM	10/11/2020
ENGINEER	--	--
APPROVED	SJM	12/11/2020
EMPLOYER		
SCALE	1:2	A1

MANSOURAH - MASSARAH GOLD PROJECT
LAYOUT
EXPLOSIVE MAGAZINE
TRENCH LAYOUT - EXPLOSIVE MAGAZINE

DRAWING NUMBER MD-216-2500-EG-CV-LAD-2002 REV D01

Mansourah Massarah Gold Project
Comment Resolution Log Sheet / Compliance Report

PROJECT:	**MANSOURAH MASSARAH GOLD PROJECT**	**PROJECT NO.: 216**	
STAGE:	**4 - PROJECT EXECUTION.**	**REVIEW LOG DOC. NO. & REV.:**	
ACONEX REF. NO. & DATE:	**BECHTEL-WTRAN-006963, 9 December 2020**		

STATUS CODE: A - APPROVED, C - APPROVED WITH COMMENTS, R - REVISE & RESUBMIT & O - OTHERS (INFORMATION, REFERENCE, REVIEWED)

DOCUMENT NUMBER	Area / Title	Comment No.	PMC/PMT COMMENT DATE: 9 December 2020	Comment by	EPC Response DATE: 29 December 2020	Status	Remarks
			General Comments (cc)				
MD-216-2500-EG-CV-LAD-2002_A01	2500	1	Although there are technical specs, however it is noticed there is no indication if the design was also considering NFPA 495 and associated codes, and HCIS SAF-14 & SEC 02; SEC 03 and associated directives, therefore the EPC shall make sure materials, dimensions and specifications are in compliance to regulatory codes and HCIS directives.	Bechtel	The design is in compliance with approved stage-2 design package, and is also complient with HCIS regulatory codes SEC 02 ; SEC 03. Fire fighiting System design is not a part of the scope.	Closed	