

DRAWING NUMBER: MD-216-3210-EG-CV-DED-1002
REV: D01

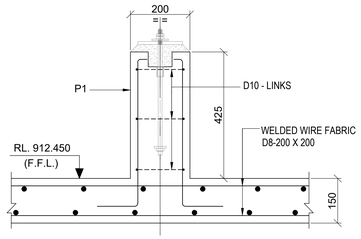


TYP. R.C. DETAIL OF SECTION A-A

(REFER DRAWING NUMBER MD-216-3210-EG-CV-GAD-1002)
(SCALE-1:10)

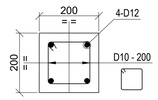


R.C. DETAIL OF PEDESTAL MKD. P1

(P1 - 2 NOS. REQUIRED)
(SCALE-1:10)

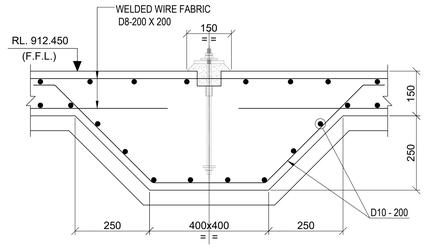


TYP. R.C. DETAIL OF SECTION A1-A1

(REFER DRAWING NUMBER MD-216-3210-EG-CV-GAD-1002)
(SCALE-1:10)

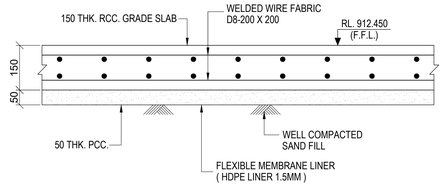

TYP. DET. OF 150 THK. GRADE SLAB

(SCALE - 1:10)

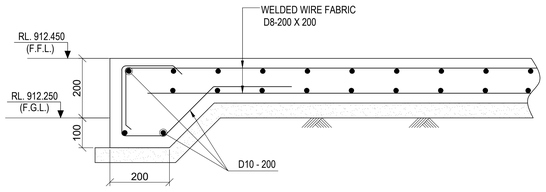

TYP. R.C. DETAIL OF SECTION B-B

(REFER DRAWING NUMBER MD-216-3210-EG-CV-GAD-1002)
(SCALE-1:10)

LEGENDS :-

R.L. - REDUCED LEVEL
℄ - CENTRE LINE
CJ - CONSTRUCTION JOINT
FDN. - FOUNDATION.
T.O.C. - TOP OF CONCRETE.
F.G.L. - FINISHED GROUND LEVEL.
F.F.L. - FINISHED FLOOR LEVEL.
B.O.F. - BOTTOM OF FOUNDATION
TYP. - TYPICAL.
R.C. - REINFORCED CONCRETE
P.C.C - PLAIN CEMENT CONCRETE
MKD. - MARKED.
THK. - THICK
D - DIAMETER OF BAR
B/W - BOTH WAYS
Ld - DEVELOPMENT LENGTH
BOTTOM REINFORCEMENT (B) - ————
TOP REINFORCEMENT (T) - – – – – – –
ALTH - ALLTHROUGH
B/F - BOTHFACE
REIN. - REINFORCEMENT

NOTES :-

1. ALL DIMENSIONS ARE IN MILLIMETRES AND LEVELS AND CO-ORDINATES ARE IN METRES. UNLESS OTHERWISE STATED.
2. GRADE OF CONCRETE SHALL BE C35 FOR FOUNDATION.
3. GRADE OF REINFORCEMENT SHALL BE DEFORMED BAR ASTM A615 - GRADE 60 (fy = 420 MPa).
4. NET SAFE BEARING CAPACITY OF SOIL AT BOTTOM OF FOUNDATION CONSIDERED 500KN/ SQ. M.
5. CLEAR COVER TO MAIN REINFORCEMENT SHALL BE AS
   a) FOUNDATION = 75 mm (BOTTOM & SIDE) 50 mm. (TOP)
   b) COLUMN & PEDESTAL = 50mm
   c) BEAM = 50mm
   d) SLAB = 40mm
6. FOR MINIMUM LAP LENGTH OF REINFORCEMENT AND OTHER GENERAL NOTES FOR CIVIL WORKS REFER STANDARD DRG : MD-216-1000-EG-CV-DED-1001
7. READ THIS DRAWING IN CONJUNCTION WITH DRG: MD-216-3210-EG-CV-GAD-1002
8. FOR OTHER STANDARD REINFORCEMENT DETAILS REFER DRG : MD-216-1000-EG-CV-DED-1005

DOCUMENT NUMBER	REFERENCE DOCUMENTS	REV	DATE	REVISION DESCRIPTION	DRN	CHK	ENG	APP	EMP
		D01	10/03/2023	AS-BUILT	JKM	SBY	APL	PRI	
MD-216-3210-EG-CV-GAD-1002	GA OF CONVEYOR 3210 CNV-001 GRADE SLAB	C01	28/12/2020	ISSUED FOR CONSTRUCTION	JKM	SBY	APL	PRI	
	LAYOUT & DETAIL	A01	17/11/2020	ISSUED FOR REVIEW	JKM	SBY	APL	PRI	

RESERVED FOR VENDOR LOGO AND DRAWING NUMBER

LARSEN & TOUBRO

This drawing is the property of *LARSEN & TOUBRO* and must not be passed on to any person or body not authorized by us to receive it nor be copied or otherwise made use either in full or in part by such person or body without our prior permission in writing.

Outotec

The content of these documents are the sole property of Outotec Oyj. Any rights not expressly granted herein are reserved. Reproduction, transfer or distribution of part or all of the contents in any form without prior written permission of Outotec is prohibited.

MA'ADEN معادن
Saudi Arabian Mining Company شركة معادن العربية السعودية

This document and the information contained herein is Ma'aden proprietary know-how. This document or any part thereof should not be reproduced, stored in a retrieval system or transmitted by any means, electronic or otherwise, or divulged without prior written permission of Ma'aden.

LARSEN & TOUBRO DRAWING NUMBER: O19045_450_C_D_24571_001 — REVISION: 2
OUTOTEC DRAWING NUMBER: 900707__GAU01__US01__CTB17__32110 — DOCUMENT ID: OU100706081 — REVISION: 2

DRAWN	JKM	13/11/2020	MANSOURAH - MASSARAH GOLD PROJECT
CHECKED	SBY	16/11/2020	DETAIL DRAWING
ENGINEER	APL	11/11/2020	GA OF CONVEYOR 3210-CNV-001
APPROVED	PRI	17/11/2020	GRADE SLAB RC DETAILS
EMPLOYER			
SCALE	1:100,20,15	A1	DRAWING NUMBER: MD-216-3210-EG-CV-DED-1002 — REV: D01