


DRAWING NUMBER: MD-216-3210-EG-CV-DED-1004 | REV: D01

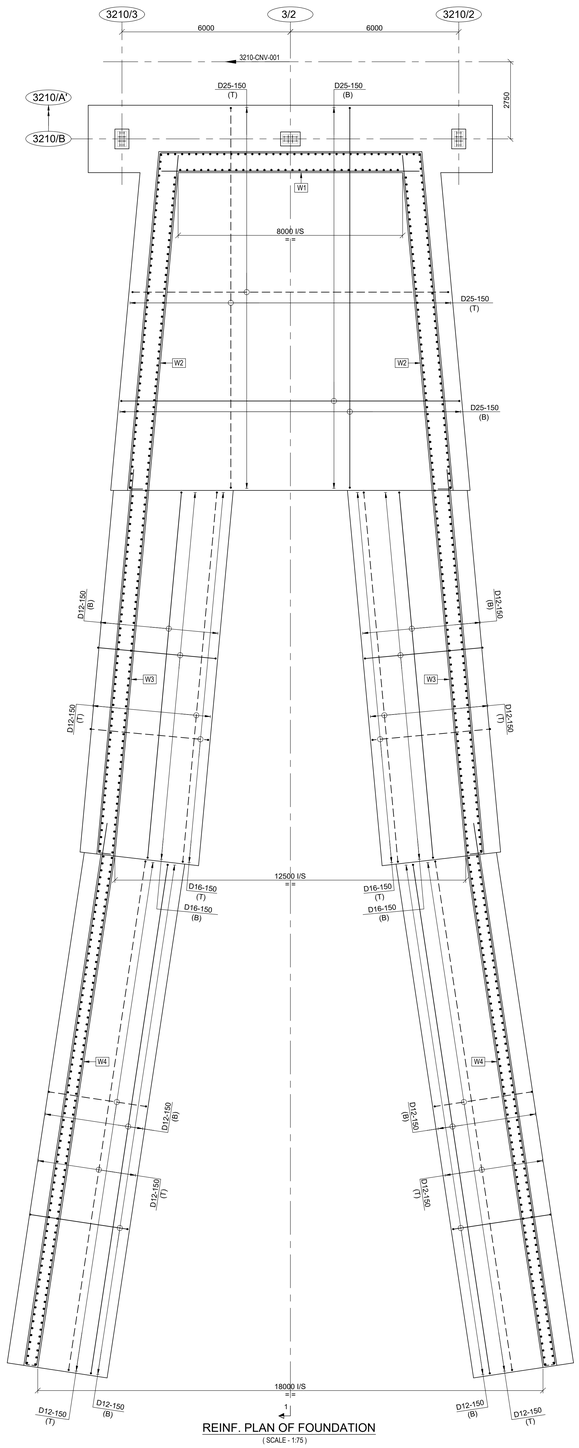


REINF. PLAN OF FOUNDATION
(SCALE - 1:75)

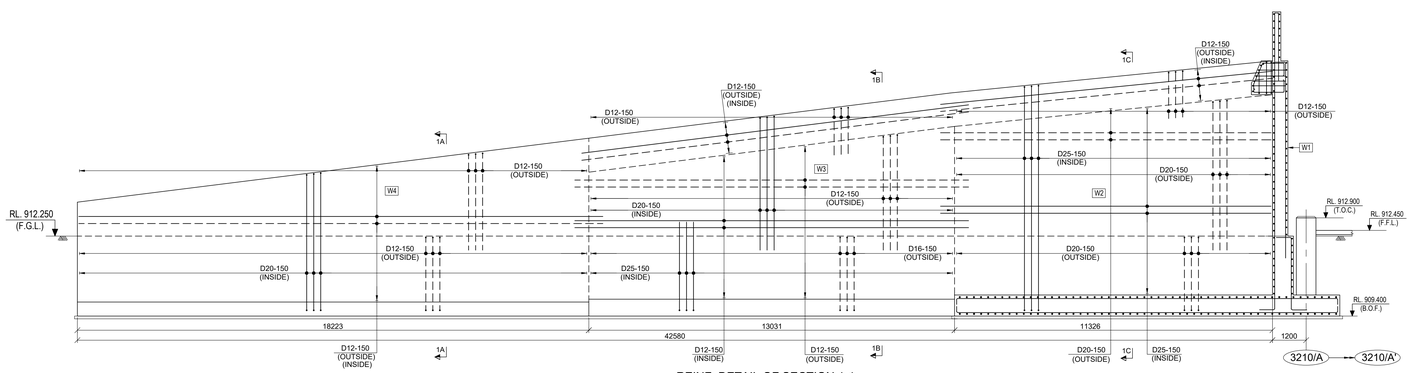


REINF. DETAIL OF SECTION 1-1
(SCALE - 1:75)

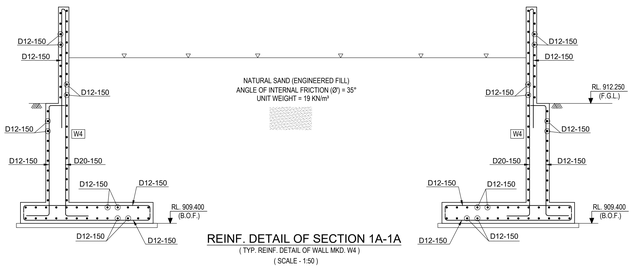


REINF. DETAIL OF SECTION 1A-1A
(TYP. REINF. DETAIL OF WALL MKD. W4)
(SCALE - 1:50)

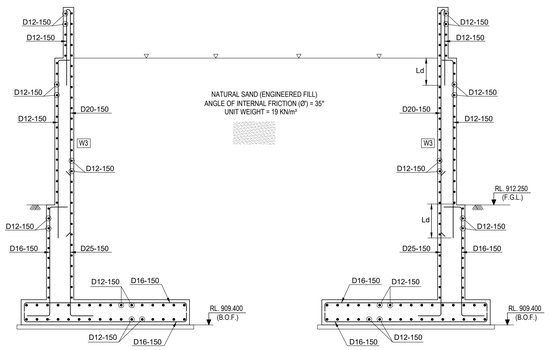


REINF. DETAIL OF SECTION 1B-1B
(TYP. REINF. DETAIL OF WALL MKD. W3)
(SCALE - 1:50)

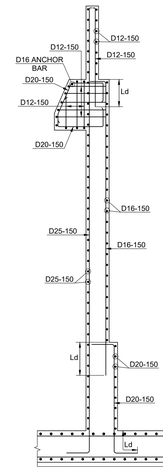


TYP. REINF. DETAIL OF WALL MKD. W1
(SCALE - 1:50)

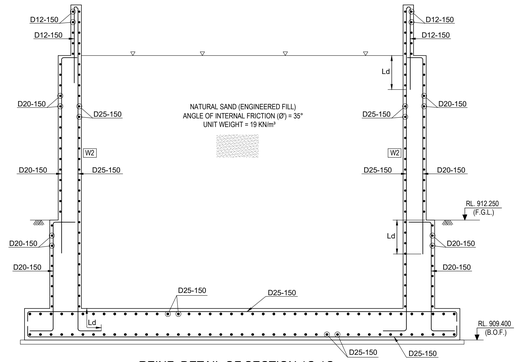


REINF. DETAIL OF SECTION 1C-1C
(TYP. REINF. DETAIL OF WALL MKD. W2)
(SCALE - 1:50)

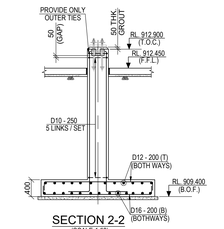


SECTION 2-2
(SCALE-1:50)

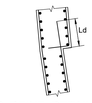


TYP. REINF. DETAIL OF TWO DIFFERENT THICKNESS WALL IN JOINT LOCATION
(SCALE - 1:50)

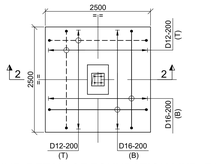


REINF. DETAIL OF FOUNDATION MKD. F1
(3 NOS. REQUIRED)
(SCALE- 1:50)

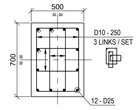

REINF. DETAIL OF PEDESTAL MKD. P1 & P1A
(3+3 NOS.)
SCALE 1:20

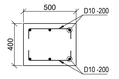

REINF. DETAIL OF PEDESTAL MKD. P2
(1 NO.)
SCALE 1:20

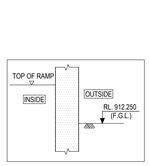

LEGEND :-

RL - REDUCED LEVEL
℄ - CENTRE LINE
T.O.C. - TOP OF CONCRETE
F.G.L. - FINISHED GROUND LEVEL
F.F.L. - FINISHED FLOOR LEVEL
B.O.F. - BOTTOM OF FOUNDATION
N.T.S. - NOT TO SCALE
TYP. - TYPICAL
R.C.C. - REINFORCED CEMENT CONCRETE
P.C.C. - PLAIN CEMENT CONCRETE
MKD. - MARKED
THK. - THICK
MM - MILLIMETRE
R.C. - REINFORCED CONCRETE
T - TOP
B - BOTTOM
– – – - TOP/OUTSIDE REINFORCEMENT
——— - BOTTOM/INSIDE REINFORCEMENT
D - DIAMETER OF BAR
B/W - BOTH WAYS
REINF. - REINFORCEMENT
Ld - DEVELOPMENT LENGTH
G&C - GRINDING & CLASSIFICATION
FDN. - FOUNDATION
IS - INNER SIDE
DRG. NO. - DRAWING NUMBER

NOTES :-

1. ALL DIMENSIONS ARE IN MILLIMETRES AND LEVELS AND CO-ORDINATES ARE IN METRES. UNLESS OTHERWISE STATED.
2. GRADE OF CONCRETE SHALL BE C35 FOR FOUNDATION.
3. GRADE OF REINFORCEMENT SHALL BE DEFORMED BAR ASTM A615 - GRADE 60 (fy = 420 MPa).
4. NET SAFE BEARING CAPACITY OF SOIL AT BOTTOM OF FOUNDATION CONSIDERED 500KN/SQ. M.
5. CLEAR COVER TO MAIN REINFORCEMENT SHALL BE AS
   a) FOUNDATION = 75mm (BOTTOM & SIDE) 50 mm (TOP)
   b) WALL = 50 mm c) COLUMN = 50mm d) BEAM = 50mm e) SLAB = 40mm
6. FOR MINIMUM LAP LENGTH OF REINFORCEMENT REFER STANDARD DRAWING NO. MD-216-1000-EG-CV-DED-1005
7. THIS DRG. SHALL BE READ IN CONJUNCTION WITH DRG. NO. MD-216-3210-EG-CV-GAD-1003

DOCUMENT NUMBER	REFERENCE DOCUMENTS	REV	DATE	REVISION DESCRIPTION	DRN	CHK	ENG	APP	EMP
MD-216-3210-EG-ME-ELV-1014	RECLAIM FEEDER 3210-FDR-005 - ELEVATION								
MD-216-3210-EG-ME-LPX-1009	EMERGENCY STOCKPILE RECLAIM HOPPER - PLAN	D01	10/03/2023	AS-BUILT	MGH	SBY	RPK	PRI	
MD-216-3210-EG-ME-ELV-1012	EMERGENCY STOCKPILE RECLAIM HOPPER - ELEVATION	C01	12/12/2020	ISSUED FOR CONSTRUCTION	MGH	SBY	RPK	PRI	
MD-216-3210-EG-ME-LPX-1008	EMERGENCY STOCKPILE RECLAIM HOPPER - PLAN	A01	31/10/2020	ISSUED FOR REVIEW	MGH	SBY	RPK	PRI	

RESERVED FOR VENDOR LOGO AND DRAWING NUMBER

LARSEN & TOUBRO
This drawing is the property of LARSEN & TOUBRO and must not be passed on to any person or body not authorized by us to receive it nor be copied or otherwise made use either in full or in part by such person or body without our prior permission in writing.

Outotec
The content of these documents are the sole property of Outotec Oy. Any rights not expressly granted herein are reserved. Reproduction, transfer or distribution of part or all of the contents in any form without prior written permission of Outotec is prohibited.

MA'ADEN معادن
Saudi Arabian Mining Company شركة المعادن العربية السعودية
This document and the information contained herein is Ma'aden proprietary know-how. This document or any part thereof should not be reproduced, stored in a retrieval system or transmitted by any means, electronic or otherwise, or divulged without prior written permission of Ma'aden.

LARSEN & TOUBRO DRAWING NUMBER	019045_450_C_D_24568_001	REVISION 2
OUTOTEC DRAWING NUMBER	900707 _ GAU01 _ US01 _ CTB17 _ 32109	DOCUMENT ID OU100706080 / REVISION 2
DRAWN	MGH	29/10/2020
CHECKED	SBY	30/10/2020
ENGINEER	RPK	29/10/2020
APPROVED	PRI	31/10/2020
EMPLOYER		
SCALE	1:100,1:75,1:50,1:25,1:20,1:10	A0

MANSOURAH - MASSARAH GOLD PROJECT
DETAIL DRAWING
G&C-EMERGENCY STOCKPILE RECLAIM HOPPER
REINFORCEMENT DETAILS

DRAWING NUMBER: MD - 216 - 3210 - EG - CV - DED - 1004 | REV: D01