


DRAWING NUMBER: MD-216-3210-EG-CV-DED-1136 | REV: D01

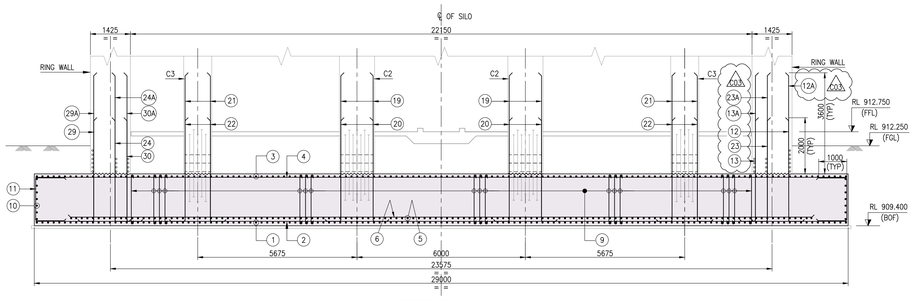

SECTION : 2-2
SCALE-(1:75)

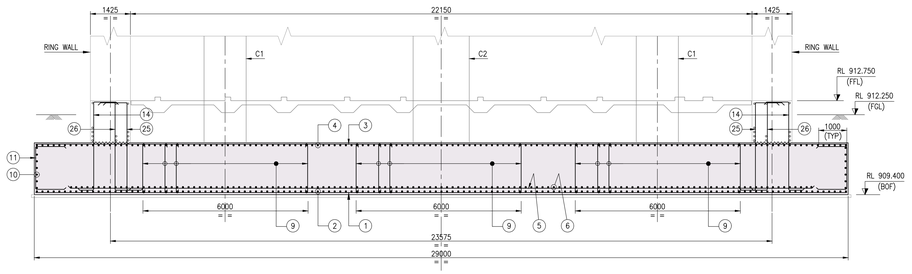


SECTION : 1-1
SCALE-(1:75)

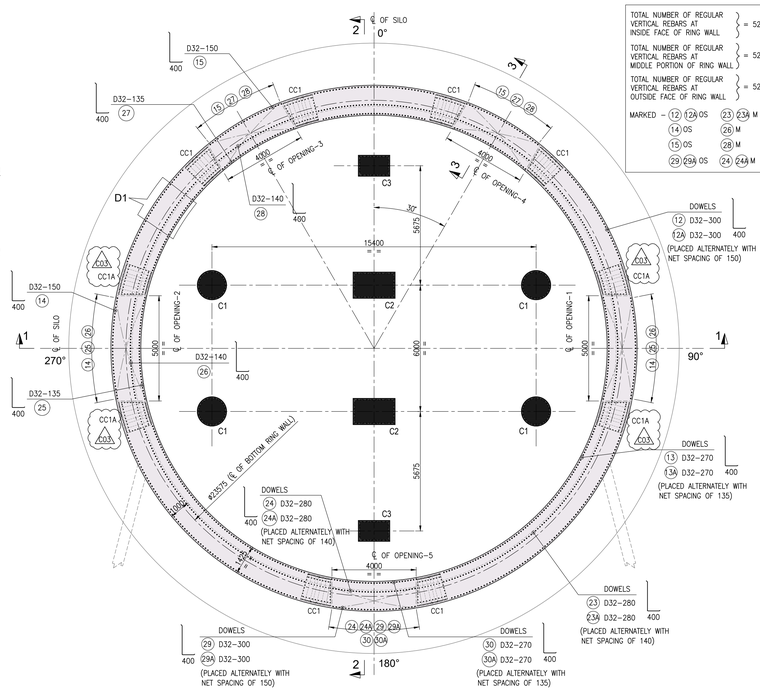


PLAN SHOWING DOWELS FOR RING WALL
AND INTERNAL COLUMN REINFORCEMENT
SCALE-(1:100)

TOTAL NUMBER OF REGULAR VERTICAL REBARS AT INSIDE FACE OF RING WALL	= 520
TOTAL NUMBER OF REGULAR VERTICAL REBARS AT MIDDLE PORTION OF RING WALL	= 520
TOTAL NUMBER OF REGULAR VERTICAL REBARS AT OUTSIDE FACE OF RING WALL	= 520


MARKED – 12 12A OS 23 23A M 13 13A IS
14 OS 26 M 25 IS
15 OS 28 M 27 IS
29 29A OS 24 24A M 30 30A IS

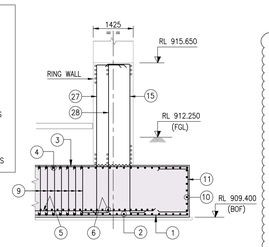


SECTION : 3-3
SCALE-(1:75)

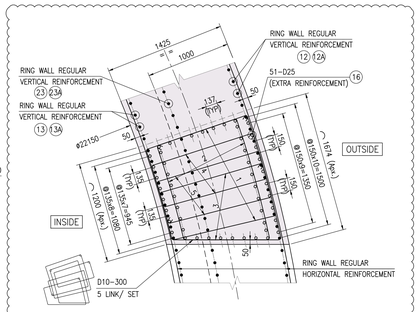


SECTIONAL DETAIL OF COLUMN
(MKD. CC1A)
('o'-EXTRA VERTICAL REINFORCEMENT AROUND OPENING)
('•'-REGULAR VERTICAL REINFORCEMENT)
SCALE 1:25

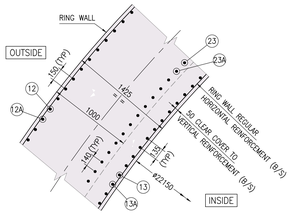


DETAIL - D1
SCALE - (1:25)

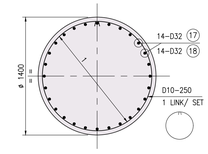


SECTIONAL DETAIL OF COLUMN
(MKD. C1)
SCALE 1:25

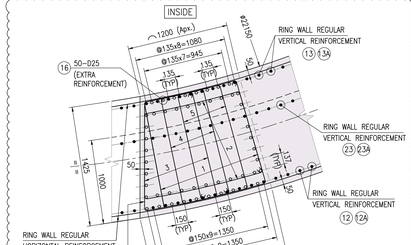


SECTIONAL DETAIL OF COLUMN
(MKD. CC1)
('o'-EXTRA VERTICAL REINFORCEMENT AROUND OPENING)
('•'-REGULAR VERTICAL REINFORCEMENT)
SCALE 1:25

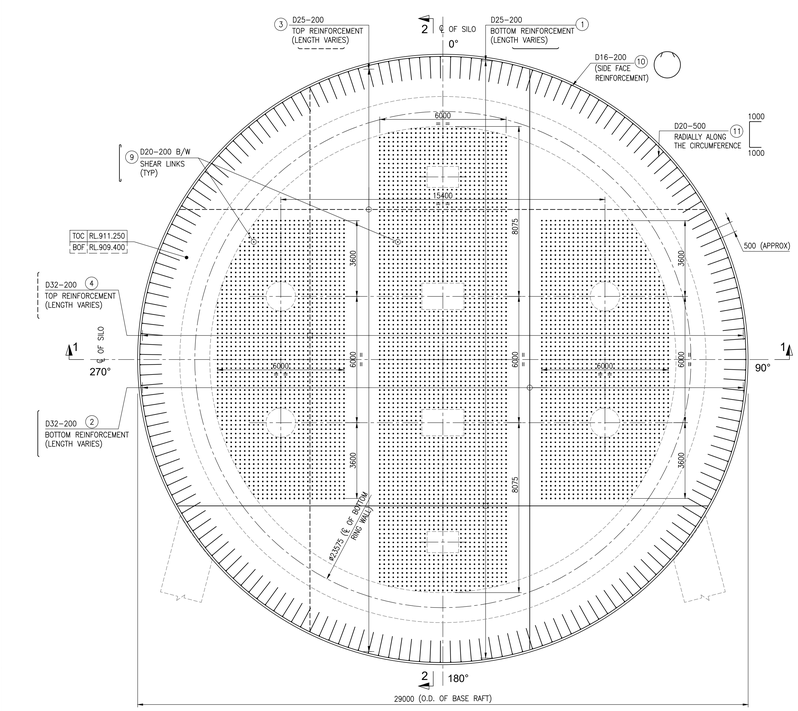


PLAN AT RL 909.400 (BOF)
(SHOWING TOP AND BOTTOM REINFORCEMENT)
SCALE-(1:100)

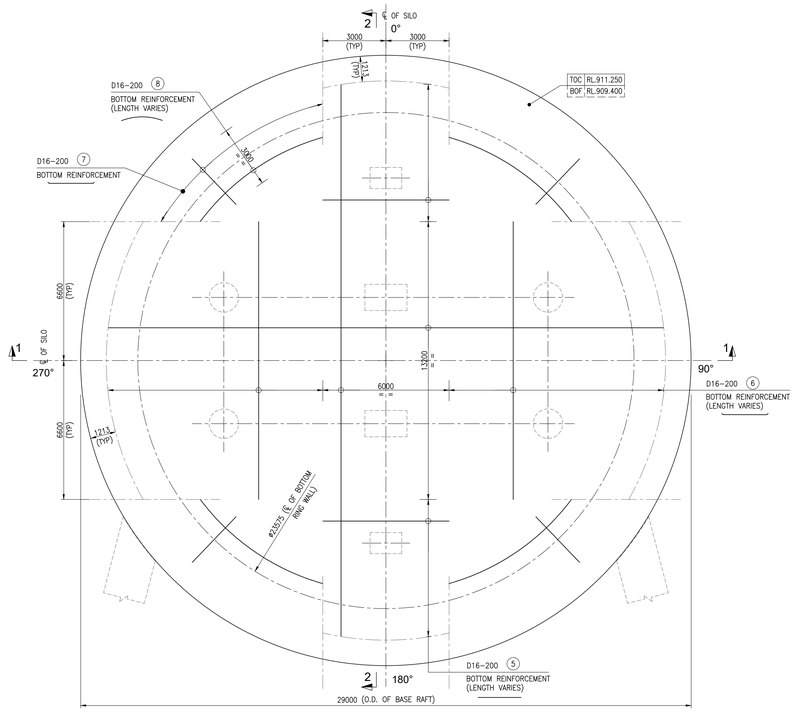


PLAN AT RL 909.400 (BOF)
(SHOWING BOTTOM EXTRA REINFORCEMENT)
SCALE-(1:100)

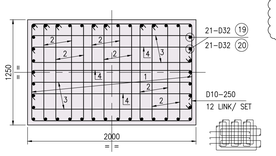

SECTIONAL DETAIL OF COLUMN
(MKD. C2)
SCALE 1:25

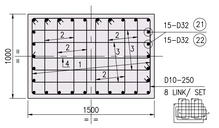

SECTIONAL DETAIL OF COLUMN
(MKD. C3)
SCALE 1:25

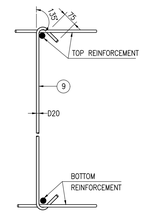

TYP DETAIL OF VERTICAL
SHEAR LINK (IN RAFT)
(ELEVATION)

LEGEND :-

TOC = TOP OF CONCRETE
FGL = FINISHED GROUND LEVEL
BOF = BOTTOM OF FOOTING
TYP = TYPICAL
MKD = MARKED
℄ = CENTRE LINE
ø = DIAMETER
R = RADIUS
B/S = BOTH SIDE
OS = OUT SIDE
M = MIDDLE
I/S = IN SIDE
RL = REDUCED LEVEL
O.D. = OUT SIDE DIA
– – – – = TOP REINFORCEMENT
——— = BOTTOM REINFORCEMENT

NOTES :-

1. ALL DIMENSIONS ARE IN MILLIMETRES AND LEVELS AND CO-ORDINATES ARE IN METRES. UNLESS OTHERWISE STATED.
2. THIS DRAWING SHALL BE READ IN CONJUNCTION WITH DRAWING NUMBER : MD-216-3210-EG-CV-GAD-1132, 1133 & 1134.
3. FOR ALL OTHER NOTES REFER DRAWING NO. MD-216-1000-EG-CV-DED-1001, 1003 & 1004.
4. GRADE OF CONCRETE SHALL BE C35 AND GRADE OF CONCRETE SHALL BE C30 FOR GRADE SLAB.
5. GRADE OF REINFORCEMENT SHALL BE DEFORMED BAR ASTM A615–GRADE 60 (fy=420 MPa)
6. GRADE OF WELDED WIRE FABRIC – ASTM A185(PLAIN) / A497(DEFORMED).
7. NET SAFE BEARING CAPACITY OF SOIL AT BOTTOM OF FOUNDATION CONSIDER 600kN/ SQ. M
8. IF ANY PART OF FOUNDATION COMES ON BACKFILL ZONE OF ADJACENT FOUNDATION OR ANY LOOSE SOIL ARE ENCOUNTERED BELOW FOUNDATION LEVEL THE SAME SHALL BE REMOVED AND FILLED WITH PCC.
9. REINFORCEMENT SHALL BE SUITABLY ADJUSTED AT SITE TO CLEAR POCKETS, BOLTS ETC.
10. SUFFICIENT AND SUITABLE NOS OF CHAIRS SHALL BE PROVIDED AT APPROPRIATE LOCATIONS TO MAINTAIN CORRECT POSITION OF REINFORCEMENT.
11. CLEAR COVER TO MAIN REINFORCEMENT SHALL BE AS FOLLOWS :
    a) RAFT : 75 mm (BOTTOM & SIDE)
    b) RAFT : 50 mm (TOP)
    c) WALL : 50 mm
    d) SLAB : 40 mm
    e) PEDESTAL & COLUMN : 50 mm
12. MINIMUM LAP LENGTHS OF REINFORCEMENT SHALL BE 40xBAR DIAMETER.
13. THIS DRAWING SHALL BE READ IN CONJUNCTION WITH DRAWING NO. MD-216-3210-EG-CV-DED-1137, 1138 & 1139.

DOCUMENT NUMBER	REFERENCE DOCUMENTS	REV	DATE	REVISION DESCRIPTION	DRN	CHK	ENG	APP	EMP
		D01	10/03/2023	AS-BUILT	ABH	UR	SVK	AG	
		C03	11/08/2020	ISSUED FOR CONSTRUCTION & REVISED AS MARKED C03	ABH	UR	SVK	AG	
		C02	19/06/2020	ISSUED FOR CONSTRUCTION & REVISED AS MARKED C02	ABH	UR	SVK	AG	
		C01	06/06/2020	ISSUED FOR CONSTRUCTION C01	ABH	UR	SVK	AG	
		A02	30/04/2020	REVISED AS PER EMPLOYER COMMENTS	ABH	UR	SVK	AG	
				ON 04/04/2020 & REVISED AS MARKED A02					
		A01	05/03/2020	ISSUED FOR REFERENCE	ABH	UR	SVK	AG	

RESERVED FOR VENDOR LOGO AND DRAWING NUMBER

LARSEN & TOUBRO

This drawing is the property of LARSEN & TOUBRO and must not be passed on to any person or body not authorised by us to receive it nor be copied or otherwise made use either in full or in part by such person or body without our prior permission in writing.

Outotec

The content of these documents are the sole property of Outotec Oyj. Any rights not expressly granted herein are reserved. Reproduction, transfer or distribution of part or all of the contents in any form without prior written permission of Outotec is prohibited.

MA'ADEN معادن
Saudi Arabian Mining Company شركة فعادن للتعدين العربية السعودية

This document and the information contained herein is Ma'aden proprietary know-how. This document or any part thereof should not be reproduced, stored in a retrieval system or transmitted by any means, electronic or otherwise, or divulged without prior written permission of Ma'aden.

LARSEN & TOUBRO DRAWING NUMBER			REVISION
019045_450_C_D_24072_001			5
OUTOTEC DRAWING NUMBER		DOCUMENT ID	REVISION
900707__GAU01__US01__CTB17__32101		OU100673544	5
DRAWN	ABH	03/03/2020	MANSOURAH – MASSARAH GOLD PROJECT
CHECKED	UR	04/03/2020	DETAIL DRAWING
ENGINEER	SVK	02/03/2020	GRINDING & CLASSIFICATION
APPROVED	AG	05/03/2020	CRUSHED ORE STORAGE BIN – R.C. DETAIL
EMPLOYER			
SCALE 1:100	A0		DRAWING NUMBER: MD-216-3210-EG-CV-DED-1136 REV: D01