


DRAWING NUMBER: MD-216-3210-EG-CV-DED-1137 | REV: D01

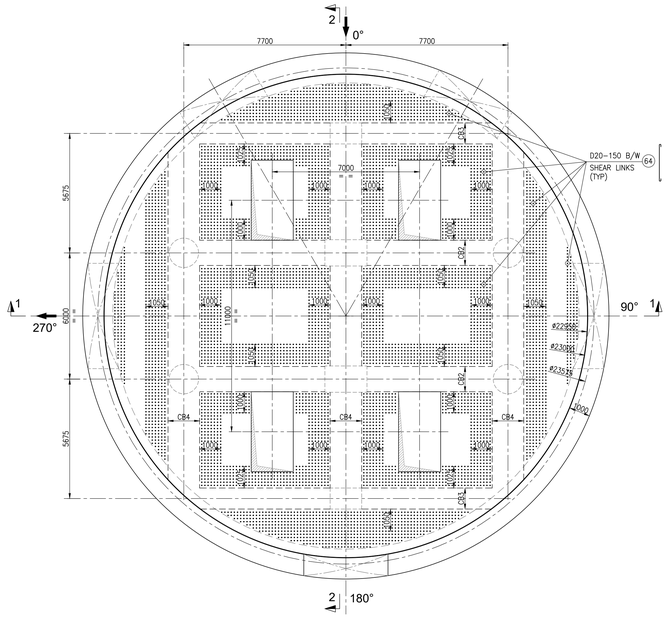


PLAN AT RL 920.800 (TOC)
(SLAB REINFORCEMENT SHOWING ONLY SHEAR LINKS)
SCALE-(1:100)

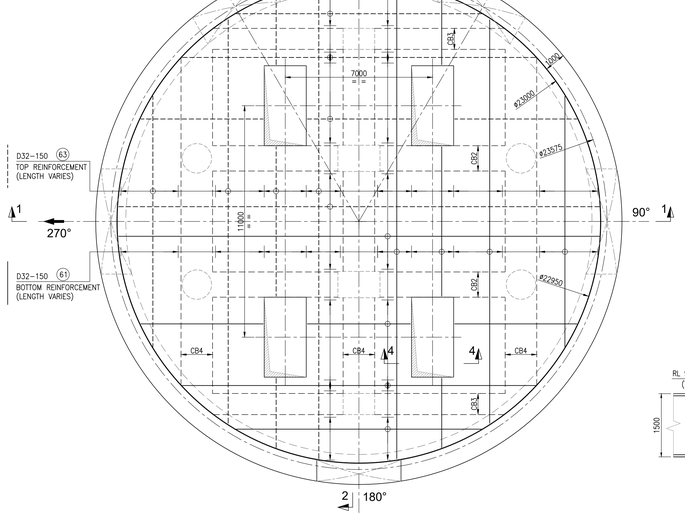


PLAN AT RL 920.800 (TOC)
(SLAB REINFORCEMENT SHOWING ONLY MAIN BAR, TOP & BOTTOM)
SCALE-(1:100)

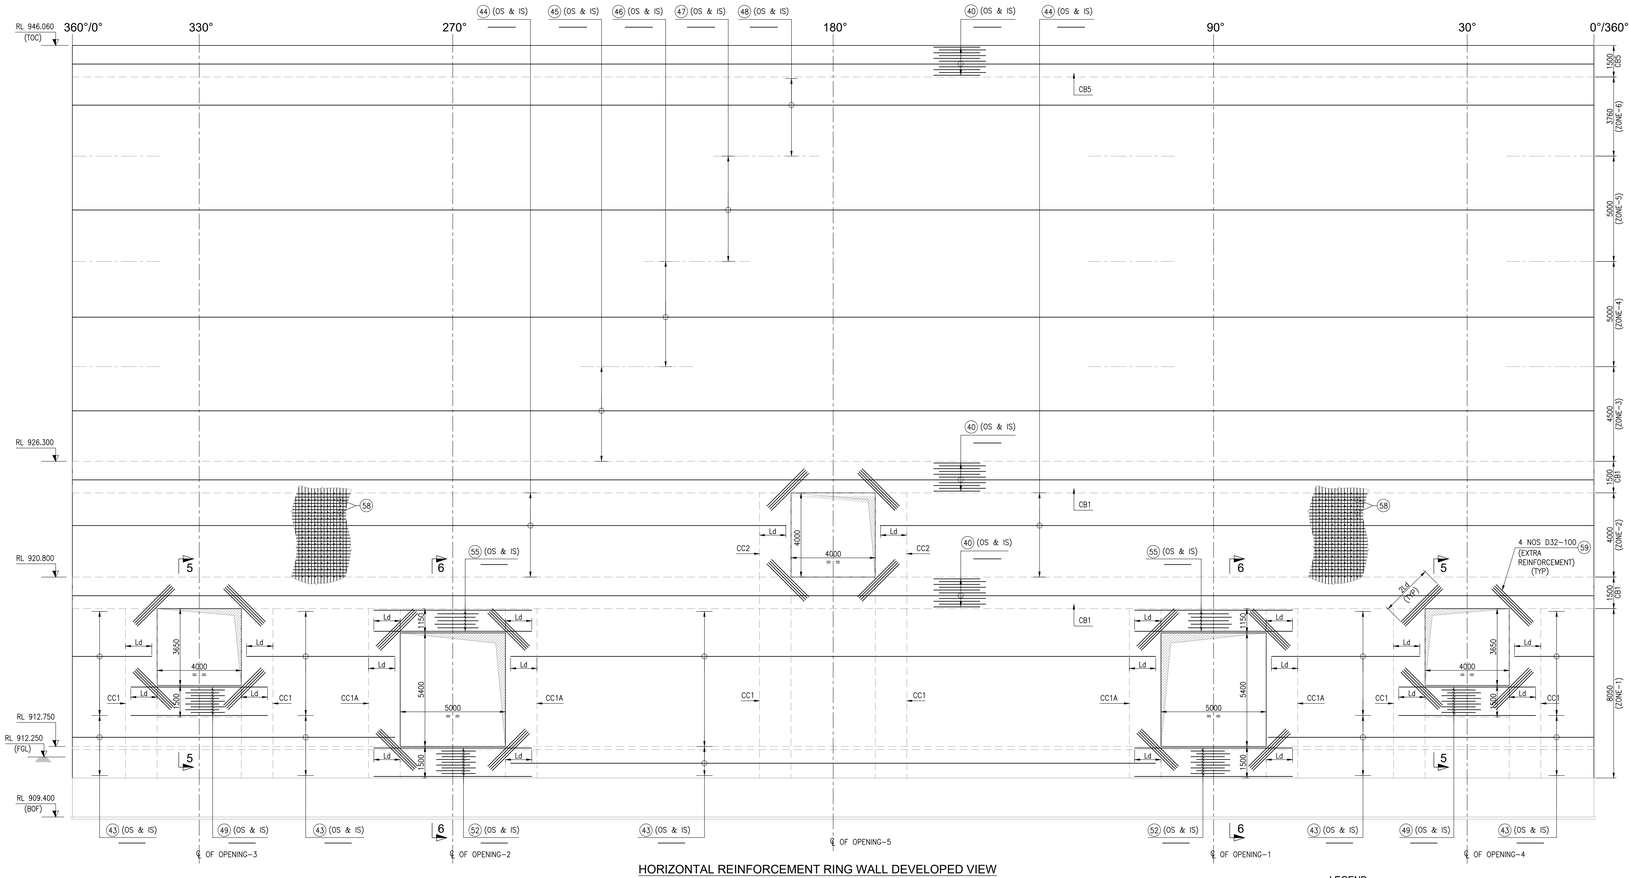


HORIZONTAL REINFORCEMENT RING WALL DEVELOPED VIEW
(VIEW FROM OUTSIDE)
SCALE-(1:100)

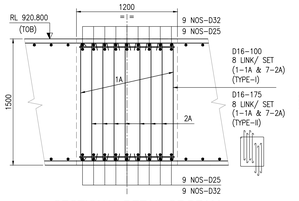


SECTIONAL DETAIL OF BEAM
(MKD. CB2)
SCALE 1:25

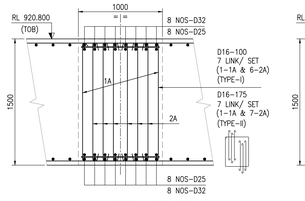


SECTIONAL DETAIL OF BEAM
(MKD. CB3)
SCALE 1:25

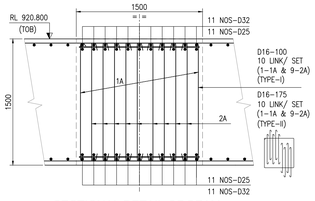


SECTIONAL DETAIL OF BEAM
(MKD. CB4)
SCALE 1:25

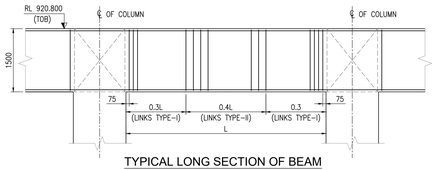

TYPICAL LONG SECTION OF BEAM
(SHOWING ONLY LINKS ARRANGEMENT)
SCALE 1:50

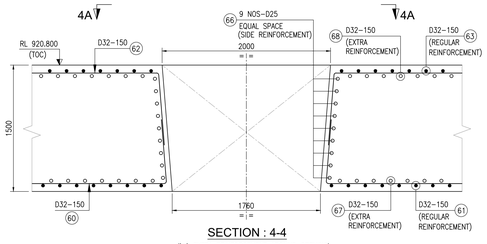

SECTION : 4-4
('o'-EXTRA REINFORCEMENT AROUND OPENING)
('•'-REGULAR REINFORCEMENT)
SCALE 1:25

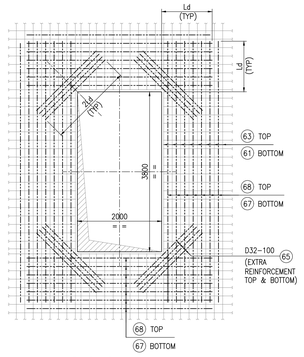

SECTION : 4A-4A
SCALE 1:50

LEGEND :-

TOC = TOP OF CONCRETE
PCC = PLAIN CEMENT CONCRETE
TOB = TOP OF BEAM
FGL = FINISHED GROUND LEVEL
BOF = BOTTOM OF FOOTING
FFL = FINISH FLOOR LEVEL
TYP = TYPICAL
MKD = MARKED
℄ = CENTRE LINE
ø = DIAMETER
R = RADIUS
B/S = BOTH SIDE
OS = OUT SIDE
M = MIDDLE
IS = IN SIDE
RL = REDUCED LEVEL
B/W = BOTH WAY
THK. = THICK
MIN. = MINIMUM
SBC = SAFE BEARING CAPACITY
– – – – = TOP REINFORCEMENT
——— = BOTTOM REINFORCEMENT
- - - - - - = EXTRA REINFORCEMENT

NOTES :-

1. ALL DIMENSIONS ARE IN MILLIMETRES AND LEVELS AND CO-ORDINATES ARE IN METRES. UNLESS OTHERWISE STATED.
2. THIS DRAWING SHALL BE READ IN CONJUNCTION WITH DRAWING NUMBER : MD-216-3210-EG-CV-GAD-1132, 1133 & 1134.
3. ALL OTHER NOTES REFER DRAWING NO. MD-216-1000-EG-CV-DED-1001, 1003, 1004 & 1005.
4. GRADE OF CONCRETE SHALL BE C30 (30MPa) ONLY FOR GRADE SLAB AND C35 (35MPa) FOR OTHERS.
5. GRADE OF REINFORCEMENT SHALL BE DEFORMED BAR 420 MPa (GRADE 60) – ASTM A615/A615M.
6. GRADE OF WELDED WIRE FABRIC – ASTM A185(PLAIN) / A497(DEFORMED).
7. NET SAFE BEARING CAPACITY OF SOIL AT BOTTOM OF FOUNDATION IS CONSIDERED AS 600KN/ SQ. M
8. IF ANY PART OF FOUNDATION COMES ON BACKFILL ZONE OF ADJACENT FOUNDATION OR ANY LOOSE SOIL ARE ENCOUNTERED BELOW FOUNDATION LEVEL THE SAME SHALL BE REMOVED AND FILLED WITH PCC.
9. REINFORCEMENT SHALL BE SUITABLY ADJUSTED AT SITE TO CLEAR POCKETS, BOLTS ETC.
10. SUITABLE ARRANGEMENT TO BE PROVIDED AT SITE DURING EXECUTION, TO MAINTAIN CORRECT POSITION OF REINFORCEMENTS & CORRECT DISTANCE BETWEEN TOP & BOTTOM BARS.
11. CLEAR COVER TO MAIN REINFORCEMENT SHALL BE AS FOLLOWS :
    a) RAFT : 75 mm (BOTTOM & SIDE)
    b) RAFT : 50 mm (TOP)
    c) WALL : 50 mm
    d) SLAB : 40 mm
    e) PEDESTAL & COLUMN : 50 mm
12. MINIMUM LAP LENGTHS OF REINFORCEMENT SHALL BE AS PER GENERAL NOTES FOR CIVIL WORKS DRAWING NO : MD-216-1000-EG-CV-DED-1001.
13. THIS DRAWING SHALL BE READ IN CONJUNCTION WITH DRAWING NO. MD-216-3210-EG-CV-DED-1136, 1138 & 1139.

DOCUMENT NUMBER	REFERENCE DOCUMENTS	REV	DATE	REVISION DESCRIPTION	DRN	CHK	ENG	APP	EMP
		D01	10/03/2023	AS-BUILT	ABH	UR	SVK	AG	
		C01	23/07/2020	ISSUED FOR CONSTRUCTION	ABH	UR	SVK	AG	
		A02	25/06/2020	REVISED AS PER EMPLOYER COMMENTS	ABH	UR	SVK	AG	
				ON 26/05/2020 & REVISED AS MARKED A02					
		A01	30/04/2020	ISSUED FOR REFERENCE	ABH	UR	SVK	AG	

RESERVED FOR VENDOR LOGO AND DRAWING NUMBER

LARSEN & TOUBRO

This drawing is the property of LARSEN & TOUBRO and must not be passed on to any person or body not authorized by us to receive it nor be copied or otherwise made use either in full or in part by such person or body without our prior permission in writing.

Outotec

The content of these documents are the sole property of Outotec Oyj. Any rights not expressly granted herein are reserved. Reproduction, transfer or distribution of part or all of the contents in any form without prior written permission of Outotec is prohibited.

MA'ADEN معادن
Saudi Arabian Mining Company شركة معادن العربية السعودية

This document and the information contained herein is Ma'aden proprietary know-how. This document or any part thereof should not be reproduced, stored in a retrieval system or transmitted by any means, electronic or otherwise, or divulged without prior written permission of Ma'aden.

LARSEN & TOUBRO DRAWING NUMBER	019045_450_C_D_24072_002		REVISION 3
OUTOTEC DRAWING NUMBER	900707__GAU01__US01__CTB17__32102	DOCUMENT ID OU100673545	REVISION 3
DRAWN	ABH	24/04/2020	MANSOURAH – MASSARAH GOLD PROJECT
CHECKED	UR	29/04/2020	DETAIL DRAWING
ENGINEER	SVK	24/04/2020	GRINDING & CLASSIFICATION
APPROVED	AG	30/04/2020	CRUSHED ORE STORAGE BIN – R.C. DETAIL
EMPLOYER			
SCALE 1:100	A0	DRAWING NUMBER MD-216-3210-EG-CV-DED-1137	REV D01