
DRAWING NUMBER: MD-216-3210-EG-CV-DED-1143
REV: D01

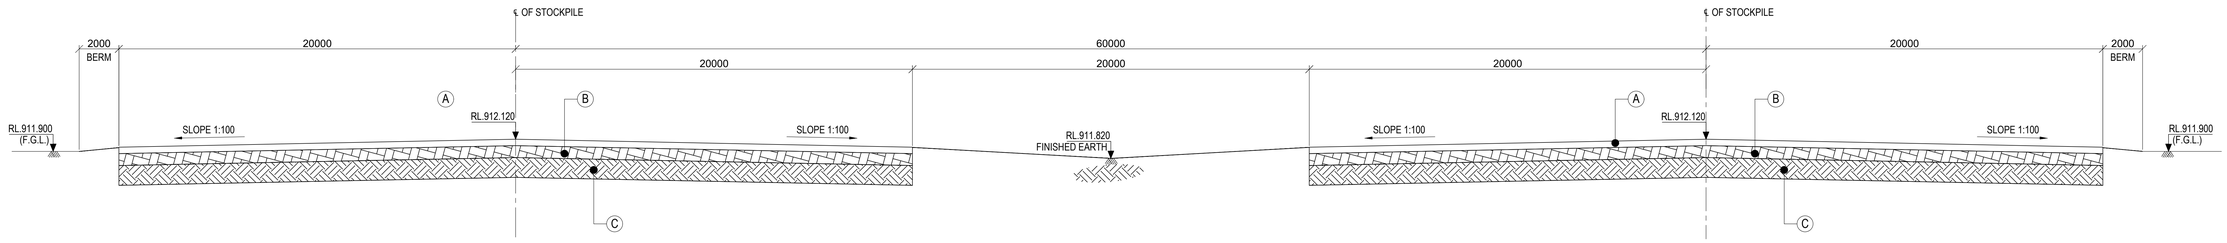

EMERGENCY STOCKPILE COMPOSITION

A - 200 THK CAPING
B - 300 THK ENGINEERED FILL *
C - SUITABLE SUBGRADE - COMPACTED EARTH

SECTION: A-A

(REFER DWG. NO. MD-216-3210-EG-CV-GAD-1142)

LEGEND :-

R.L. - REDUCED LEVEL
TYP. - TYPICAL
F.G.L. - FINISHED GROUND LEVEL.
℄ - CENTRE LINE
DWG. NO. - DRAWING NUMBER

NOTES:-

1. ALL DIMENSIONS ARE IN MILLIMETRES
2. EARTH TO BE FINISHED IN SLOPE 1:750.
3. CO-ORDINATES AND LEVELS ARE IN METRES
4. CO-ORDINATES ARE ON WORLD GRID (FLAT PLANT/WORLD)
5. WORLD MAPPING GRID BASED ON UTM (WGS 84) Q38N
6. THIS DRAWING SHOULD BE READ IN CONJUNCTION WITH DWG. NO. MD-216-3210-EG-CV-GAD-1142.
* 7. ENGINEERED FILL WILL BE AS PER APPROVED DOC NO. MD-216-1000-EG-CV-MST-1698.

DOCUMENT NUMBER	REFERENCE DOCUMENTS	REV	DATE	REVISION DESCRIPTION	DRN	CHK	ENG	APP	EMP
		D01	10/03/2023	AS-BUILT	DSR	SJM	BJB	AG	
MD-216-3210-EG-CV-GAD-1142	LAYOUT	C01	04/09/2020	ISSUED FOR CONSTRUCTION (C01)	DSR	SJM	BJB	AG	
MD-216-1000-EG-ME-PPD-1002	PLOT PLAN GENERAL PROCESS PLANT LAYOUT	A01	15/07/2020	ISSUED FOR REFERENCE	MNS	SJM	MLI	AG	

RESERVED FOR VENDOR LOGO AND DRAWING NUMBER

LARSEN & TOUBRO

This drawing is the property of LARSEN & TOUBRO and must not be passed on to any person or body not authorized by us to receive it nor be copied or otherwise made use either in full or in part by such person or body without our prior permission in writing.

Outotec

The content of these documents are the sole property of Outotec Oyj. Any rights not expressly granted herein are reserved. Reproduction, transfer or distribution of part or all of the contents in any form without prior written permission of Outotec is prohibited.

MA'ADEN معادن
Saudi Arabian Mining Company شركة معادن العربية السعودية

This document and the information contained herein is Ma'aden proprietary know-how. This document or any part thereof should not be reproduced, stored in a retrieval system or transmitted by any means, electronic or otherwise, or divulged without prior written permission of Ma'aden.

LARSEN & TOUBRO DRAWING NUMBER: 019045_450_C_D_24075_001 — REVISION: 2
OUTOTEC DRAWING NUMBER: 900707__GAU01__US01__CTB17__32107 — DOCUMENT ID: OU100691226 — REVISION: 2

DRAWN	MNS	10/07/2020
CHECKED	SJM	13/07/2020
ENGINEER	MLI	11/07/2020
APPROVED	AG	15/07/2020
EMPLOYER		
SCALE	1:150	A1

MANSOURAH - MASSARAH GOLD PROJECT
DETAIL DRAWING
CRUSHED ORE STOCKPILE AND RECLAIM
CROSS SECTION DETAILS

DRAWING NUMBER: MD-216-3210-EG-CV-DED-1143 — REV: D01