




SECTION 1-1
(SCALE-1:50)

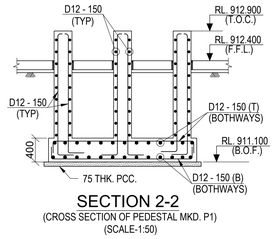


SECTION 2-2
(CROSS SECTION OF PEDESTAL MKD. P1)
(SCALE-1:50)

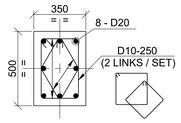


CROSS SECTION OF COLUMN MKD. C1
(4 NOS. REQUIRED)
(SCALE-1:20)

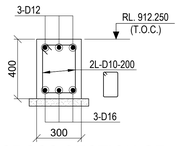


TYP. CROSS SECTION OF BEAM MKD. TB1
(SLAB REIN. NOT SHOWN FOR CLARITY)
(SCALE- 1:20)

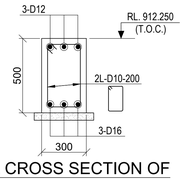


TYP. CROSS SECTION OF BEAM MKD. TB2
(SLAB REIN. NOT SHOWN FOR CLARITY)
(SCALE- 1:20)

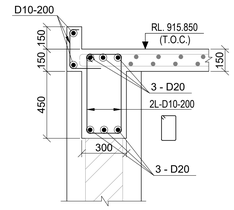


TYP. CROSS SECTION OF BEAM MKD. RB1
(SCALE- 1:20)

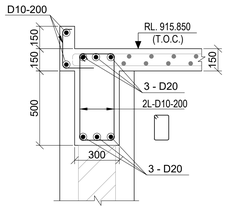


TYP. CROSS SECTION OF BEAM MKD. RB2
(SCALE- 1:20)

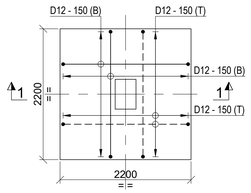


REINF. DETAIL OF FOUNDATION MKD. F1
(SCALE-1:50)

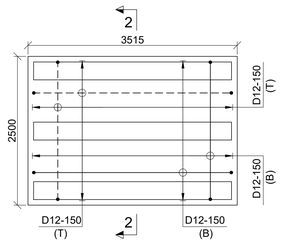


REINF. DETAIL OF FOUNDATION MKD. F2
(SCALE-1:50)

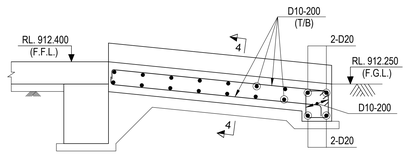


TYP. REINF. DETAIL OF RAMP
SCALE 1:20

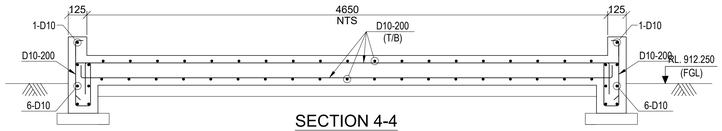


SECTION 4-4
(SCALE-1:20)

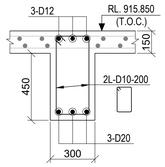


TYP. CROSS SECTION OF BEAM MKD. RB3
(SCALE- 1:20)

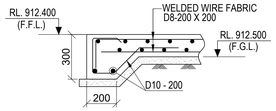


TYP. REINF. DETAIL OF SECTION 3-3
(REFER DRAWING NUMBER MD-216-3120-EG-CV-GAD-1003)
(SCALE-1:20)

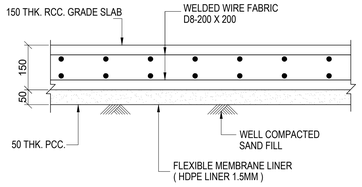

TYP. DETAIL OF 150 THK. GRADE SLAB
SCALE 1:10

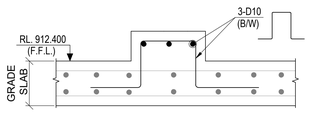

TYP. REINF. DETAIL OF SECTION 5-5 SECTION 6-6
(REFER DRAWING NUMBER MD-216-3120-EG-CV-GAD- 1001)
SCALE 1:10

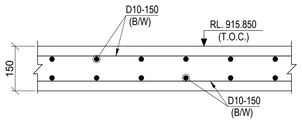

TYP. R.C. DETAIL OF 150 THK. SLAB FOR RL. 915.850
SCALE 1:10

LEGEND :-

RL. - REDUCED LEVEL
℄ - CENTRE LINE
T.O.C. - TOP OF CONCRETE.
F.G.L. - FINISHED GROUND LEVEL.
F.F.L. - FINISHED FLOOR LEVEL.
B.O.F. - BOTTOM OF FOUNDATION
B.O.B. - BOTTOM OF BEAM
TYP. - TYPICAL.
R.C.C - REINFORCED CEMENT CONCRETE
P.C.C - PLAIN CEMENT CONCRETE
MKD. - MARKED
THK. - THICK
DIA. - DIAMETER
SEC. - SECTION
IP - INSERT PLATE
MM - MILLIMETRE
SQ. - SQUARE
T.O.B. - TOP OF BEAM
T.O.I. - TOP OF INSERT
REF. - REFER
SHT. - SHEET
FDN. - FOUNDATION
DRG. NO.- DRAWING NUMBER
NTS- NOT TO SCALE
(T/B)- TOP/BOTTOM
REINF.- REINFORCEMENT

NOTES :-

1. ALL DIMENSIONS ARE IN MILLIMETRES AND LEVELS AND CO-ORDINATES ARE IN METRES. UNLESS OTHERWISE STATED.
2. GRADE OF CONCRETE SHALL BE C35 FOR FOUNDATION.
3. GRADE OF REINFORCEMENT SHALL BE DEFORMED BAR ASTM A615 - GRADE 60 (fy = 420 MPa).
4. NET SAFE BEARING CAPACITY OF SOIL AT BOTTOM OF FOUNDATION CONSIDERED 500KN/SQ. M.
5. CLEAR COVER TO MAIN REINFORCEMENT SHALL BE AS
   a) FOUNDATION = 75mm (BOTTOM & SIDE) 50 mm (TOP)
   b) WALL = 50 mm c) COLUMN = 50mm d) BEAM = 50mm e) SLAB = 40mm
6. FOR MINIMUM LAP LENGTH OF REINFORCEMENT REFER STANDARD DRAWING NO. MD-216-1000-EG-CV-DED-1005

DOCUMENT NUMBER	REFERENCE DOCUMENTS			REVISION DESCRIPTION	DRN	CHK	ENG	APP	EMP
		D01	10/03/2023	AS-BUILT	JKM	SBY	RPK	PRI	
		C02	02/08/2021	ISSUED FOR CONSTRUCTION &REVISED AS MKD C02	JKM	SBY	RPK	PRI	
		C01	16/01/2021	ISSUED FOR CONSTRUCTION	MGH	SBY	RPK	PRI	
MD-216-3210-EG-PI-LAD-V508-1001	DUST SUPPRESSION SYSTEM	A01	21/12/2020	ISSUED FOR REVIEW	MGH	SBY	RPK	PRI	

RESERVED FOR VENDOR LOGO AND DRAWING NUMBER

LARSEN & TOUBRO

This drawing is the property of LARSEN & TOUBRO and must not be passed on to any person or body not authorized by us to receive it nor be copied or otherwise made use either in full or in part by such person or body without our prior permission in writing.

Outotec

The content of these documents are the sole property of Outotec Oyj. Any rights not expressly granted herein are reserved. Reproduction, transfer or distribution of part or all of the contents in any form without prior written permission of Outotec is prohibited.

MA'ADEN معادن
Saudi Arabian Mining Company شركة معادن العربية السعودية

This document and the information contained herein is Ma'aden proprietary know-how. This document or any part thereof should not be reproduced, stored in a retrieval system or transmitted by any means, electronic or otherwise, or divulged without prior written permission of Ma'aden.

LARSEN & TOUBRO DRAWING NUMBER: O19045_450_C_D_24581_001 — REVISION: 3
OUTOTEC DRAWING NUMBER: 900707 __GAU01 __US01 __CTB05 __32101 — DOCUMENT ID: OU100709640 — REVISION: 3

DRAWN	MGH	16/12/2020
CHECKED	SBY	17/12/2020
ENGINEER	RPK	16/12/2020
APPROVED	PRI	21/12/2020
EMPLOYER		
SCALE 1:50		A1

MANSOURAH - MASSARAH GOLD PROJECT
DETAIL DRAWING
DS SYSTEM CHEMICAL DOSING HOUSE
REINFORCEMENT DETAILS

DRAWING NUMBER: MD-216-3210-EG-CV-DED-1144 — REV: D01