

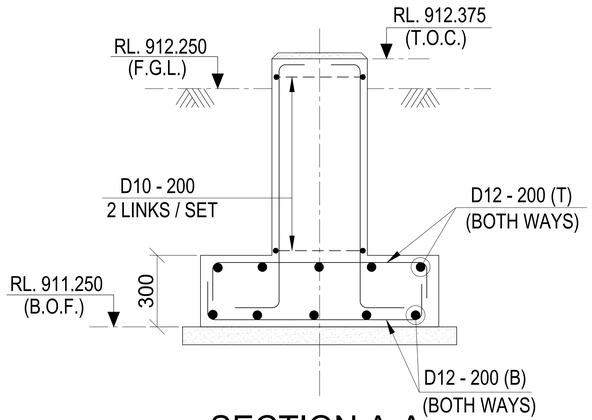


SECTION A-A
(SCALE-1:25)

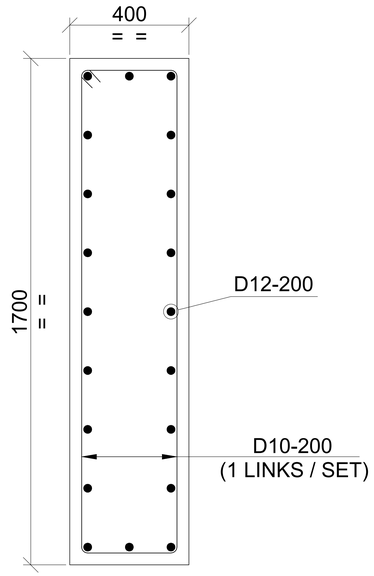


REINF. DETAIL OF PEDESTAL MKD. P1
(SCALE- 1:20)

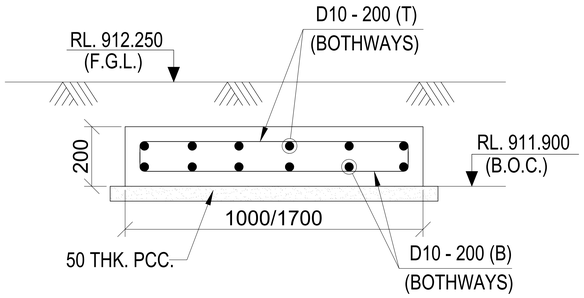


REINF. DETAIL OF 200 THK. MAT
(SCALE-1:20)

LEGENDS :-

R.L. - REDUCED LEVEL
FDN. - FOUNDATION.
T.O.C. - TOP OF CONCRETE.
F.G.L. - FINISHED GROUND LEVEL.
F.F.L. - FINISHED FLOOR LEVEL.
B.O.F. - BOTTOM OF FOUNDATION
TYP. - TYPICAL.
R.C. - REINFORCED CONCRETE
P.C.C - PLAIN CEMENT CONCRETE
MKD. - MARKED.
THK. - THICK
D - DIAMETER OF BAR
B/W - BOTH WAYS
Ld - DEVELOPMENT LENGTH
BOTTOM REINFORCEMENT (B) - ————
TOP REINFORCEMENT (T) - – – – – – –
ALTH - ALLTHROUGH
B/F - BOTHFACE
REINF. - REINFORCEMENT
DRG. - DRAWING

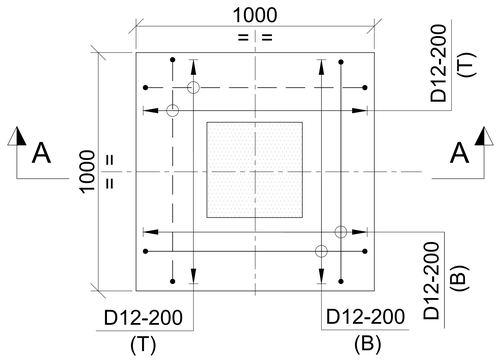

REINF. DETAIL OF FOUNDATION MKD. F1 & F2
(F1 - 2 NOS. REQUIRED)
(F2 - 1 NO. REQUIRED)
(SCALE- 1:25)

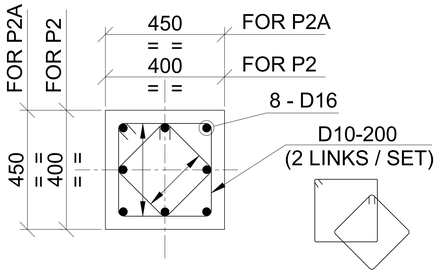

REINF. DETAIL OF PEDESTAL MKD. P2 & P2A
(SCALE- 1:20)

NOTES :-

1. ALL DIMENSIONS ARE IN MILLIMETRES AND LEVELS AND CO-ORDINATES ARE IN METRES. UNLESS OTHERWISE STATED.
2. GRADE OF CONCRETE SHALL BE C35 FOR FOUNDATION.
3. GRADE OF REINFORCEMENT SHALL BE DEFORMED BAR ASTM A615 - GRADE 60 (fy = 420 MPa).
4. NET SAFE BEARING CAPACITY OF SOIL AT BOTTOM OF FOUNDATION CONSIDERED 50KN/ SQ. M.
5. CLEAR COVER TO MAIN REINFORCEMENT SHALL BE AS
   a) FOUNDATION = 75 mm (BOTTOM & SIDE) 50 mm. (TOP)
   b) COLUMN & PEDESTAL = 50mm
   c) BEAM = 50mm
   d) SLAB = 40mm
6. FOR MINIMUM LAP LENGTH OF REINFORCEMENT REFER STANDARD DRG : MD-216-1000-EG-CV-DED-1001
7. READ THIS DRAWING IN CONJUNCTION WITH DRG: MD-216-3210-EG-CV-GAD-1145
8. FOR OTHER STANDARD REINFORCEMENT DETAILS REFER DRG : MD-216-1000-EG-CV-DED-1005

REV	DATE	REVISION DESCRIPTION	DRN	CHK	ENG	APP	EMP
D01	10/03/2023	AS-BUILT	JKM	SBY	APR	PRI	
C01	27/05/2021	ISSUED FOR CONSTRUCTION & REVISED AS MKD. △C01	MGH	SBY	APR	PRI	
A01	14/04/2021	ISSUED FOR REVIEW	MGH	SBY	APR	PRI	

RESERVED FOR VENDOR LOGO AND DRAWING NUMBER

Outotec
The content of these documents are the sole property of Outotec Oyj. Any rights not expressly granted herein are reserved. Reproduction, transfer or distribution of part or all of the contents in any form without prior written permission of Outotec is prohibited.

LARSEN & TOUBRO
This drawing is the property of LARSEN & TOUBRO and must not be passed on to any person or body not authorized by us to receive it nor be copied or otherwise made use either in full or in part by such person or body without our prior permission in writing.

MA'ADEN معادن
Saudi Arabian Mining Company شركة التعدين العربية السعودية
This document and the information contained herein is Ma'aden proprietary know-how. This document or any part thereof should not be reproduced, stored in a retrieval system or transmitted by any means, electronic or otherwise, or divulged without prior written permission of Ma'aden.

LARSEN & TOUBRO DRAWING NUMBER: O19045_450_C_D_24615_001 — REV 2
OUTOTEC DRAWING NUMBER: 900707 _ GAU01 _ US01 _ CTB05 _ 32103 — DOCUMENT ID: OU100718429 — REV 2

DRAWN	MGH	08/04/2021
CHECKED	SBY	09/04/2021
ENGINEER	APR	08/04/2021
APPROVED	PRI	14/04/2021
EMPLOYER		
SCALE	NTS	A3

MANSOURAH - MASSARAH GOLD PROJECT
DETAIL DRAWING
3210 PUMP STATION AREA PIPE SUPPORT REINFORCEMENT DETAILS

DRAWING NUMBER: MD-216-3210-EG-CV-DED-1146 — REV D01