


DRAWING NUMBER: MD-216-3210-EG-CV-DED-2001 | REV: D01

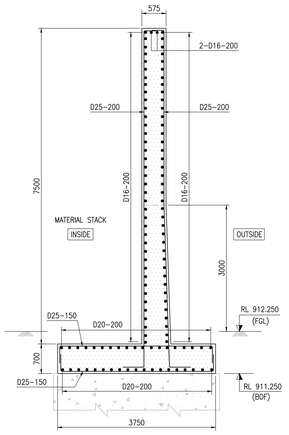


SECTION : 1-1
SCALE-(1:50)

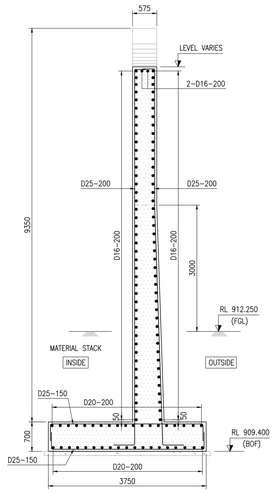


SECTION : 2-2
SCALE-(1:50)

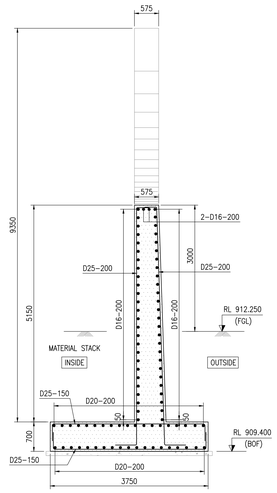

SECTION : 3-3
SCALE-(1:50)

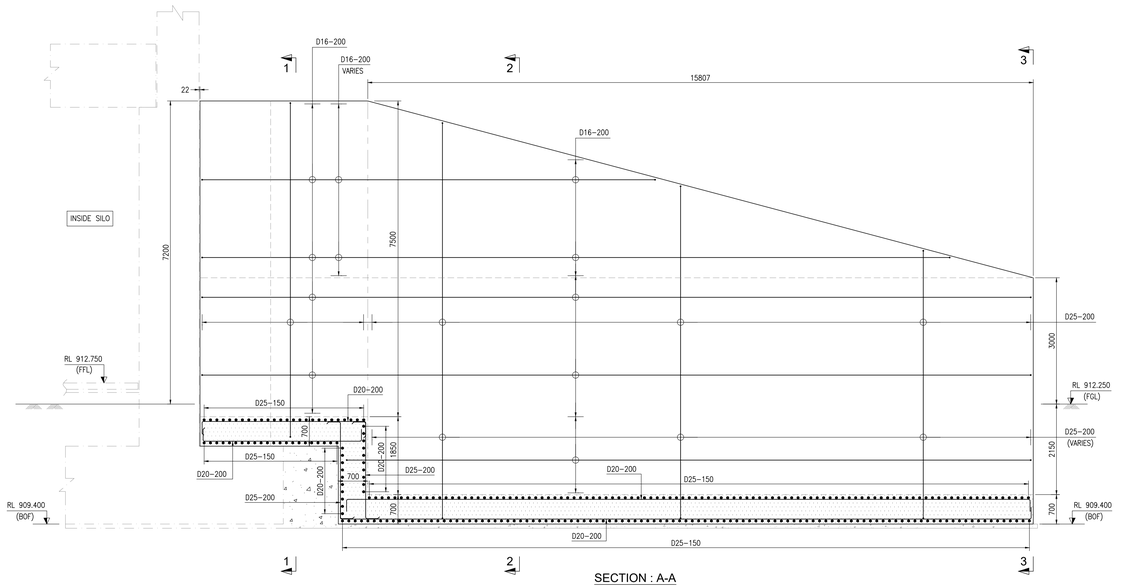

SECTION : A-A
SECTION : A1-A1 (OPPOSITE HAND)
SCALE-(1:50)

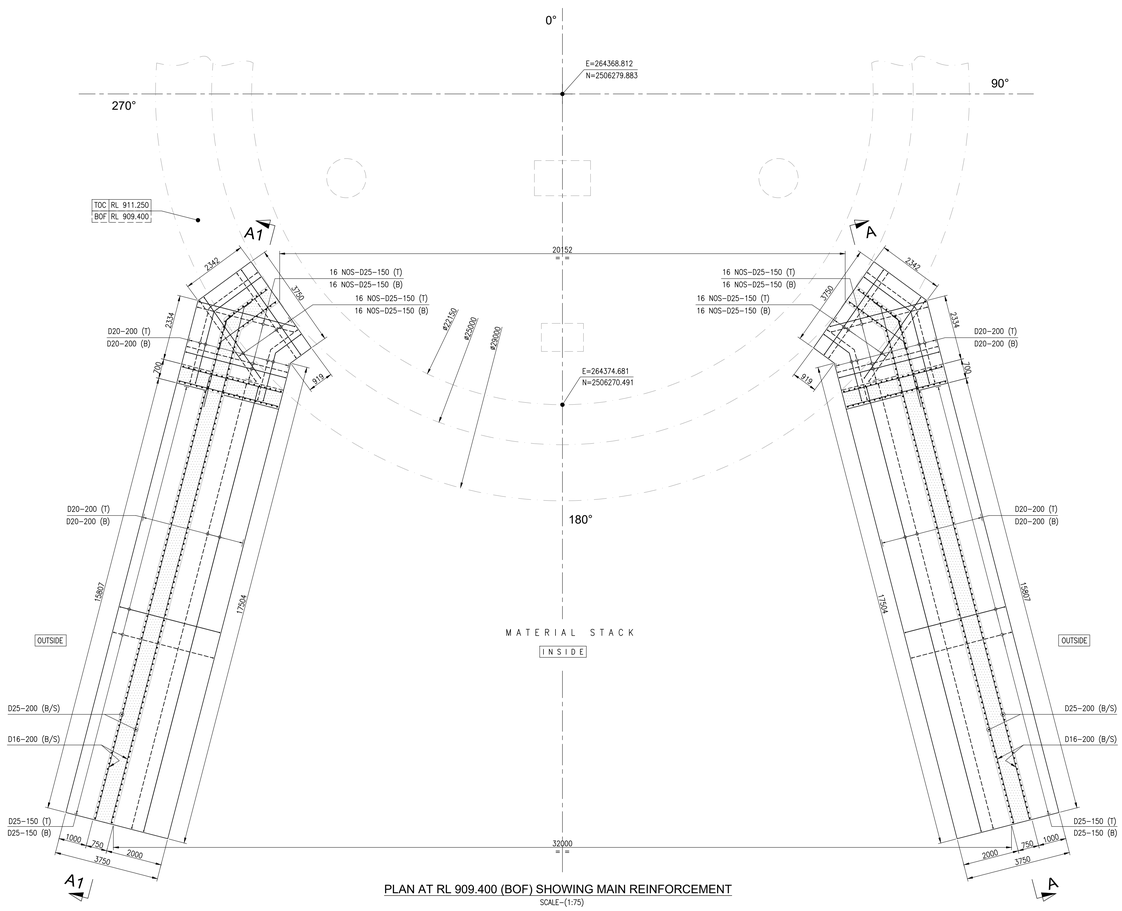

PLAN AT RL 909.400 (BOF) SHOWING MAIN REINFORCEMENT
SCALE-(1:75)

LEGEND :-

TOC = TOP OF CONCRETE
FGL = FINISHED GROUND LEVEL
BOF = BOTTOM OF FOOTING
TYP = TYPICAL
MKD = MARKED
℄ = CENTRE LINE
ø = DIAMETER
R = RADIUS
B/S = BOTH SIDE
T = TOP
B = BOTTOM
RL = REDUCED LEVEL
– – – – = TOP REINFORCEMENT
——— = BOTTOM REINFORCEMENT

NOTES :-

1. ALL DIMENSIONS ARE IN MILLIMETRES AND LEVELS AND CO-ORDINATES ARE IN METRES, UNLESS OTHERWISE STATED.
2. THIS DRAWING SHALL BE READ IN CONJUNCTION WITH DRAWING NUMBER : MD-216-3210-EG-CV-CAD-2001.
3. FOR ALL OTHER NOTES REFER DRAWING NO. MD-216-1000-EG-CV-DED-1001, 1003 & 1004.
4. GRADE OF CONCRETE SHALL BE C35.
5. GRADE OF REINFORCEMENT SHALL BE DEFORMED BAR ASTM A615-GRADE 60 (fy=420 MPa)
6. NET SAFE BEARING CAPACITY OF SOIL AT BOTTOM OF FOUNDATION CONSIDER 600KN/ SQ. M
7. IF ANY PART OF FOUNDATION COMES ON BACKFILL ZONE OF ADJACENT FOUNDATION OR ANY LOOSE SOIL ARE ENCOUNTERED BELOW FOUNDATION LEVEL THE SAME SHALL BE REMOVED AND FILLED WITH PCC.
8. CLEAR COVER TO MAIN REINFORCEMENT SHALL BE AS FOLLOWS :
   a) RAFT : 75 mm (BOTTOM & SIDE)
   b) RAFT : 50 mm (TOP)
   c) WALL : 50 mm
   e) COLUMN : 50 mm
9. MINIMUM LAP LENGTHS OF REINFORCEMENT SHALL BE 40xBAR DIAMETER.

DOCUMENT NUMBER	REFERENCE DOCUMENTS
MD-216-3210-EG-ME-ELV-1010	CRUSHED ORE BIN-SECTION
MD-216-3210-EG-ME-ELV-1009	CRUSHED ORE BIN-ELEVATION
MD-216-3210-EG-ME-LPX-1006	CRUSHED ORE BIN-PLAN
MD-216-3210-EG-ME-LPX-1005	CRUSHED ORE BIN-PLAN
MD-216-3210-EG-ME-LPX-1004	CRUSHED ORE BIN-PLAN
MD-216-3210-EG-ME-LPX-1003	CRUSHED ORE BIN-PLAN

REV	DATE	REVISION DESCRIPTION	DRN	CHK	ENG	APP	EMP
D01	10/03/2023	AS-BUILT	ABH	UR	SVK	AG	
C01	31/10/2020	ISSUED FOR CONSTRUCTION	ABH	UR	SVK	AG	
A02	08/10/2020	REVISED AS PER EMPLOYER COMMENTS	ABH	UR	SVK	AG	
A01	28/08/2020	ISSUED FOR REFERENCE	ABH	UR	SVK	AG	

RESERVED FOR VENDOR LOGO AND DRAWING NUMBER

LARSEN & TOUBRO

This drawing is the property of LARSEN & TOUBRO and must not be passed on to any person or body not authorised by us to receive it nor be copied or otherwise made use either in full or in part by such person or body without our prior permission in writing.

Outotec

The content of these documents are the sole property of Outotec Oyj. Any rights not expressly granted herein are reserved. Reproduction, transfer or distribution of part or all of the contents in any form without prior written permission of Outotec is prohibited.

MA'ADEN معادن
Saudi Arabian Mining Company شركة معادن العربية السعودية

This document and the information contained herein is Ma'aden proprietary know-how. This document or any part thereof should not be reproduced, stored in a retrieval system or transmitted by any means, electronic or otherwise, or divulged without prior written permission of Ma'aden.

LARSEN & TOUBRO DRAWING NUMBER: 019045_450_C_D_24378_001 — REVISION: 3
OUTOTEC DRAWING NUMBER: 900707__GAU01__US01__CTB17__32108 — DOCUMENT ID: OU100692099 — REVISION: 3

DRAWN	ABH	22/08/2020	MANSOURAH - MASSARAH GOLD PROJECT
CHECKED	UR	27/08/2020	DETAIL DRAWING
ENGINEER	SVK	22/08/2020	GRINDING & CLASSIFICATION
APPROVED	AG	28/08/2020	CRUSHED ORE STORAGE BIN - RETAINING WALL
EMPLOYER			
SCALE	1:50, 1:25	A0	DRAWING NUMBER: MD-216-3210-EG-CV-DED-2001 — REV: D01