

DRAWING NUMBER: MD-216-3210-EG-CV-GAD-1001 | REV: D01

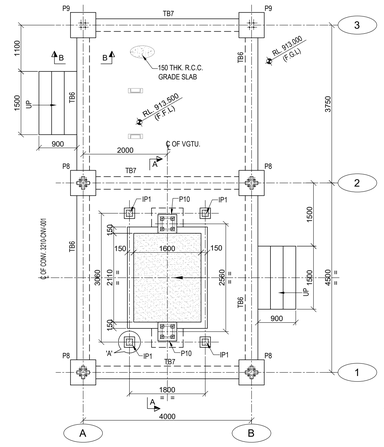


PLAN OF GRADE SLAB AT RL. 913.500 (F.F.L) AND TIE BEAM AT RL. 913.350 (T.O.B) (FOR VGTU TOWER)

(SCALE-1:50)

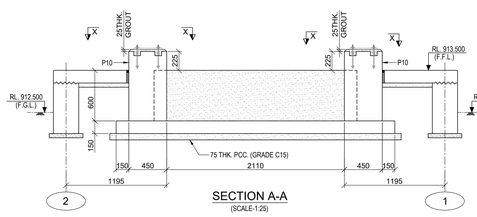


SECTION A-A

(SCALE-1:25)

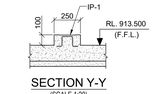


SECTION Y-Y

(SCALE 1:20)

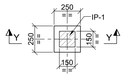


DETAIL - 'A'

(SCALE 1:20)

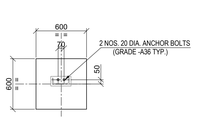


DETAIL OF PEDESTAL MKD. P1

(MIRROR FOR P1X)
(SCALE-1:25)

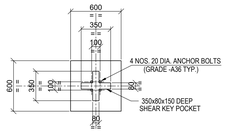


DETAIL OF PEDESTAL MKD. P2 & P3

(SCALE-1:25)

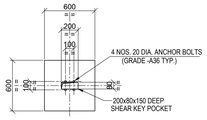


DETAIL OF PEDESTAL MKD. P4

(SCALE-1:25)

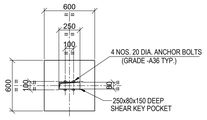


DETAIL OF PEDESTAL MKD. P5

(SCALE-1:25)

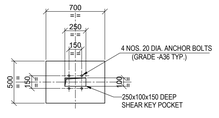


DETAIL OF PEDESTAL MKD. P6

(SCALE-1:25)

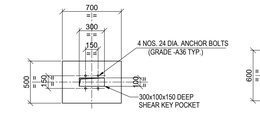


DETAIL OF PEDESTAL MKD. P7

(SCALE-1:25)

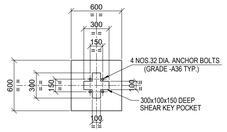


DETAIL OF PEDESTAL MKD. P8

(SCALE-1:25)

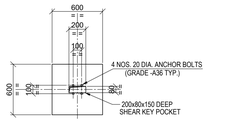

DETAIL OF PEDESTAL MKD. P9

(SCALE-1:25)

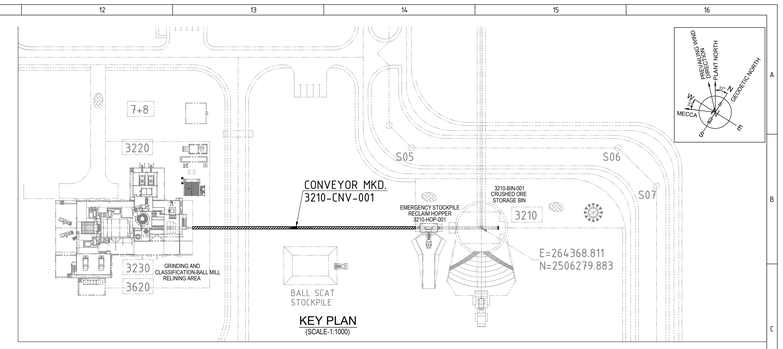


KEY PLAN

(SCALE-1:1000)


DETAIL OF INSERT PLATE - IP1

(SCALE 1:10)

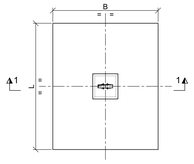


TYPICAL FOUNDATION PLAN

(TYPE-I)
(SCALE-1:50)

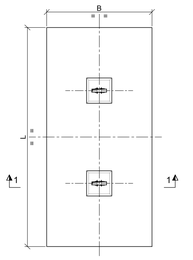

TYPICAL FOUNDATION PLAN


(TYPE-II)
(SCALE-1:50)

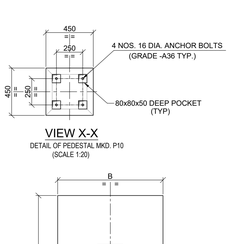

VIEW X-X


DETAIL OF PEDESTAL MKD. P10

(SCALE 1:20)

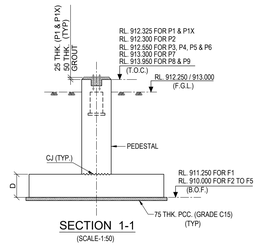


SECTION 1-1

(SCALE-1:50)

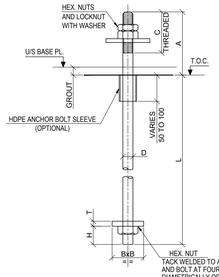


TYP. DETAIL OF BOLT

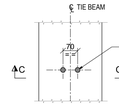


DETAIL - 'X'

(SCALE 1:10)

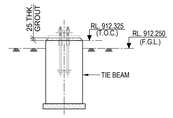

SECTION C-C

(SCALE-1:20)

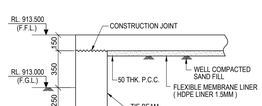

SECTION B-B

(SCALE-1:20)

SCHEDULE OF FOUNDATION


FDN. MKD.	TYPE MKD.	PEDESTAL	FOUNDATION DETAILS			F.G.L. LEV.	BOTTOM OF FDN.	TOP OF PEDESTAL	NOS. FDN.
			L	B	D				
F1	I	P1, P1X, P2, P3 & P4	2000	1500	300	RL. 912.250	RL. 911.250	RL. 912.325 FOR P1 & P1X RL. 912.300 FOR P2 RL. 912.550 FOR P3 & P4	8
F2	II	P5 & P6	5400	3200	550	RL. 912.250	RL. 910.000	RL. 912.550	2
F3	II	P7	5400	3200	550	RL. 913.000	RL. 910.000	RL. 913.300	1
F4	I	P8	3500	3000	450	RL. 913.000	RL. 910.000	RL. 913.950	4
F5	I	P9	2200	2200	450	RL. 913.000	RL. 910.000	RL. 913.950	2

SCHEDULE OF BOLTS

D BOLT DIA. MM	BxB BOTTOM PLATE (SQUARE) SQ MM	DIMENSIONS (MM)				
		L	A	C	T	H
16	50x50	350	120	100	10	30
20	60x60	450	160	140	10	30
24	75x75	600	175	125	12	30
32	100x100	800	190	140	16	35

SCHEDULE OF BEAM

BEAM MKD.	SIZE		LEVEL
	WIDTH (mm.)	DEPTH (mm.)	
TB1	350	600	RL. 912.325 (T.O.B.)
TB2	300	500	RL. 912.250 (T.O.B.)
TB3	300	600	RL. 912.250 (T.O.B.)
TB4	300	500	RL. 912.250 (T.O.B.)
TB5	300	500	RL. 913.000 (T.O.B.)
TB6	300	500	RL. 913.350 (T.O.B.)
TB7	300	600	RL. 913.350 (T.O.B.)

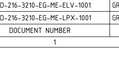

LAYOUT OF FOUNDATION

(SCALE-1:100)

LAYOUT OF FOUNDATION

(SCALE-1:100)

TYP. DETAIL OF 150 THK. GRADE SLAB

SCALE 1:10

NOTES :-

1. ALL DIMENSIONS ARE IN MILLIMETRES AND LEVELS AND CO-ORDINATES ARE IN METRES. UNLESS OTHERWISE STATED.
2. GRADE OF CONCRETE SHALL BE C35 FOR FOUNDATION.
3. GRADE OF REINFORCEMENT SHALL BE DEFORMED BAR ASTM A615 - GRADE 60 (fy = 420 MPa).
4. NET SAFE BEARING CAPACITY OF SOIL AT BOTTOM OF FOUNDATION CONSIDERED 500kN/ SQ. M.
5. CLEAR COVER TO MAIN REINFORCEMENT SHALL BE AS
   a) FOUNDATION = 75 mm (BOTTOM & SIDE) 50 mm. (TOP)
   b) COLUMN & PEDESTAL = 50mm
   c) BEAM = 50mm
   d) SLAB = 40mm
6. FOR MINIMUM LAP LENGTH OF REINFORCEMENT AND OTHER GENERAL NOTES FOR CIVIL WORKS REFER STANDARD DRG : MD-216-1000-EG-CV-DED-1001
7. THIS DRAWING IS TO BE READ IN CONJUNCTION WITH DRAWING MD - 216 - 3210 -EG -ST - GAD - 1001 TO MD - 216 - 3210 -EG -ST - GAD - 1005
8. ALL STRUCTURAL WORK SHALL CONFORM TO CIVIL STRUCTURAL DESIGN CRITERIA NO : MD - 216 - 1000 -EG -ST - CRT - 1001
9. FOR OTHER STANDARD REINFORCEMENT DETAILS REFER DRG : MD-216-1000-EG-CV-DED-1005

LEGENDS :-

R.L. - REDUCED LEVEL
℄ - CENTRE LINE
CJ - CONSTRUCTION JOINT
FDN. - FOUNDATION.
T.O.C. - TOP OF CONCRETE.
F.G.L. - FINISHED GROUND LEVEL.
F.F.L. - FINISHED FLOOR LEVEL.
B.O.F. - BOTTOM OF FOUNDATION
TYP. - TYPICAL.
B.O.B. - BOTTOM OF BEAM.
B.O.M. - BOTTOM OF MONGRAIL.
R.C.C. - REINFORCED CEMENT CONCRETE
P.C.C - PLAIN CEMENT CONCRETE
IP - INSERT PLATE
MKD. - MARKED.
THK. - THICK

DOCUMENT NUMBER	REFERENCE DOCUMENTS	REV	DATE	REVISION DESCRIPTION	DRN	CHK	ENG	APP	EMP
		D01	10/03/2023	AS-BUILT	HSK	SBY	RPK/APL	PRI	
		C03	07/01/2021	ISSUED FOR CONSTRUCTION & REVISED AS MKD. C03	HSK	SBY	RPK/APL	PRI	
MD-216-3210-EG-ME-ELV-1003	GRINDING & CLASSIFICATION CONV.3210-CNV-001-SECTION	C02	18/12/2020	ISSUED FOR CONSTRUCTION & REVISED AS MKD. C02	HSK	SBY	RPK/APL	PRI	
MD-216-3210-EG-ME-ELV-1002	GRINDING & CLASSIFICATION CONV.3210-CNV-001-ELEVATION	C01	20/05/2020	ISSUED FOR CONSTRUCTION, REVISED AS PER EMPLOYER	AMJ	SBY	RPK/APL	PRI	
MD-216-3210-EG-ME-ELV-1001	GRINDING & CLASSIFICATION CONV.3210-CNV-001-ELEVATION			COMMENTS DATED 13/05/2020 & REVISED AS MKD. C01					
MD-216-3210-EG-ME-LPX-1001	GRINDING & CLASSIFICATION CONV.3210-CNV-001-PLAN VIEW	A01	17/04/2020	ISSUED FOR REFERENCE	AMJ	SBY	RPK/APL	PRI	

RESERVED FOR VENDOR LOGO AND DRAWING NUMBER

LARSEN & TOUBRO

This drawing is the property of LARSEN & TOUBRO and must not be passed on to any person or body not authorised by us to receive it nor be copied or otherwise made use either in full or in part by such person or body without our prior permission in writing.

Outotec

The content of these documents are the sole property of Outotec Oy. Any rights not expressly granted herein are reserved. Reproduction, transfer or distribution of part or all of the contents in any form without prior written permission of Outotec is prohibited.

MA'ADEN — Saudi Arabian Mining Company — معادن شركة التعدين العربية السعودية

This document and the information contained herein is Ma'aden proprietary know-how. This document or any part thereof should not be reproduced, stored in a retrieval system or transmitted by any means, electronic or otherwise, or divulged without prior written permission of Ma'aden.

LARSEN & TOUBRO DRAWING NUMBER: 019045_450_C_G_24074_003 | REVISION: 4

OUTOTEC DRAWING NUMBER: 900707__GAU01__US01__MTL01__32129 | DOCUMENT ID: OU100680969 | REVISION: 4

DRAWN	AMJ	15/04/2020
CHECKED	SBY	16/04/2020
ENGINEER	RPK/APL	14/04/2020
APPROVED	PRI	17/04/2020
EMPLOYER		
SCALE	1:100,50,20,10	A0

MANSOURAH - MASSARAH GOLD PROJECT
GENERAL ARRANGEMENT DRAWING
GA OF CONVEYOR 3210-CNV-001
LAYOUT & DETAIL

DRAWING NUMBER: MD - 216 - 3210 - EG - CV - GAD - 1001 | REV: D01