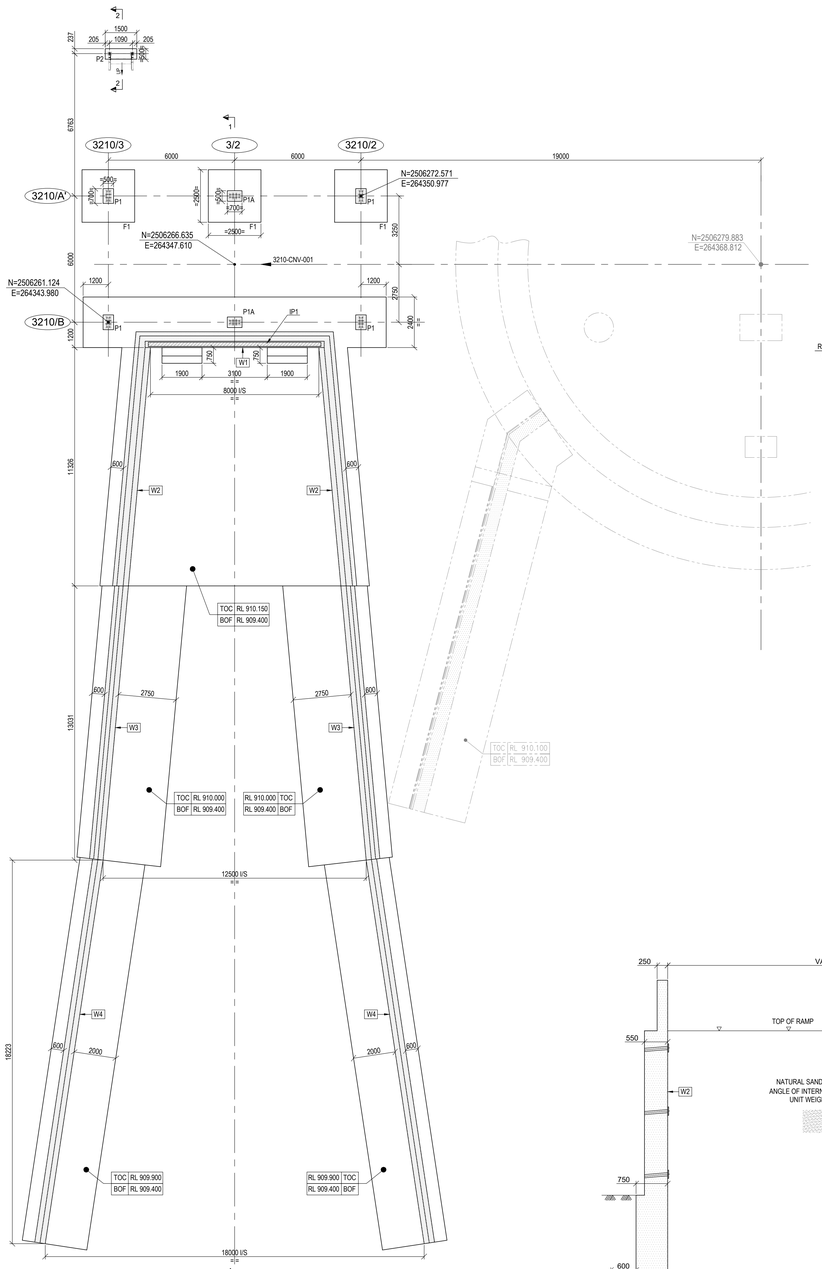
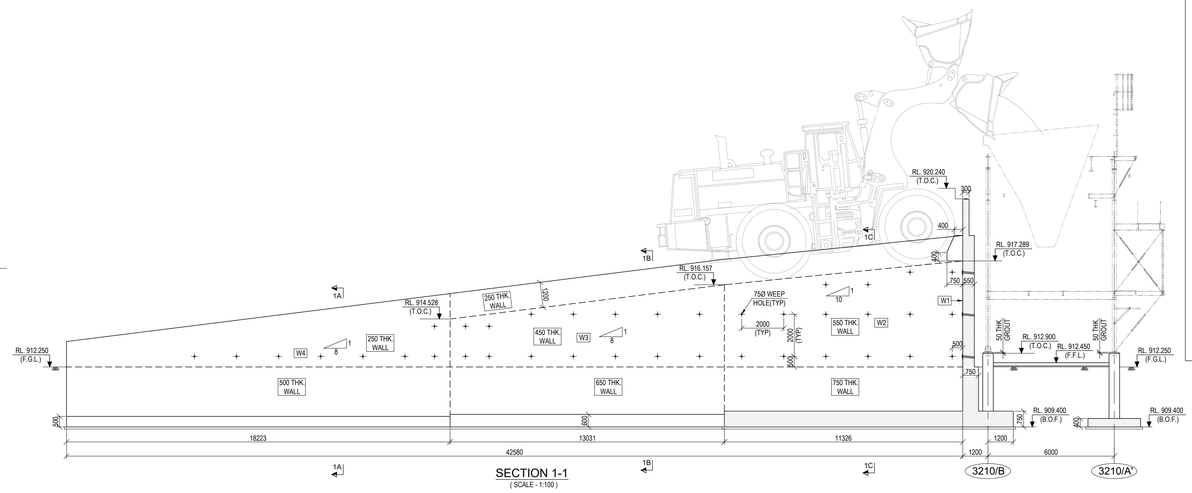
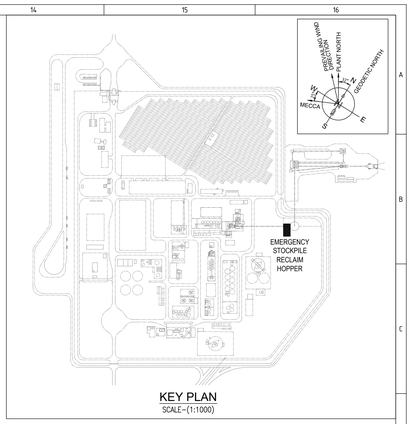
DRAWING NUMBER: MD-216-3210-EG-CV-GAD-1003 | REV: D01



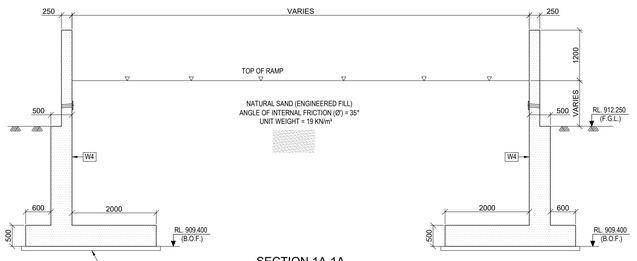

## FOUNDATION & WALL LAYOUT
( SCALE - 1:100 )



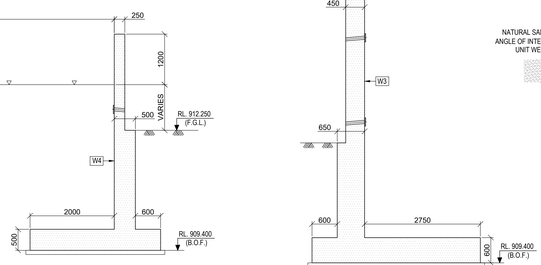

## SECTION 1-1
( SCALE - 1:100 )



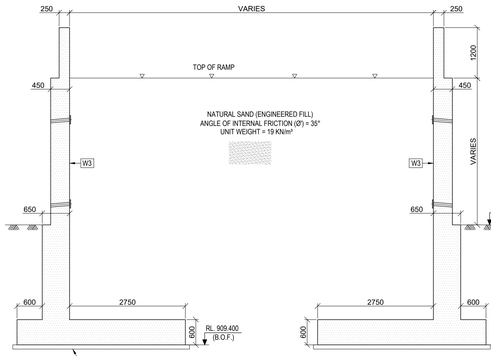

## KEY PLAN
SCALE-(1:1000)



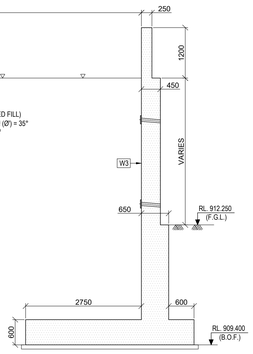

## SECTION 1A-1A
( SCALE - 1:50 )



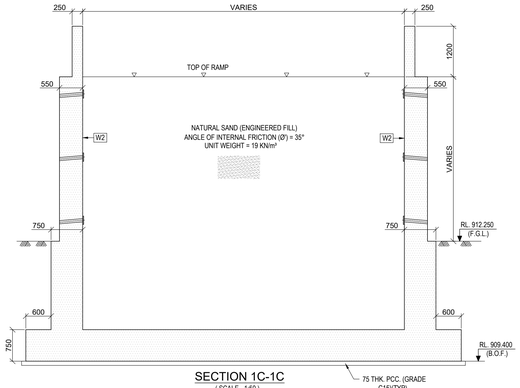

## SECTION 1B-1B
( SCALE - 1:50 )



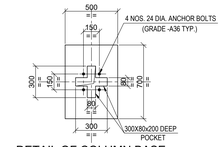

## SECTION 1B-1B
( SCALE - 1:50 )



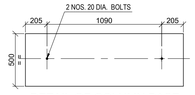

## SECTION 2-2
( SCALE - 1:20 )



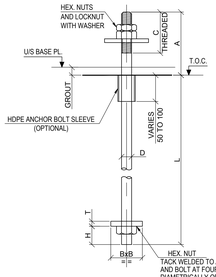

## SECTION 1C-1C
( SCALE - 1:50 )



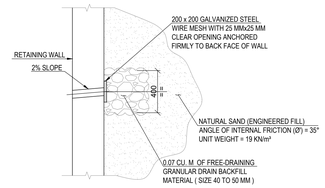

## DETAIL OF COLUMN BASE FOR PEDASTAL MKD. P1 & P1A
(P1 AS DRAWN)
(SCALE-1:20)



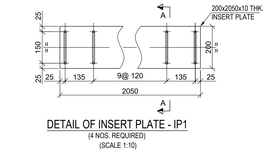

## DETAIL OF COLUMN BASE FOR PEDASTAL MKD. P2
(SCALE-1:20)



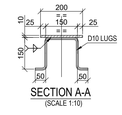

## TYP. DETAIL OF BOLT
(SCALE-1:20)




## TYP. DETAIL OF WEEP HOLE
(SCALE 1:20)




## DETAIL OF INSERT PLATE - IP1
(4 NOS. REQUIRED)
(SCALE 1:10)




## SECTION A-A
(SCALE 1:10)

THE EXCAVATED SOIL SHALL BE COMPACTED BACK TO FGL ON BOTH SIDES BEFORE BACKFILLING THE RAMP WITH ENGINEERED SAND FILL.

### SCHEDULE OF BOLTS

| D BOLT DIA. MM | BxB BOTTOM PLATE (SQUARE) SQ MM | DIMENSIONS (MM) | | | | |
|---|---|---|---|---|---|---|
| | | L | A | C | T | H |
| 24 | 75x75 | 600 | 175 | 125 | 12 | 30 |

### LEGEND :-
RL - REDUCED LEVEL
℄ - CENTRE LINE
T.O.C. - TOP OF CONCRETE
F.G.L. - FINISHED GROUND LEVEL
F.F.L. - FINISHED FLOOR LEVEL
B.O.F. - BOTTOM OF FOUNDATION
B.O.B. - BOTTOM OF BEAM
TYP. - TYPICAL
R.C.C. - REINFORCED CEMENT CONCRETE
P.C.C - PLAIN CEMENT CONCRETE
MKD. - MARKED
THK. - THICK
DIA. - DIAMETER
HEX. - HEXAGONAL
SEC. - SECTION
IP - INSERT PLATE
MM - MILLIMETRE
SQ. - SQUARE
T.O.B. - TOP OF BEAM
T.O.I. - TOP OF INSERT
REF. - REFER
SHT. - SHEET
G&C - GRINDING & CLASSIFICATION
FDN. - FOUNDATION
U/S. - UNDER SIDE
DRG. NO.- DRAWING NUMBER

### NOTES :-
1. ALL DIMENSIONS ARE IN MILLIMETRES AND LEVELS AND CO-ORDINATES ARE IN METRES. UNLESS OTHERWISE STATED.
2. GRADE OF CONCRETE SHALL BE C35 FOR FOUNDATION.
3. GRADE OF REINFORCEMENT SHALL BE DEFORMED BAR ASTM A615 - GRADE 60 (fy = 420 MPa).
4. NET SAFE BEARING CAPACITY OF SOIL AT BOTTOM OF FOUNDATION CONSIDERED 500KN/SQ. M.
5. CLEAR COVER TO MAIN REINFORCEMENT SHALL BE AS
   a) FOUNDATION = 75mm (BOTTOM & SIDE) 50 mm (TOP)
   b) WALL = 50 mm c) COLUMN = 50mm d) BEAM = 50mm e) SLAB = 40mm
6. FOR MINIMUM LAP LENGTH OF REINFORCEMENT REFER STANDARD DRAWING NO. MD-216-1000-EG-CV-DED-1005
7. THIS DRG. SHALL BE READ IN CONJUNCTION WITH DRG. NO. MD-216-3210-EG-CV-DED-1004

| DOCUMENT NUMBER | REFERENCE DOCUMENTS | REV | DATE | REVISION DESCRIPTION | DRN | CHK | ENG | APP | EMP |
|---|---|---|---|---|---|---|---|---|---|
| MD-216-3210-EG-ME-ELV-1014 | RECLAIM FEEDER 3210-FDR-005 - ELEVATION | D01 | 10/03/2023 | AS-BUILT | MGH | SBY | RPK | PRI | |
| MD-216-3210-EG-ME-LPX-1009 | EMERGENCY STOCKPILE RECLAIM HOPPER - PLAN | C02 | 07/01/2021 | ISSUED FOR CONSTRUCTION & REVISED AS MKD. (02) | MGH | SBY | RPK | PRI | |
| MD-216-3210-EG-ME-ELV-1012 | EMERGENCY STOCKPILE RECLAIM HOPPER - ELEVATION | C01 | 12/12/2020 | ISSUED FOR CONSTRUCTION | MGH | SBY | RPK | PRI | |
| MD-216-3210-EG-ME-LPX-1008 | EMERGENCY STOCKPILE RECLAIM HOPPER - PLAN | A01 | 31/10/2020 | ISSUED FOR REVIEW | MGH | SBY | RPK | PRI | |

RESERVED FOR VENDOR LOGO AND DRAWING NUMBER


LARSEN & TOUBRO

This drawing is the property of LARSEN & TOUBRO and must not be passed on to any person or body not authorized by us to receive it nor be copied or otherwise made use either in full or in part by such person or body without our prior permission in writing.

Outotec

The content of these documents are the sole property of Outotec Oyj. Any rights not expressly granted herein are reserved. Reproduction, transfer or distribution of part or all of the contents in any form without prior written permission of Outotec is prohibited.

MA'ADEN معادن
Saudi Arabian Mining Company شركة معادن العربية السعودية

This document and the information contained herein is Ma'aden proprietary know-how. This document or any part thereof should not be reproduced, stored in a retrieval system or transmitted by any means, electronic or otherwise, or divulged without prior written permission of Ma'aden.


LARSEN & TOUBRO DRAWING NUMBER: 019045_450_C_G_24567_001 | REVISION: 3
OUTOTEC DRAWING NUMBER: 900707__GAU01__US01__MTL01__32148 | DOCUMENT ID: OU100706078 | REVISION: 3

| | | |
|---|---|---|
| DRAWN | MGH | 29/10/2020 |
| CHECKED | SBY | 30/10/2020 |
| ENGINEER | RPK | 29/10/2020 |
| APPROVED | PRI | 31/10/2020 |
| EMPLOYER | | |
| SCALE | 1:100,1:75,1:50,1:25,1:20,1:10 | A0 |

MANSOURAH - MASSARAH GOLD PROJECT
GENERAL ARRANGEMENT DRAWING
G&C-EMERGENCY STOCKPILE RECLAIM HOPPER
FDN. & RAMP PLAN, ELEVATIONS & DETAILS

DRAWING NUMBER: MD - 216 - 3210 - EG - CV - GAD - 1003 | REV: D01