


DRAWING NUMBER: MD-216-3210-EG-CV-GAD-1135 | REV: D01

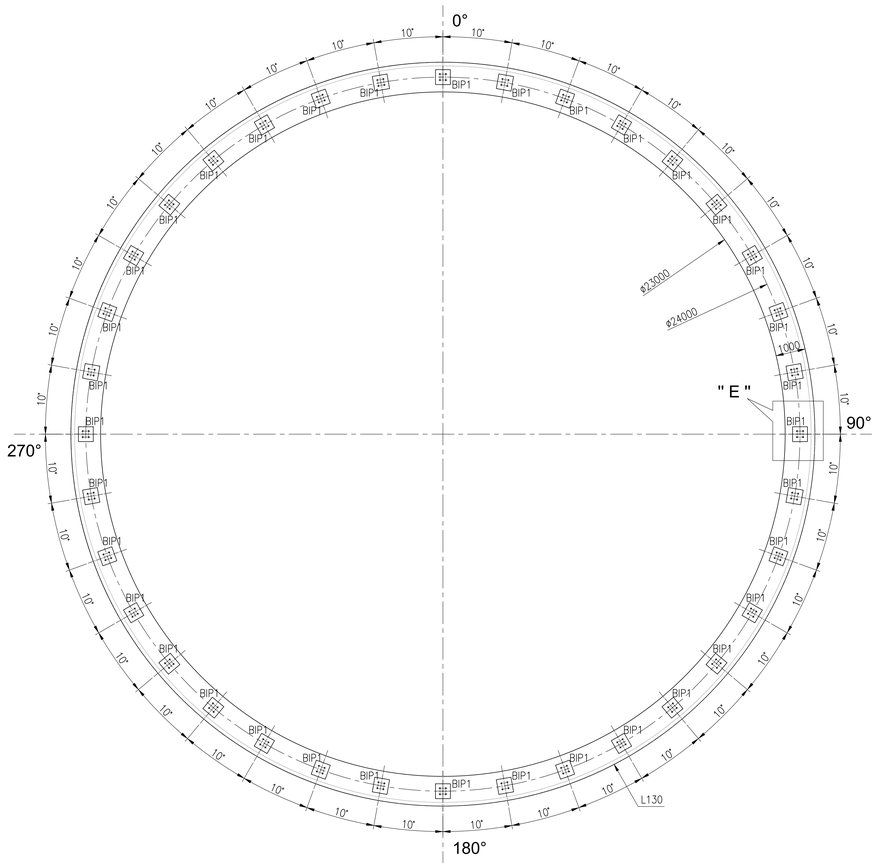


PLAN AT RL 946.060 (TOC)
SCALE–(1:100)

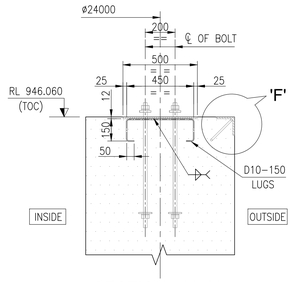

SECTION : 23-23
(SCALE 1:20)

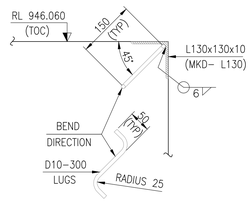

DETAIL - F
TYP DETAIL OF CURB ANGLE
(MKD.- L125)
(SCALE 1:10)

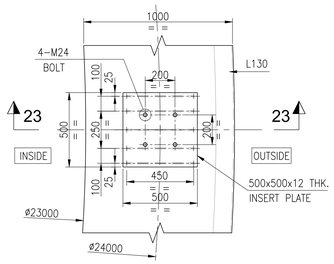

DETAIL - E
(MKD.- BIP1)
(SCALE 1:20)

LEGEND :-

TOC = TOP OF CONCRETE
PCC = PLAIN CEMENT CONCRETE
TOB = TOP OF BEAM
BOC = BOTTOM OF CONCRETE
TOS = TOP OF STRUCTURE
FGL = FINISHED GROUND LEVEL
FFL = FINISH FLOOR LEVEL
BOF = BOTTOM OF FOOTING
BOM = BOTTOM OF MONORAIL
TYP = TYPICAL
MKD = MARKED
FL = FLAT
IP = INSERT PLATE
TOI = TOP OF INSERT
MR = MONORAIL
W = WIDTH
H = HEIGHT
℄ = CENTRE LINE
THK = THICKNESS
ø = DIAMETER
R = RADIUS

NOTES :-

1. ALL DIMENSIONS ARE IN MILLIMETRES AND LEVELS AND CO–ORDINATES ARE IN METRES. UNLESS OTHERWISE STATED.
2. THIS DRAWING SHALL BE READ IN CONJUNCTION WITH DRG. NO. MD–216–3210–EG–CV–GAD–1132, 1133 & 1134.
3. FOR ALL OTHER NOTES REFER DRAWING NO. MD–216–1000–EG–CV–DED–1001, 1003 & 1004.

DOCUMENT NUMBER	REFERENCE DOCUMENTS	REV	DATE	REVISION DESCRIPTION	DRN	CHK	ENG	APP	EMP
MD-216-3210-EG-ME-ELV-1010	CRUSHED ORE BIN-SECTION								
MD-216-3210-EG-ME-ELV-1009	CRUSHED ORE BIN-ELEVATION								
MD-216-3210-EG-ME-LPX-1006	CRUSHED ORE BIN-PLAN	D01	10/03/2023	AS-BUILT	ABH	UR	SVK	AG	
MD-216-3210-EG-ME-LPX-1005	CRUSHED ORE BIN-PLAN	C02	05/01/2021	ISSUED FOR CONSTRUCTION & REVISED AS MARKED C02	ABH	UR	SVK	AG	
MD-216-3210-EG-ME-LPX-1004	CRUSHED ORE BIN-PLAN	C01	06/06/2020	ISSUED FOR CONSTRUCTION	ABH	UR	SVK	AG	
MD-216-3210-EG-ME-LPX-1003	CRUSHED ORE BIN-PLAN	A01	27/04/2020	ISSUED FOR APPROVAL	ABH	UR	SVK	AG	

RESERVED FOR VENDOR LOGO AND DRAWING NUMBER

LARSEN & TOUBRO

This drawing is the property of LARSEN & TOUBRO and must not be passed on to any person or body not authorized by us to receive it nor be copied or otherwise made use either in full or in part by such person or body without our prior permission in writing.

Outotec

The content of these documents are the sole property of Outotec Oyj. Any rights not expressly granted herein are reserved. Reproduction, transfer or distribution of part or all of the contents in any form without prior written permission of Outotec is prohibited.

MA'ADEN معادن
Saudi Arabian Mining Company شركة المعادن العربية السعودية

This document and the information contained herein is Ma'aden proprietary know-how. This document or any part thereof should not be reproduced, stored in a retrieval system or transmitted by any means, electronic or otherwise, or divulged without prior written permission of Ma'aden.

LARSEN & TOUBRO DRAWING NUMBER: O19045_450_C_G_24071_004 | REVISION: 3
OUTOTEC DRAWING NUMBER: 900707__GAU01__US01__MTL01__32124 | DOCUMENT ID: OU100673543 | REVISION: 3

DRAWN	D01	23/04/2020	
CHECKED	UR	24/04/2020	
ENGINEER	SVK	23/04/2020	
APPROVED	AG	27/04/2020	
EMPLOYER			
SCALE 1:100			A1

MANSOURAH - MASSARAH GOLD PROJECT
GENERAL ARRANGEMENT DRAWING
GRINDING & CLASSIFICATION
CRUSHED ORE STORAGE BIN - LAYOUT & DETAIL

DRAWING NUMBER: MD-216-3210-EG-CV-GAD-1135 | REV: D01