


DRAWING NUMBER MD-216-3210-EG-CV-GAD-1142 REV D01

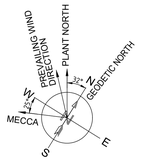

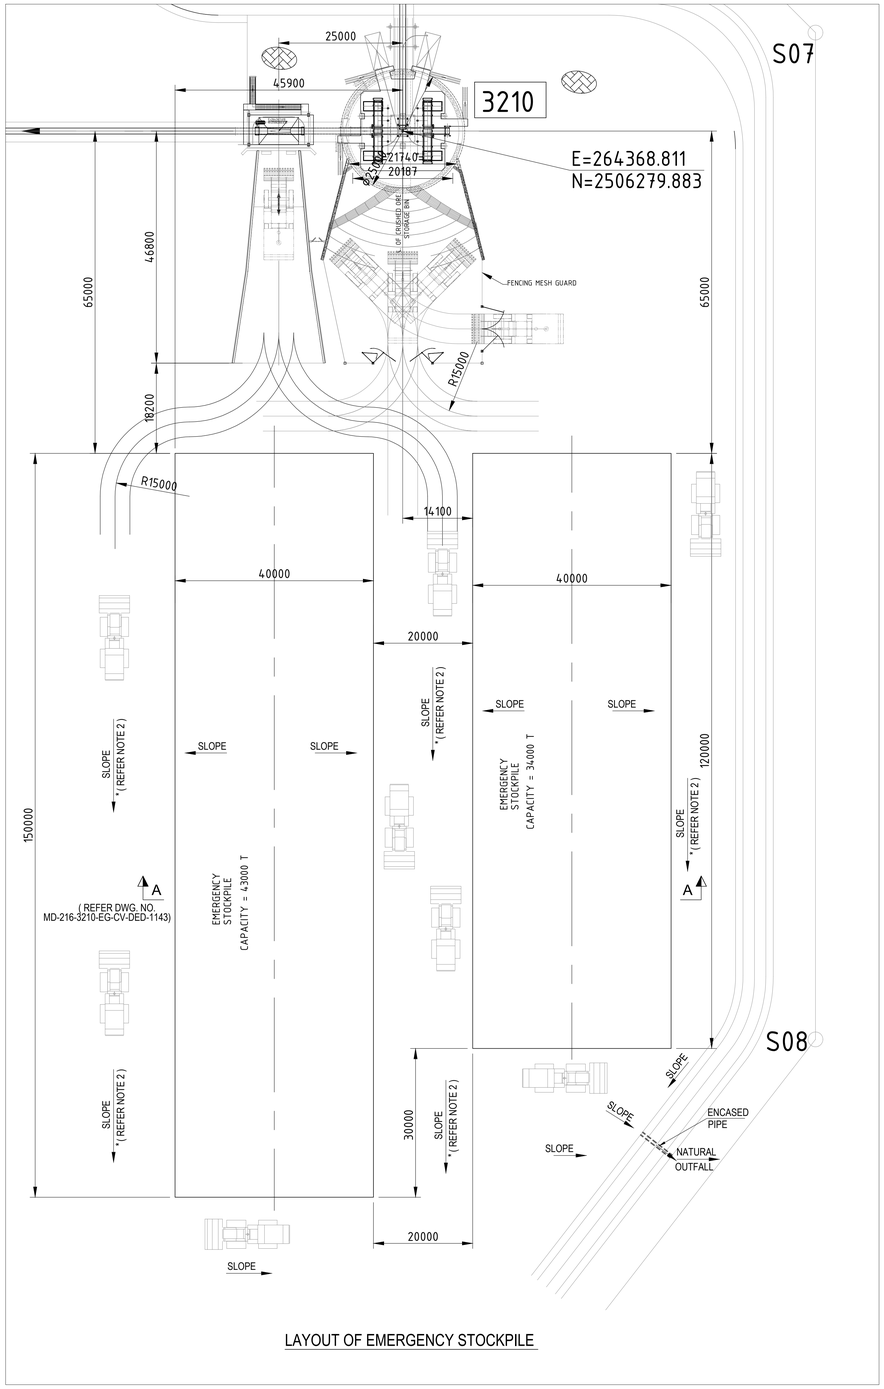

LAYOUT OF EMERGENCY STOCKPILE

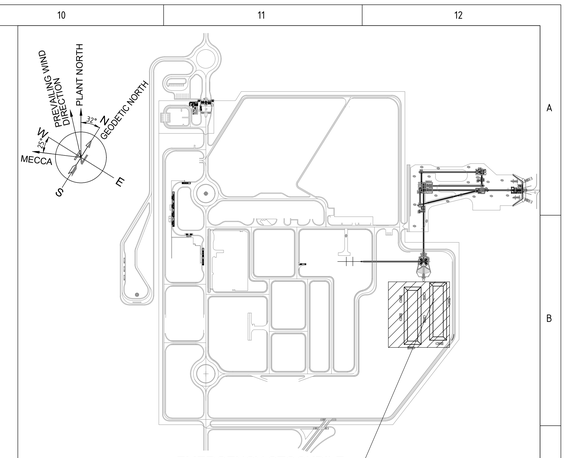

KEY PLAN



SECTION A - A

LEGEND :-

R.L. - REDUCED LEVEL
TYP. - TYPICAL
F.G.L. - FINISHED GROUND LEVEL.
DWG. NO. - DRAWING NUMBER

NOTES:-

1. ALL DIMENSIONS ARE IN MILLIMETRES.
2. EARTH TO BE FINISHED IN SLOPE 1:750.
3. CO-ORDINATES AND LEVELS ARE IN METRES.
4. CO-ORDINATES ARE ON WORLD GRID (FLAT PLANT/WORLD)
5. WORLD MAPPING GRID BASED ON UTM (WGS 84) Q38N
6. THIS DRAWING SHOULD BE READ IN CONJUNCTION WITH DWG. NO. MD-216-3210-EG-CV-DED-1143

DOCUMENT NUMBER	REFERENCE DOCUMENTS	REV	DATE	REVISION DESCRIPTION	DRN	CHK	ENG	APP	EMP
		D01	10/03/2023	AS-BUILT	DSR	SJM	BJB	AG	
MD-216-3210-EG-CV-DED-1143	CROSS SECTION DETAILS	C01	04/09/2020	ISSUED FOR CONSTRUCTION	DSR	SJM	BJB	AG	
MD-216-1000-EG-ME-PPD-1002	PLOT PLAN GENERAL PROCESS PLANT LAYOUT	A01	15/07/2020	ISSUED FOR REFERENCE	MNS	SJM	MLI	AG	

RESERVED FOR VENDOR LOGO AND DRAWING NUMBER

LARSEN & TOUBRO

This drawing is the property of LARSEN & TOUBRO and must not be passed on to any person or body not authorized by us to receive it nor be copied or otherwise made use either in full or in part by such person or body without our prior permission in writing.

Outotec

The content of these documents are the sole property of Outotec Oyj. Any rights not expressly granted herein are reserved. Reproduction, transfer or distribution of part or all of the contents in any form without prior written permission of Outotec is prohibited.

MA'ADEN معادن
Saudi Arabian Mining Company شركة التعدين العربية السعودية

This document and the information contained herein is Ma'aden proprietary know-how. This document or any part thereof should not be reproduced, stored in a retrieval system or transmitted by any means, electronic or otherwise, or divulged without prior written permission of Ma'aden.

LARSEN & TOUBRO DRAWING NUMBER: O19045_450_C_G_24074_001 — REVISION: 2

OUTOTEC DRAWING NUMBER: 900707__GAU01__US01__MTL01__32141 — DOCUMENT ID: OU100691225 — REVISION: 2

DRAWN	MNS	10/07/2020
CHECKED	SJM	13/07/2020
ENGINEER	MLI	11/07/2020
APPROVED	AG	15/07/2020
EMPLOYER		
SCALE	1:500	A1

MANSOURAH - MASSARAH GOLD PROJECT
GENERAL ARRANGEMENT DRAWING
CRUSHED ORE STOCKPILE AND RECLAIM LAYOUT

DRAWING NUMBER: MD-216-3210-EG-CV-GAD-1142 — REV: D01