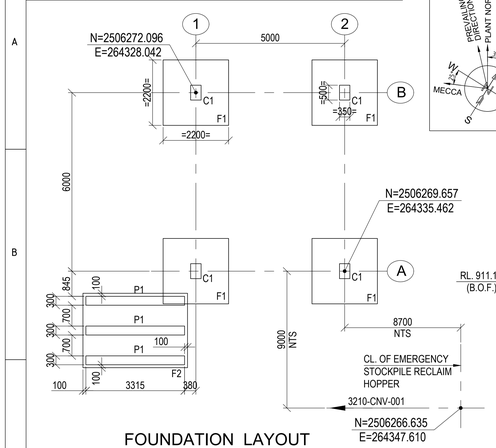
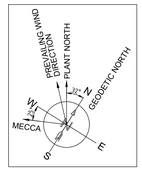
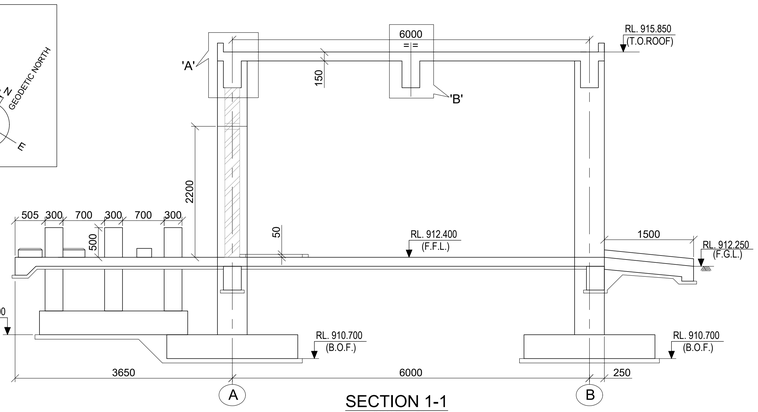
DRAWING NUMBER: MD - 216 - 3210 - EG - CV - GAD - 1143
REV: D01

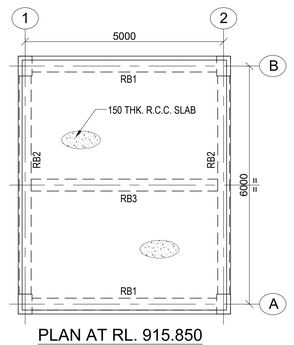



FOUNDATION LAYOUT
( SCALE - 1:100 )

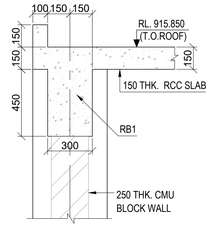



SECTION 1-1
( SCALE - 1:50 )




PLAN AT RL. 915.850
( SCALE - 1:75 )



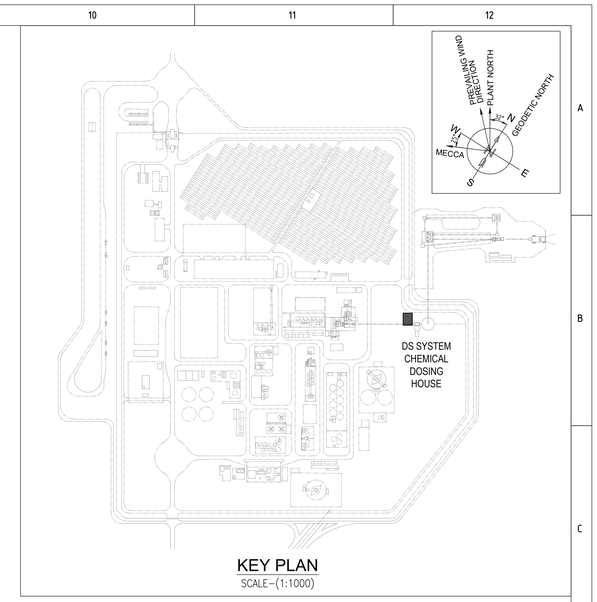

DETAIL-A
( SCALE - 1:20 )



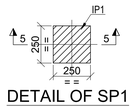

DETAIL-D
( SCALE - 1:20 )



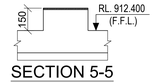

DETAIL-E
( SCALE - 1:20 )



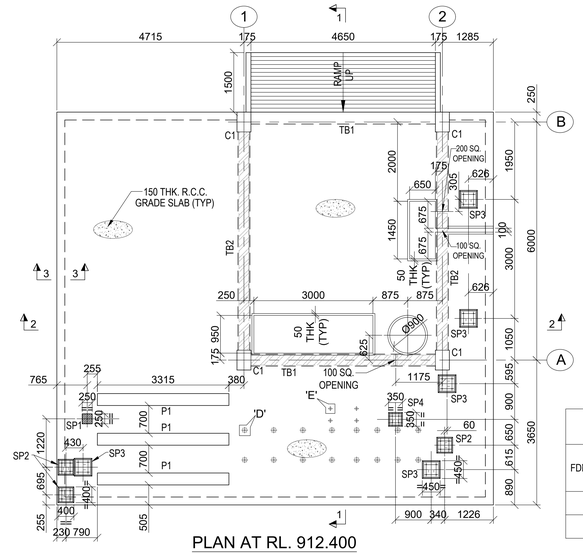

KEY PLAN
SCALE-(1:1000)




DETAIL OF SP1
( SCALE - 1:20 )



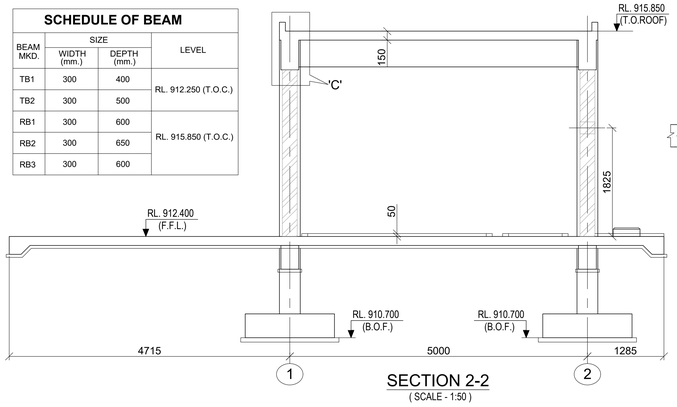

SECTION 5-5
(SCALE-1:20)



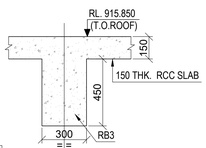

PLAN AT RL. 912.400
( SCALE - 1:75 )

**SCHEDULE OF BEAM**

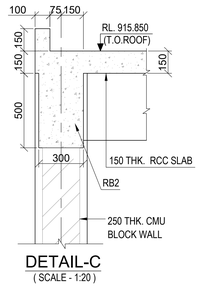
| BEAM MKD. | SIZE WIDTH (mm.) | SIZE DEPTH (mm.) | LEVEL |
|---|---|---|---|
| TB1 | 300 | 400 | RL. 912.250 (T.O.C.) |
| TB2 | 300 | 500 | |
| RB1 | 300 | 600 | RL. 915.850 (T.O.C.) |
| RB2 | 300 | 650 | |
| RB3 | 300 | 600 | |



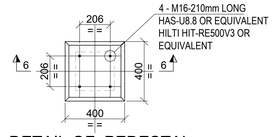

SECTION 2-2
( SCALE - 1:50 )



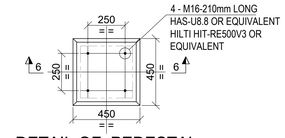

DETAIL-B
( SCALE - 1:20 )




DETAIL-C
( SCALE - 1:20 )



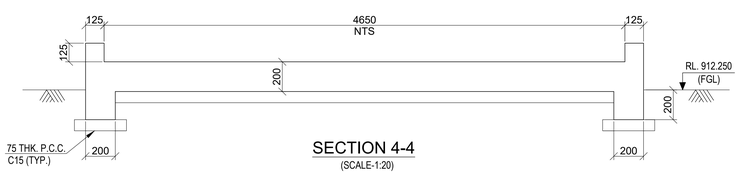

DETAIL OF PEDESTAL MKD. SP2
(SCALE-1:20)



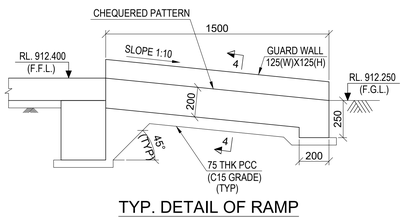

DETAIL OF PEDESTAL MKD. SP3
(SCALE-1:20)

**SCHEDULE OF FOUNDATION**

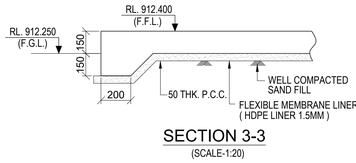
| FDN. MKD. | PEDESTAL/COLUMN MKD. | FOUNDATION DETAILS L | B | D | BOTTOM OF FDN. | TOP OF PEDESTAL/COLUMN | NOS. FDN. |
|---|---|---|---|---|---|---|---|
| F1 | C1 | 2200 | 2200 | 400 | RL. 910.700 | RL. 911.150 | 4 |
| F2 | P1 | 3515 | 2500 | 400 | RL. 911.100 | RL. 912.900 | 1 |



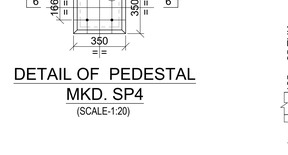

SECTION 4-4
(SCALE-1:20)



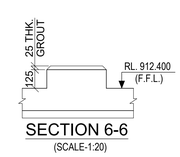

TYP. DETAIL OF RAMP
SCALE 1:20



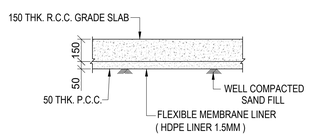

SECTION 3-3
(SCALE-1:20)



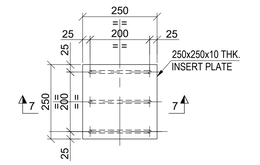

DETAIL OF PEDESTAL MKD. SP4
(SCALE-1:20)



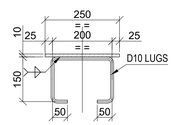

SECTION 6-6
(SCALE-1:20)




TYP. DETAIL OF 150 THK. GRADE SLAB
SCALE 1:20




DETAIL OF INSERT PLATE - IP1
(SCALE 1:10)




SECTION 7-7
(SCALE 1:10)

**LEGEND :-**

RL. - REDUCED LEVEL
℄ - CENTRE LINE
T.O.C. - TOP OF CONCRETE.
F.G.L. - FINISHED GROUND LEVEL.
F.F.L. - FINISHED FLOOR LEVEL.
B.O.F. - BOTTOM OF FOUNDATION
B.O.B. - BOTTOM OF BEAM
TYP. - TYPICAL.
R.C.C - REINFORCED CEMENT CONCRETE
P.C.C - PLAIN CEMENT CONCRETE
MKD. - MARKED
THK. - THICK
DIA. - DIAMETER
SEC. - SECTION
IP - INSERT PLATE
MM - MILLIMETRE
SQ. - SQUARE
T.O.B. - TOP OF BEAM
T.O.I. - TOP OF INSERT
REF. - REFER
SHT. - SHEET
FDN. - FOUNDATION
DRG. NO.- DRAWING NUMBER
NTS- NOT TO SCALE
T.O.ROOF - TOP OF ROOF
CMU - CONCRETE MASONRY UNIT

**NOTES :-**

1. ALL DIMENSIONS ARE IN MILLIMETRES AND LEVELS AND CO-ORDINATES ARE IN METRES. UNLESS OTHERWISE STATED.
2. GRADE OF CONCRETE SHALL BE C35 FOR FOUNDATION.
3. GRADE OF REINFORCEMENT SHALL BE DEFORMED BAR ASTM A615 - GRADE 60 (fy = 420 MPa).
4. NET SAFE BEARING CAPACITY OF SOIL AT BOTTOM OF FOUNDATION CONSIDERED 50KN/ SQ. M.
5. CLEAR COVER TO MAIN REINFORCEMENT SHALL BE AS
   a) FOUNDATION = 75mm (BOTTOM & SIDE) 50 mm (TOP)
   b) WALL = 50 mm c) COLUMN = 50mm d) BEAM = 50mm e) SLAB = 40mm
6. FOR MINIMUM LAP LENGTH OF REINFORCEMENT REFER STANDARD DRAWING NO. MD-216-1000-EG-CV-DED-1005

| DOCUMENT NUMBER | REFERENCE DOCUMENTS | REV | DATE | REVISION DESCRIPTION | DRN | CHK | ENG | APP | EMP |
|---|---|---|---|---|---|---|---|---|---|
| | | D01 | 10/03/2023 | AS-BUILT | JKM | SBY | RPK | PRI | |
| | | C03 | 02/08/2021 | ISSUED FOR CONSTRUCTION & REVISED AS MKD. C03 | JKM | SBY | RPK | PRI | |
| | | C02 | 26/05/2021 | ISSUED FOR CONSTRUCTION & REVISED AS MKD. C02 | MGH | SBY | RPK | PRI | |
| | | C01 | 28/01/2021 | ISSUED FOR CONSTRUCTION | MGH | SBY | RPK | PRI | |
| MD-216-3210-EG-PI-LAD-V508-1001 | DUST SUPPRESSION SYSTEM | A01 | 21/12/2020 | ISSUED FOR REVIEW | MGH | SBY | RPK | PRI | |

RESERVED FOR VENDOR LOGO AND DRAWING NUMBER

LARSEN & TOUBRO

This drawing is the property of LARSEN & TOUBRO and must not be passed on to any person or body not authorized by us to receive it nor be copied or otherwise made use either in full or in part by such person or body without our prior permission in writing.

Outotec

The content of these documents are the sole property of Outotec Oyj. Any rights not expressly granted herein are reserved. Reproduction, transfer or distribution of part or all of the contents in any form without prior written permission of Outotec is prohibited.

MA'ADEN معادن
Saudi Arabian Mining Company شركة معادن العربية السعودية

This document and the information contained herein is Ma'aden proprietary know-how. This document or any part thereof should not be reproduced, stored in a retrieval system or transmitted by any means, electronic or otherwise, or divulged without prior written permission of Ma'aden.

LARSEN & TOUBRO DRAWING NUMBER: 019045_450_C_G_24580_001 — REVISION: 4
OUTOTEC DRAWING NUMBER: 900707__GAU01__US01__MTL01__32151 — DOCUMENT ID: OU100709639 — REVISION: 4

| | | |
|---|---|---|
| DRAWN | MGH | 16/12/2020 |
| CHECKED | SBY | 17/12/2020 |
| ENGINEER | RPK | 16/12/2020 |
| APPROVED | PRI | 21/12/2020 |
| EMPLOYER | | |
| SCALE 1:50 | | A1 |

MANSOURAH - MASSARAH GOLD PROJECT
GENERAL ARRANGEMENT DRAWING
DS SYSTEM CHEMICAL DOSING HOUSE
FOUNDATION LAYOUT, FLOOR PLAN & DETAILS

DRAWING NUMBER: MD - 216 - 3210 - EG - CV - GAD - 1143 — REV: D01