

DRAWING NUMBER MD-216-3210-EG-CV-GAD-1144 REV D01

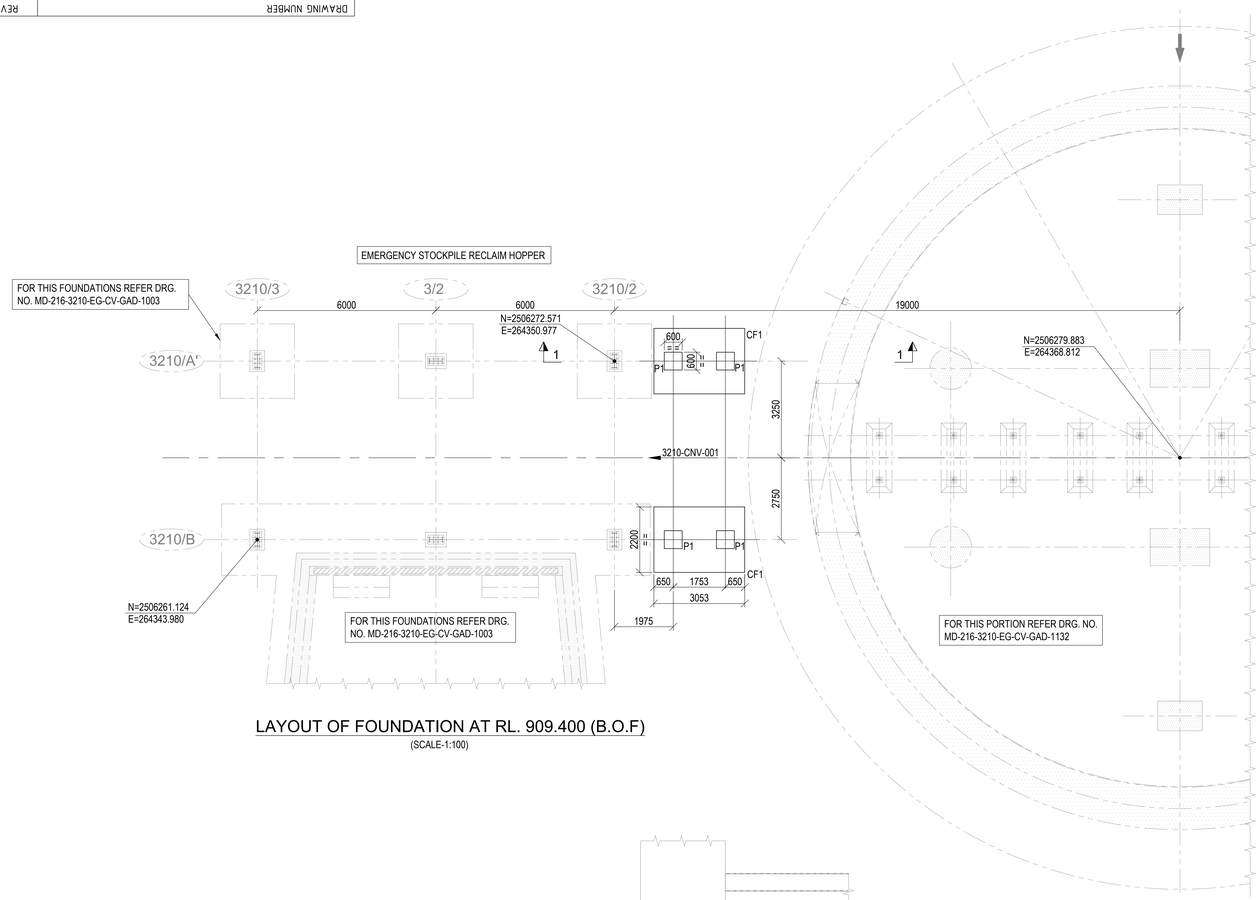


LAYOUT OF FOUNDATION AT RL. 909.400 (B.O.F)

(SCALE-1:100)

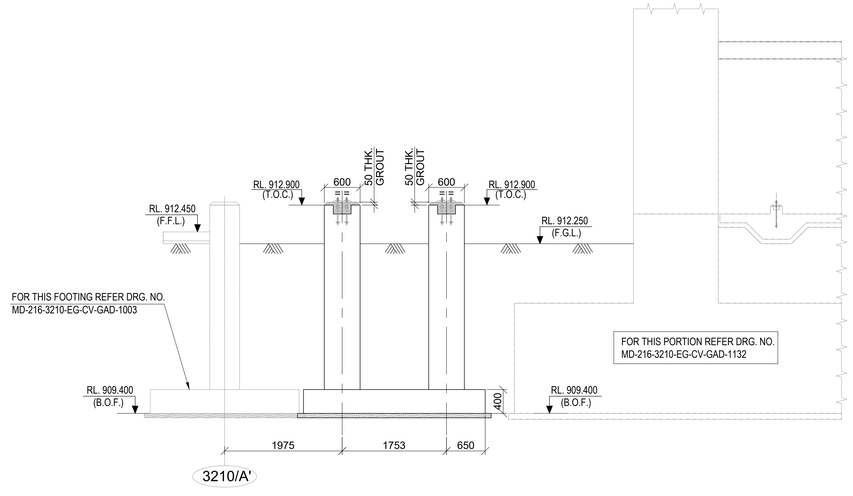

SECTION 1-1


(SCALE - 1:50)

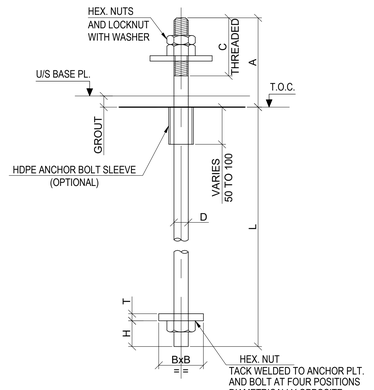

TYP. DETAIL OF BOLT


(SCALE-1:20)

SCHEDULE OF BOLTS						
D BOLT DIA. MM	BxB BOTTOM PLATE (SQUARE) SQ MM	DIMENSIONS (MM)				
		L	A	C	T	H
20	60x60	450	160	110	10	30

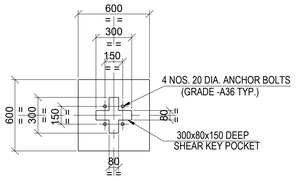

DETAIL OF PEDESTAL MKD. P1

(SCALE-1:25)

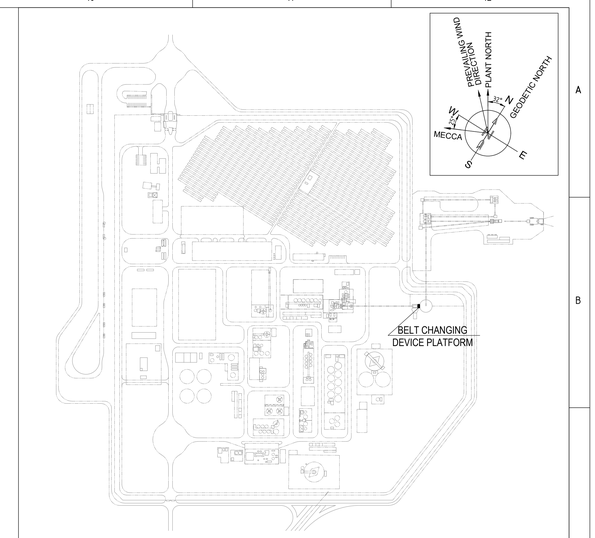

KEY PLAN

SCALE-(1:1000)

LEGEND :-

R.L. - REDUCED LEVEL
℄ - CENTRE LINE
CJ - CONSTRUCTION JOINT
FDN. - FOUNDATION.
T.O.C. - TOP OF CONCRETE.
F.G.L. - FINISHED GROUND LEVEL.
F.F.L. - FINISHED FLOOR LEVEL.
B.O.F. - BOTTOM OF FOUNDATION
TYP. - TYPICAL
B.O.B. - BOTTOM OF BEAM.
B.O.M. - BOTTOM OF MONORAIL.
R.C.C - REINFORCED CEMENT CONCRETE
P.C.C - PLAIN CEMENT CONCRETE
IP - INSERT PLATE
MKD. - MARKED.
THK. - THICK
HEX. = HEXAGONAL
PLT. = PLATE
DRG. = DRAWING

NOTES :-

1. ALL DIMENSIONS ARE IN MILLIMETRES AND LEVELS AND CO-ORDINATES ARE IN METRES. UNLESS OTHERWISE STATED.
2. GRADE OF CONCRETE SHALL BE C35 FOR FOUNDATION.
3. GRADE OF REINFORCEMENT SHALL BE DEFORMED BAR ASTM A615 - GRADE 60 (fy = 420 MPa).
4. NET SAFE BEARING CAPACITY OF SOIL AT BOTTOM OF FOUNDATION CONSIDERED 500KN/ SQ. M.
5. CLEAR COVER TO MAIN REINFORCEMENT SHALL BE AS
   a) FOUNDATION = 75 mm (BOTTOM & SIDE) 50 mm. (TOP)
   b) COLUMN & PEDESTAL = 50mm
   c) BEAM = 50mm
   d) SLAB = 40mm
6. FOR MINIMUM LAP LENGTH OF REINFORCEMENT AND OTHER GENERAL NOTES FOR CIVIL WORKS REFER STANDARD DRG : MD-216-1000-EG-CV-DED-1001
7. THIS DRAWING IS TO BE READ IN CONJUNCTION WITH DRAWING MD - 216 - 3210 -EG -ST - GAD - 2137 & MD - 216 - 3210 -EG -ST - GAD - 2138
8. ALL STRUCTURAL WORK SHALL CONFORM TO CIVIL STRUCTURAL DESIGN CRITERIA NO. MD - 216 - 1000 -EG -ST - CRT - 1001
9. FOR OTHER STANDARD REINFORCEMENT DETAILS REFER DRG : MD-216-1000-EG-CV-DED-1005

DOCUMENT NUMBER	REFERENCE DOCUMENTS	REV	DATE	REVISION DESCRIPTION	DRN	CHK	ENG	APP	EMP
		D01	10/03/2023	AS-BUILT	JKM	SBY	RPK	PRI	
MD-216-3210-EG-ST-GAD-2138	G&C-EMERGENCY STOCKPILE RECLAIM HOPPER	C01	09/04/2021	ISSUED FOR CONSTRUCTION	JKM	SBY	RPK	PRI	
MD-216-3210-EG-ST-GAD-2137	G&C-EMERGENCY STOCKPILE RECLAIM HOPPER	A01	03/03/2021	ISSUED FOR REVIEW	JKM	SBY	RPK	PRI	

RESERVED FOR VENDOR LOGO AND DRAWING NUMBER

LARSEN & TOUBRO

This drawing is the property of *LARSEN & TOUBRO* and must not be passed on to any person or body not authorized by us to receive it nor be copied or otherwise made use either in full or in part by such person or body without our prior permission in writing.

Outotec

The content of these documents are the sole property of Outotec Oyj. Any rights not expressly granted herein are reserved. Reproduction, transfer or distribution of part or all of the contents in any form without prior written permission of Outotec is prohibited.

MA'ADEN معادن
Saudi Arabian Mining Company شركة معادن العربية السعودية

This document and the information contained herein is Ma'aden proprietary know-how. This document or any part thereof should not be reproduced, stored in a retrieval system or transmitted by any means, electronic or otherwise, or divulged without prior written permission of Ma'aden.

LARSEN & TOUBRO DRAWING NUMBER: O19045_450_C_G_24604_001 — REVISION: 2

OUTOTEC DRAWING NUMBER: 900707__GAU01__US01__MTL01__32152 — DOCUMENT ID: OU100712933 — REVISION: 2

DRAWN	JKM	23/02/2021
CHECKED	SBY	27/02/2021
ENGINEER	RPK	22/02/2021
APPROVED	PRI	03/03/2021
EMPLOYER		
SCALE	1:100,25,20	A1

MANSOURAH - MASSARAH GOLD PROJECT
GENERAL ARRANGEMENT DRAWING
BELT CHANGING PLATFORM FOR FDR. 3210-FDR-005
FOUNDATION LAYOUT & DETAILS

DRAWING NUMBER: MD-216-3210-EG-CV-GAD-1144 — REV: D01