


DRAWING NUMBER MD-216-3210-EG-CV-GAD-1145 REV D01

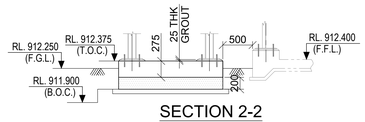


SECTION 2-2
(SCALE-1:50)

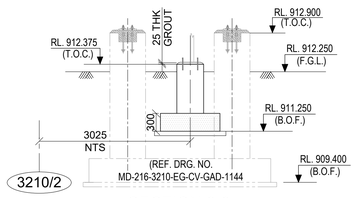


SECTION 3-3
(SCALE-1:50)

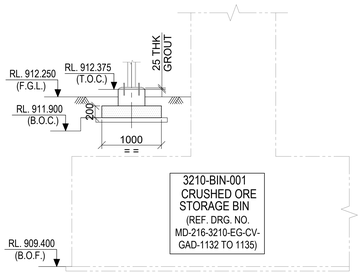

SECTION 4 - 4
(SCALE-1:50)

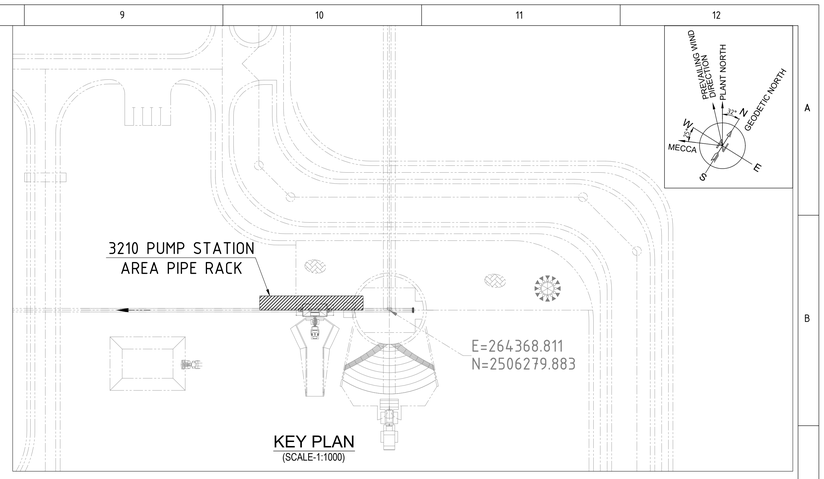


KEY PLAN
(SCALE-1:1000)

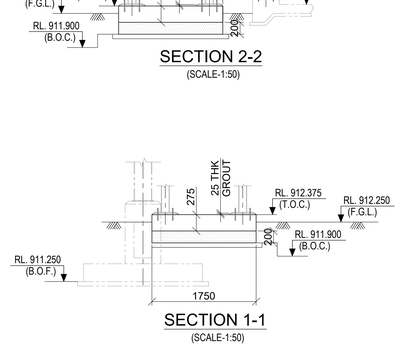


SECTION 1-1
(SCALE-1:50)

SCHEDULE OF FOUNDATION


FDN. MKD.	PEDESTAL MKD.	FOUNDATION DETAILS			F.G.L. LEV.	BOTTOM OF FDN.	TOP OF CONCRETE	NOS. FDN.
		L	B	D				
F1	P2	1000	1000	300	RL. 912.250	RL. 911.250	RL. 912.375	2
F2	P2A	1000	1000	300	RL. 912.250	RL. 911.250	RL. 912.375	1

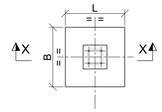


TYPICAL DETAIL OF FOUNDATION
(SCALE-1:50)

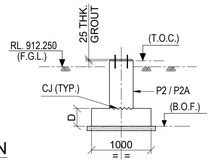


SECTION X-X
(SCALE-1:50)

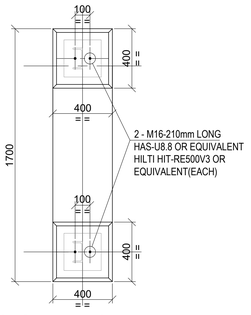


DETAIL OF PEDESTAL MKD. P1
(SCALE-1:20)

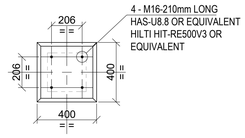



DETAIL OF PEDESTAL MKD. P2
(SCALE-1:20)

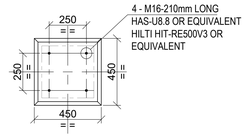


DETAIL OF PEDESTAL MKD. P2A
(SCALE-1:20)

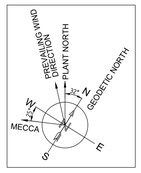

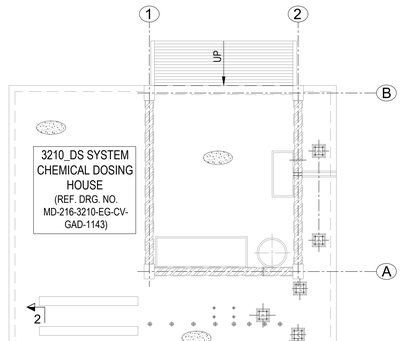

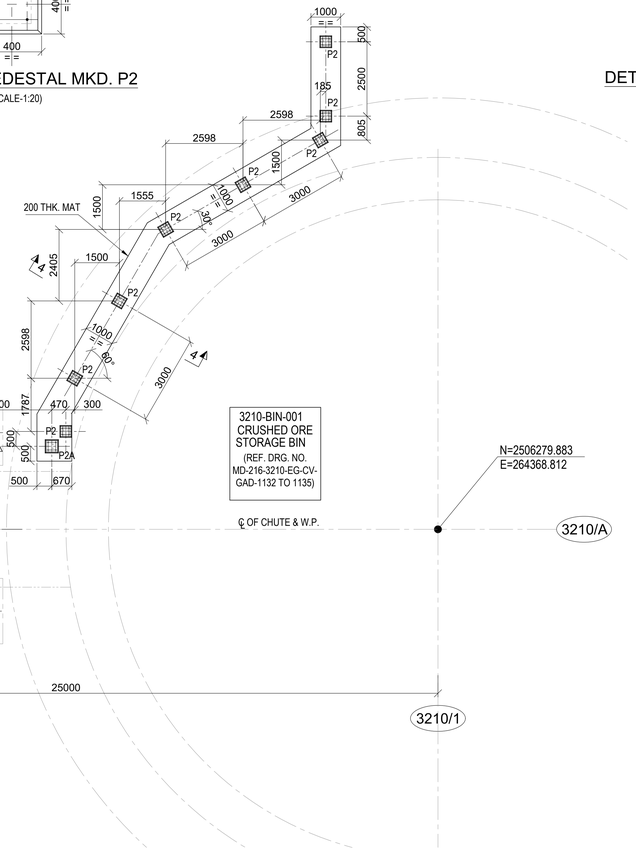

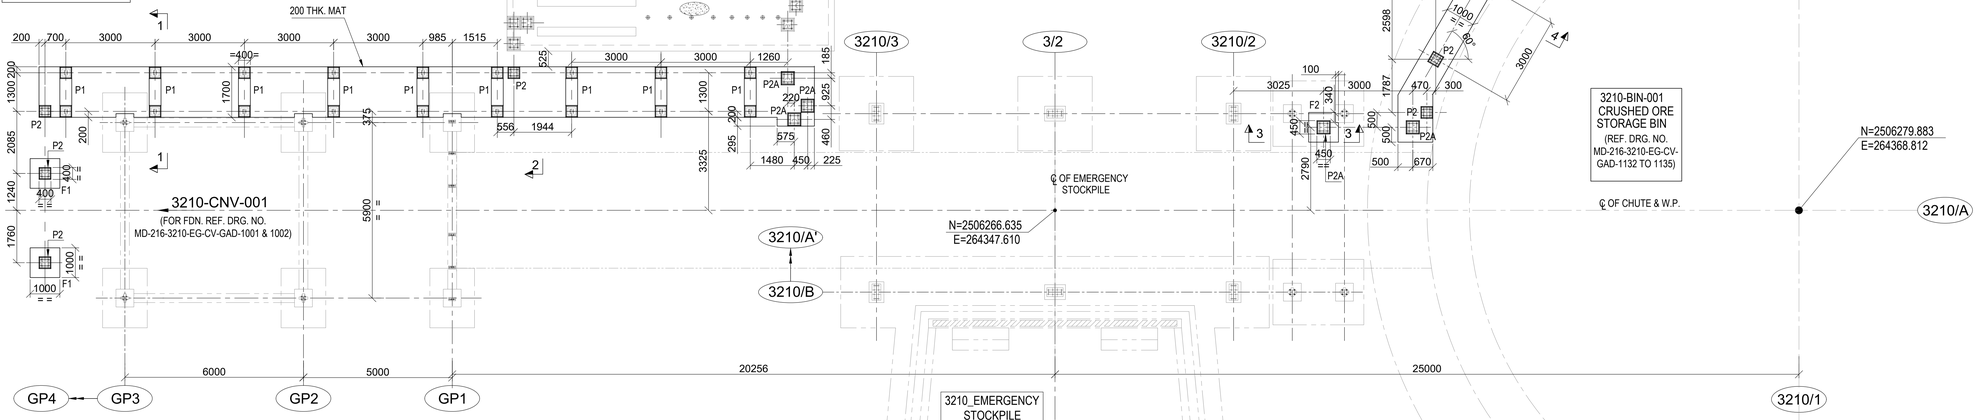

FOUNDATION LAYOUT
(SCALE-1:100)

LEGEND :-

R.L. - REDUCED LEVEL
℄ - CENTRE LINE
CJ - CONSTRUCTION JOINT
FDN. - FOUNDATION.
T.O.C. - TOP OF CONCRETE.
F.G.L. - FINISHED GROUND LEVEL.
F.F.L. - FINISHED FLOOR LEVEL.
B.O.F. - BOTTOM OF FOUNDATION
TYP. - TYPICAL.
B.O.B. - BOTTOM OF BEAM.
B.O.C. - BOTTOM OF CONCRETE
R.C.C - REINFORCED CEMENT CONCRETE
P.C.C - PLAIN CEMENT CONCRETE
IP. - INSERT PLATE
MKD. - MARKED.
THK. - THICK
HEX. = HEXAGONAL
PLT. = PLATE
DRG. = DRAWING
REF. = REFERENCE
NO. = NUMBER

NOTES :-

1. ALL DIMENSIONS ARE IN MILLIMETRES AND LEVELS AND CO-ORDINATES ARE IN METRES. UNLESS OTHERWISE STATED.
2. GRADE OF CONCRETE SHALL BE C35 FOR FOUNDATION.
3. GRADE OF REINFORCEMENT SHALL BE DEFORMED BAR ASTM A615 - GRADE 60 (fy = 420 MPa).
4. NET SAFE BEARING CAPACITY OF SOIL AT BOTTOM OF FOUNDATION CONSIDERED 50KN/ SQ. M.
5. CLEAR COVER TO MAIN REINFORCEMENT SHALL BE AS
   a) FOUNDATION = 75 mm (BOTTOM & SIDE) 50 mm. (TOP)
   b) COLUMN & PEDESTAL = 50mm
   d) SLAB = 40mm
6. FOR MINIMUM LAP LENGTH OF REINFORCEMENT AND OTHER GENERAL NOTES FOR CIVIL WORKS REFER STANDARD DRG : MD-216-1000-EG-CV-DED-1001
7. FOR OTHER STANDARD REINFORCEMENT DETAILS REFER DRG : MD-216-1000-EG-CV-DED-1005

DOCUMENT NUMBER	REFERENCE DOCUMENTS	REV	DATE	REVISION DESCRIPTION	DRN	CHK	ENG	APP	EMP
		D01	10/03/2023	AS-BUILT	MGH	SBY	APR	PRI	
		C01	27/05/2021	ISSUED FOR CONSTRUCTION & REVISED AS MKD. C01	MGH	SBY	APR	PRI	
MD-216-3210-EG-CV-GAD-1001	CONVEYOR 3210-CNV-001-LAYOUT & DETAIL	A01	14/04/2021	ISSUED FOR REVIEW	MGH	SBY	APR	PRI	

RESERVED FOR VENDOR LOGO AND DRAWING NUMBER

LARSEN & TOUBRO DRAWING NUMBER: 019045_450_C_G_24614_001 — REVISION: 2
OUTOTEC DRAWING NUMBER: 900707__GAU01__US01__MTL01__32154 — DOCUMENT ID: 0U100718428 — REVISION: 2

LARSEN & TOUBRO
This drawing is the property of LARSEN & TOUBRO and must not be passed on to any person or body not authorized by us to receive it nor be copied or otherwise made use either in full or in part by such person or body without our prior permission in writing.

Outotec
The content of these documents are the sole property of Outotec Oyj. Any rights not expressly granted herein are reserved. Reproduction, transfer or distribution of part or all of the contents in any form without prior written permission of Outotec is prohibited.

MA'ADEN معادن
Saudi Arabian Mining Company شركة التعدين العربية السعودية
This document and the information contained herein is Ma'aden proprietary know-how. This document or any part thereof should not be reproduced, stored in a retrieval system or transmitted by any means, electronic or otherwise, or divulged without prior written permission of Ma'aden.

DRAWN	MGH	08/04/2021	MANSOURAH - MASSARAH GOLD PROJECT
CHECKED	SBY	09/04/2021	GENERAL ARRANGEMENT DRAWING
ENGINEER	APR	08/04/2021	3210 PUMP STATION AREA PIPE SUPPORT
APPROVED	PRI	14/04/2021	FOUNDATION LAYOUT & DETAILS
EMPLOYER			
SCALE 1:25,1:20,1:10		A1	DRAWING NUMBER: MD-216-3210-EG-CV-GAD-1145 — REV: D01