


DRAWING NUMBER: MD-216-3210-EG-CV-GAD-2001
REV: D01

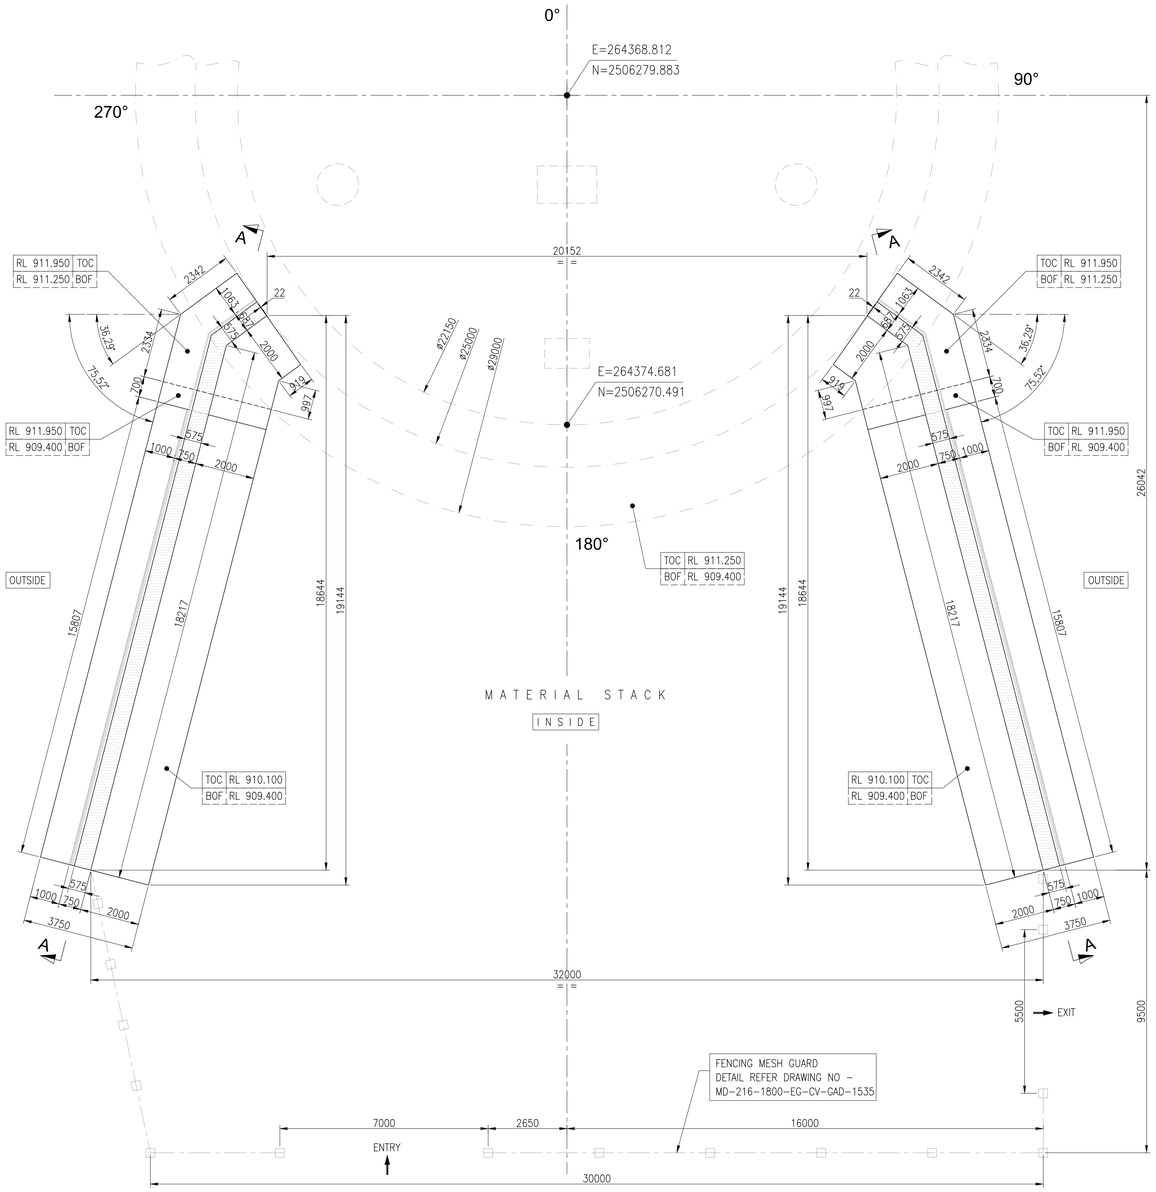


PLAN AT RL 909.400 (BOF)
SCALE-(1:100)

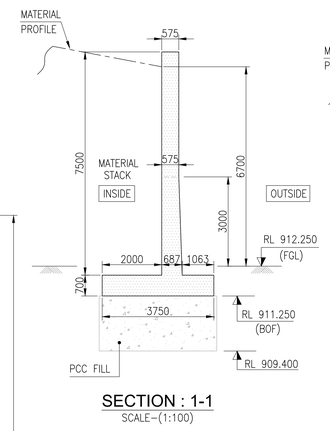


SECTION : 1-1
SCALE-(1:100)

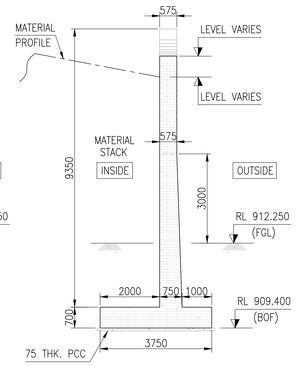

SECTION : 2-2
SCALE-(1:100)

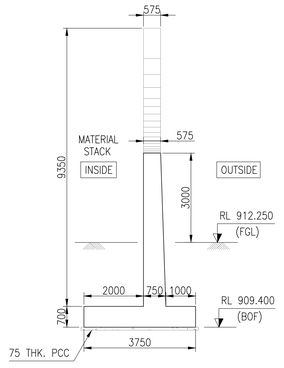

VIEW : 3-3
SCALE-(1:100)

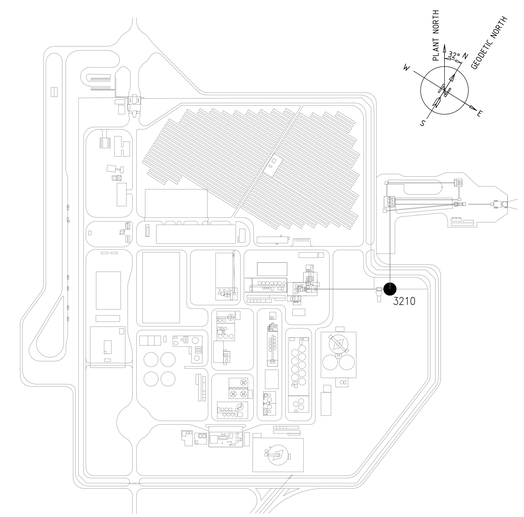


KEY PLAN
SCALE-(1:1000)

LEGEND :-

BOF = BOTTOM OF FOOTING
FGL = FINISHED GROUND LEVEL
FFL = FINISHED FLOOR LEVEL
TOC = TOP OF CONCRETE
PCC = PLAIN CEMENT CONCRETE
TYP = TYPICAL
MKD = MARKED
℄ = CENTRE LINE
THK = THICK
ø = DIAMETER
R = RADIUS
RL = REDUCED LEVEL

NOTES :-

1. ALL DIMENSIONS ARE IN MILLIMETRES AND LEVELS AND CO-ORDINATES ARE IN METRES. UNLESS OTHERWISE STATED.
2. THIS DRAWING SHALL BE READ IN CONJUNCTION WITH DRAWING NO. MD-216-3210-EG-CV-DED-2001.
3. FOR ALL OTHER NOTES REFER DRAWING NO. MD-216-1000-EG-CV-DED-1001, 1003 & 1004.

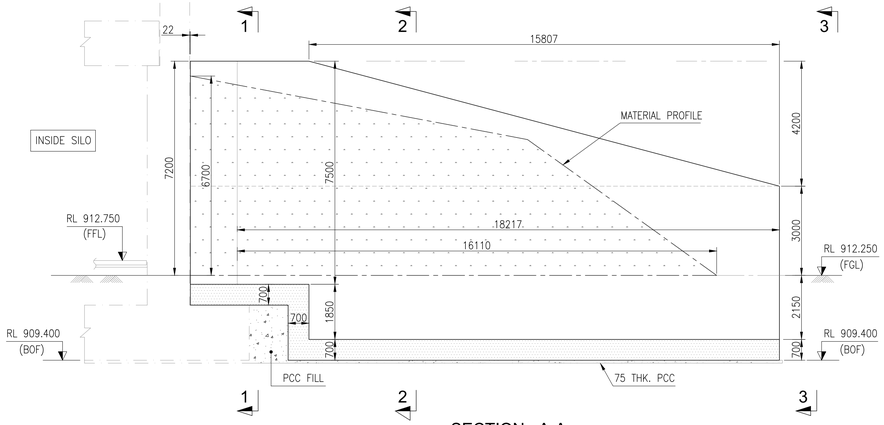

SECTION : A-A
SCALE-(1:100)

DOCUMENT NUMBER	REFERENCE DOCUMENTS	REV	DATE	REVISION DESCRIPTION	DRN	CHK	ENG	APP	EMP
MD-216-3210-EG-ME-ELV-1010	CRUSHED ORE BIN-SECTION								
MD-216-3210-EG-ME-ELV-1009	CRUSHED ORE BIN-ELEVATION	D01	10/03/2023	AS-BUILT	ABH	UR	SVK	AG	
MD-216-3210-EG-ME-LPX-1006	CRUSHED ORE BIN-PLAN	C01	31/10/2020	ISSUED FOR CONSTRUCTION	ABH	UR	SVK	AG	
MD-216-3210-EG-ME-LPX-1005	CRUSHED ORE BIN-PLAN	A02	08/10/2020	REVISED AS PER EMPLOYER COMMENTS	ABH	UR	SVK	AG	
MD-216-3210-EG-ME-LPX-1004	CRUSHED ORE BIN-PLAN			ON 25/09/2020 AS MARKED A02					
MD-216-3210-EG-ME-LPX-1003	CRUSHED ORE BIN-PLAN	A01	20/08/2020	ISSUED FOR REFERENCE	ABH	UR	SVK	AG	

RESERVED FOR VENDOR LOGO AND DRAWING NUMBER

LARSEN & TOUBRO
This drawing is the property of LARSEN & TOUBRO and must not be passed on to any person or body not authorized by us to receive it nor be copied or otherwise made use either in full or in part by such person or body without our prior permission in writing.

Outotec
The content of these documents are the sole property of Outotec Oyj. Any rights not expressly granted herein are reserved. Reproduction, transfer or distribution of part or all of the contents in any form without prior written permission of Outotec is prohibited.

MA'ADEN معادن
Saudi Arabian Mining Company شركة المعادن العربية السعودية
This document and the information contained herein is Ma'aden proprietary know-how. This document or any part thereof should not be reproduced, stored in a retrieval system or transmitted by any means, electronic or otherwise, or divulged without prior written permission of Ma'aden.

LARSEN & TOUBRO DRAWING NUMBER: 019045_450_C_G_24377_001 — REVISION: 3
OUTOTEC DRAWING NUMBER: 900707__GAU01__US01__MTL01__32142 — DOCUMENT ID: OU100692098 — REVISION: 3

DRAWN	ABH	18/08/2020
CHECKED	UR	19/08/2020
ENGINEER	SVK	18/08/2020
APPROVED	AG	20/08/2020
EMPLOYER		
SCALE	1:100	A1

MANSOURAH - MASSARAH GOLD PROJECT
GENERAL ARRANGEMENT
GRINDING & CLASSIFICATION
CRUSHED ORE STORAGE BIN - RETAINING WALL

DRAWING NUMBER: MD-216-3210-EG-CV-GAD-2001 — REV: D01