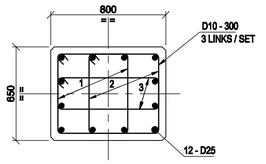
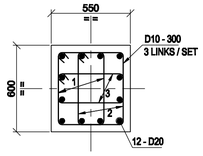
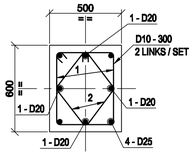
DRAWING NUMBER MD-216-3310-EG-CV-DED-1185 REV D01



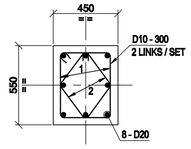

RC. DETAIL OF C1
SCALE 1:20



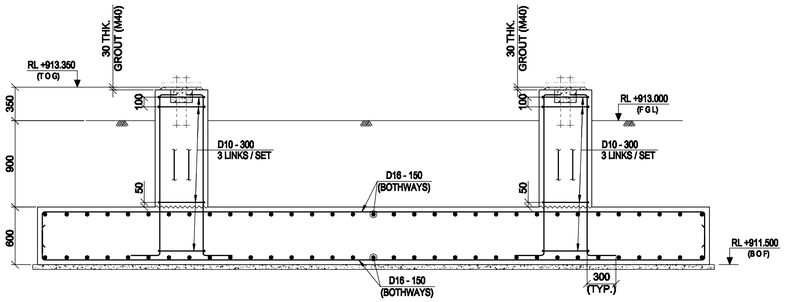

RC. DETAIL OF C3 & C4
SCALE 1:20



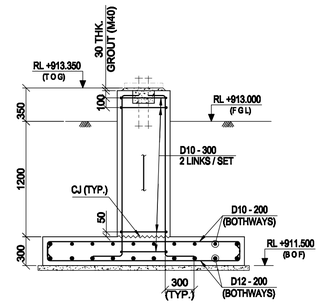

RC. DETAIL OF C5
SCALE 1:20



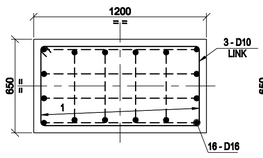

RC. DETAIL OF C6,C6A
SCALE 1:20



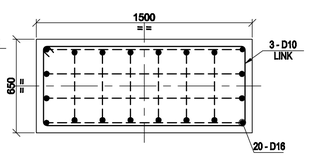

SECTION : B-B
SCALE 1:30



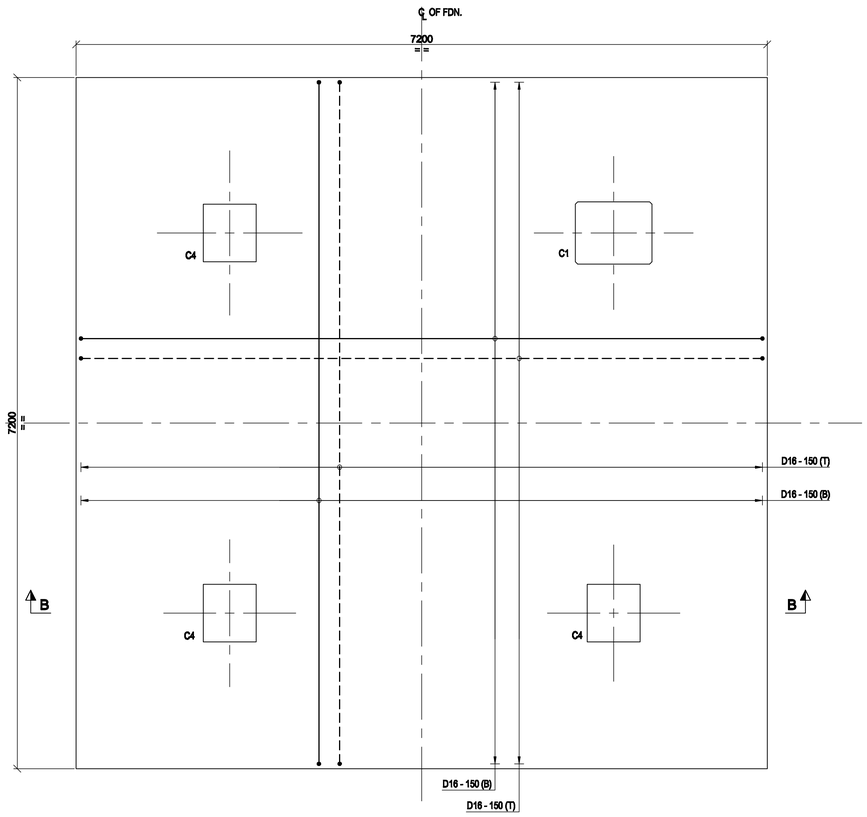

SECTION : C-C
SCALE 1:30



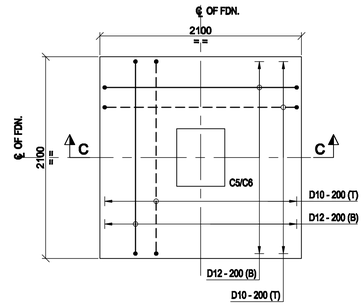

RC. DETAIL OF PEDESTAL MARKED P1
SCALE 1:20



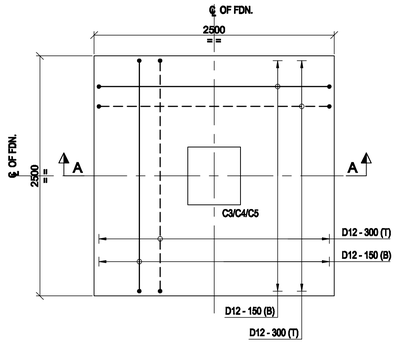

RC. DETAIL OF PEDESTAL MARKED P2
SCALE 1:20



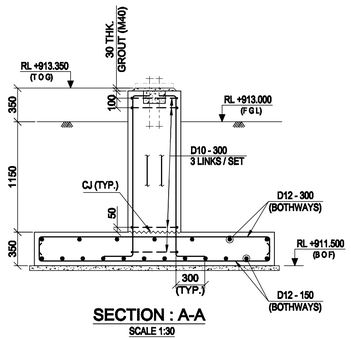

RC. DETAIL OF FOUNDATION MARKED F4
SCALE 1:30




RC. DETAIL OF FOUNDATION MARKED F5
SCALE 1:30




RC. DETAIL OF FOUNDATION MARKED F3
SCALE 1:30




SECTION : A-A
SCALE 1:30

## LEGEND :-

R L - REDUCED LEVEL
T O G - TOP OF GROUT
CJ - CONSTRUCTION JOINT
F G L - FINISHED GROUND LEVEL
P C C - PLAIN CEMENT CONCRETE
FDN. - FOUNDATION
B O F - BOTTOM OF FOUNDATION
———— - BOTTOM REINFORCEMENT SHOWN THUS
_ _ _ _ - TOP REINFORCEMENT SHOWN THUS
℄ OF FDN. - CENTRE LINE OF FOUNDATION

## NOTES:-

1. GRADE OF CONCRETE SHALL BE 35 MPa FOR RCC, 15 MPa FOR BLINDING CONCRETE.
2. GRADE OF REINFORCEMENT SHALL BE DEFORMED BAR 420 MPa (GRADE 60) - ASTM A615/A615M.
3. CLEAR COVER TO MAIN REINFORCEMENT SHALL BE COLUMN - 50MM., FOUNDATION - 50 MM.
4. FOR ALL OTHER NOTES, REFER DRAWING NO. MD-216-3310-EG-CV-GAD-1173, MD-216-3310-EG-CV-GAD-1174, MD-216-3310-EG-CV-GAD-1175, MD-216-3310-EG-CV-GAD-1176.

MD-216-1000-EG-CV-GAD-1005.

| DOCUMENT NUMBER | REFERENCE DOCUMENTS | REV | DATE | REVISION DESCRIPTION | DRN | CHK | ENG | APP | EMP |
|---|---|---|---|---|---|---|---|---|---|
| | | D01 | 29/06/2023 | AS -BUILT | AMT | BDA | SML | AG | |
| | | C01 | 28/04/2020 | ISSUED FOR CONSTRUCTION & REVISED AS PER EMPLOYER'S COMMENTS ON 24/04/2020 & REVISED AS MKD. C01 | AMT | BDA | SML | AG | |
| MD-216-3310-EG-ST-GAD-2163 | ROUGHER AND SCAVENGER FLOTATION | A01 | 02/03/2020 | ISSUED FOR REFERENCE | AMT | BDA | SML | AG | |

RESERVED FOR VENDOR LOGO AND DRAWING NUMBER

LARSEN & TOUBRO

This drawing is the property of LARSEN & TOUBRO and must not be passed on to any person or body not authorized by us to receive it nor be copied or otherwise made use either in full or in part by such person or body without our prior permission in writing.

Outotec

The content of these documents are the sole property of Outotec Oyj. Any rights not expressly granted herein are reserved. Reproduction, transfer or distribution of part or all of the contents in any form without prior written permission of Outotec is prohibited.

MA'ADEN معادن
Saudi Arabian Mining Company شركة المعادن العربية السعودية

This document and the information contained herein is Ma'aden proprietary know-how. This document or any part thereof should not be reproduced, stored in a retrieval system or transmitted by any means, electronic or otherwise, or divulged without prior written permission of Ma'aden.

| | | | |
|---|---|---|---|
| LARSEN & TOUBRO DRAWING NUMBER | 019045_450_C_D_24084_002 | | REVISION 2 |
| OUTOTEC DRAWING NUMBER | 900707 _GAU01 _ZF01 _CTB13 _33102 | DOCUMENT ID OU100665542 | REVISION 2 |
| DRAWN | AMT | 28/02/2020 | MANSOURAH - MASSARAH GOLD PROJECT |
| CHECKED | BDA | 29/02/2020 | DETAIL DRAWING |
| ENGINEER | SML | 28/02/2020 | ROUGHER AND SCAVENGER FLOTATION |
| APPROVED | AG | 02/03/2020 | RC DETAILS OF FOUNDATION |
| EMPLOYER | | | |
| SCALE | 1:30, 1:20 | A1 | DRAWING NUMBER MD-216-3310-EG-CV-DED-1185 REV D01 |

# Mansourah Massarah Gold Project
# Comment Resolution Log Sheet / Compliance Report

**PROJECT:** MANSOURAH MASSARAH GOLD PROJECT **PROJECT NO.: 216**

**STAGE:** 4 - PROJECT EXECUTION. **REVIEW LOG DOC. NO. & REV.:**

**ACONEX REF. NO. & DATE:** BECHTEL-WTRAN-002196, 24 April 2020

STATUS CODE: A - APPROVED, C - APPROVED WITH COMMENTS, R - REVISE & RESUBMIT & O - OTHERS (INFORMATION, REFERENCE, REVIEWED)

| DOCUMENT NUMBER | Area / Title | Comment No. | PMC/PMT COMMENT<br>DATE: 24 April 2020 | Comment by | EPC Response<br>DATE: 28 April 2020 | Status | Remarks |
|---|---|---|---|---|---|---|---|
| | | | **General Comments (cc)** | | | | |
| MD-216-3310-EG-CV-DED-1185-A01 | 3310 | 1 | Please make reference to drw. ..CV-DED-1005 | Mr. Doron Golan - Bechtel | Incorporated | Closed | |