


DRAWING NUMBER MD-216-3310-EG-CV-DED-1186 REV D01

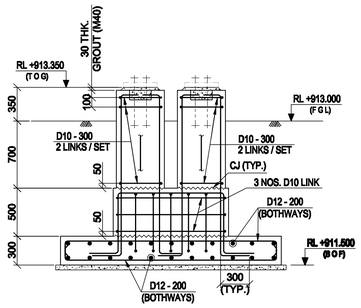


SECTION : D-D
SCALE 1:30

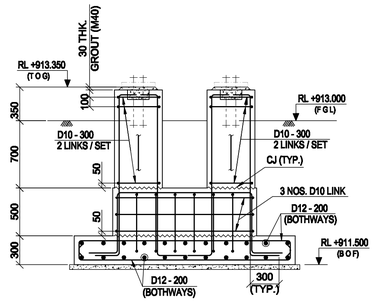


SECTION : E-E
SCALE 1:30

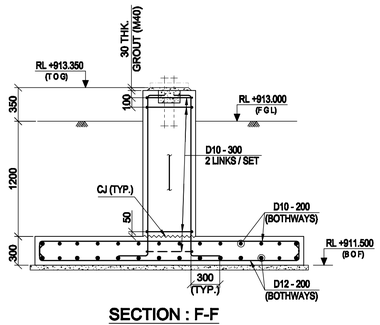


SECTION : F-F
SCALE 1:30

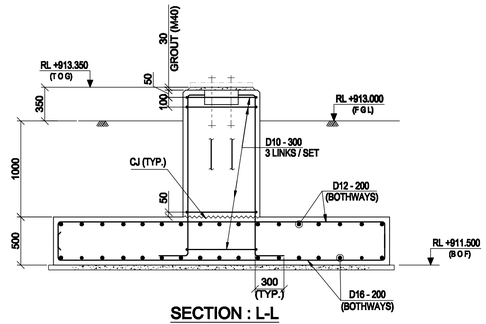


SECTION : L-L
SCALE 1:30

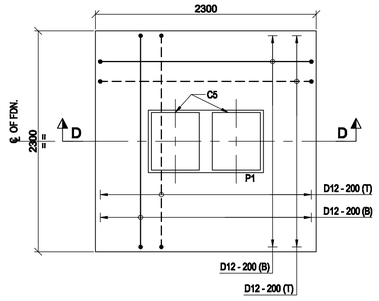


RC. DETAIL OF FOUNDATION MARKED F6A
SCALE 1:30

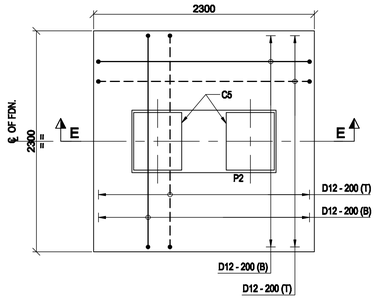

RC. DETAIL OF FOUNDATION MARKED F6
SCALE 1:30

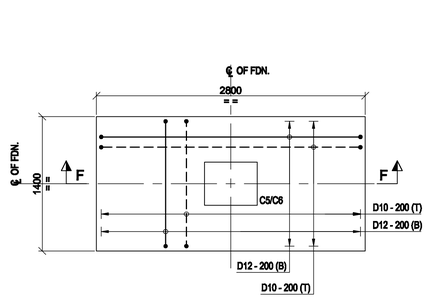

RC. DETAIL OF FOUNDATION MARKED F7 & F7A
SCALE 1:30

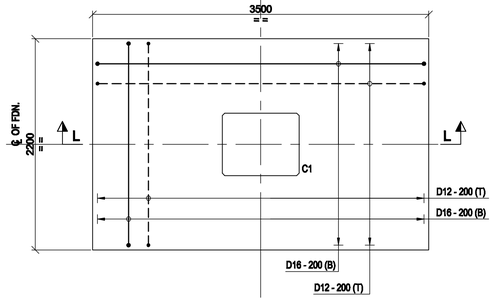

RC. DETAIL OF FOUNDATION MARKED F11
SCALE 1:30

LEGEND :-
R L - REDUCED LEVEL
T O G - TOP OF GROUT
CJ - CONSTRUCTION JOINT
F G L - FINISHED GROUND LEVEL
P C C - PLAIN CEMENT CONCRETE
FDN. - FOUNDATION
B O F - BOTTOM OF FOUNDATION
———— - BOTTOM REINFORCEMENT SHOWN THUS
_ _ _ _ - TOP REINFORCEMENT SHOWN THUS
℄ OF FDN. - CENTRE LINE OF FOUNDATION
THK. - THICKNESS

NOTES:-
1. GRADE OF CONCRETE SHALL BE 35 MPa FOR RCC, 15 MPa FOR BLINDING CONCRETE.
2. GRADE OF REINFORCEMENT SHALL BE DEFORMED BAR 420 MPa (GRADE 60) - ASTM A615/A615M.
3. CLEAR COVER TO MAIN REINFORCEMENT SHALL BE COLUMN - 50MM., FOUNDATION - 50 MM.
4. FOR ALL OTHER NOTES, REFER DRAWING NO. MD-216-3310-EG-CV-GAD-1173, MD-216-3310-EG-CV-GAD-1174. MD-216-3310-EG-CV-GAD-1175. MD-216-3310-EG-CV-GAD-1176. MD-216-1000-EG-CV-GAD-1005.

REFERENCE DOCUMENTS	REV	DATE	REVISION DESCRIPTION	DRN	CHK	ENG	APP	EMP
	D01	29/06/2023	AS - BUILT	AMT	BDA	SML	AG	
	C01	28/04/2020	ISSUED FOR CONSTRUCTION & REVISED AS PER EMPLOYER'S COMMENTS ON 24/04/2020 & REVISED AS MKD. C01	AMT	BDA	SML	AG	
ROUGHER AND SCAVENGER FLOTATION	A01	02/03/2020	ISSUED FOR REFERENCE	AMT	BDA	SML	AG	
DOCUMENT NUMBER: MD-216-3310-EG-ST-GAD-2163								

RESERVED FOR VENDOR LOGO AND DRAWING NUMBER

LARSEN & TOUBRO

This drawing is the property of LARSEN & TOUBRO and must not be passed on to any person or body not authorised by us to receive it nor be copied or otherwise made use either in full or in part by such person or body without our prior permission in writing.

Outotec

The content of these documents are the sole property of Outotec Oyj. Any rights not expressly granted herein are reserved. Reproduction, transfer or distribution of part or all of the contents in any form without prior written permission of Outotec is prohibited.

MA'ADEN معادن
Saudi Arabian Mining Company شركة التعدين العربية السعودية

This document and the information contained herein is Ma'aden proprietary know-how. This document or any part thereof should not be reproduced, stored in a retrieval system or transmitted by any means, electronic or otherwise, or divulged without prior written permission of Ma'aden.

LARSEN & TOUBRO DRAWING NUMBER: 019045_450_C_D_24084_003 — REVISION: 2
OUTOTEC DRAWING NUMBER: 900707 _GAU01 _ZF01 _CTB13 _33103 — DOCUMENT ID: OU100665543 — REVISION: 2

DRAWN	AMT	28/02/2020
CHECKED	BDA	29/02/2020
ENGINEER	SML	28/02/2020
APPROVED	AG	02/03/2020
EMPLOYER		
SCALE	1:30	A1

MANSOURAH - MASSARAH GOLD PROJECT
DETAIL DRAWING
ROUGHER AND SCAVENGER FLOTATION
RC DETAILS OF FOUNDATION

DRAWING NUMBER: MD-216-3310-EG-CV-DED-1186 — REV: D01

Mansourah Massarah Gold Project
Comment Resolution Log Sheet / Compliance Report

PROJECT: MANSOURAH MASSARAH GOLD PROJECT **PROJECT NO.: 216**

STAGE: 4 - PROJECT EXECUTION. **REVIEW LOG DOC. NO. & REV.:**

ACONEX REF. NO. & DATE: BECHTEL-WTRAN-002196, 24 April 2020

STATUS CODE: A - APPROVED, C - APPROVED WITH COMMENTS, R - REVISE & RESUBMIT & O - OTHERS (INFORMATION, REFERENCE, REVIEWED)

DOCUMENT NUMBER	Area / Title	Comment No.	PMC/PMT COMMENT DATE: 24 April 2020	Comment by	EPC Response DATE: 28 April 2020	Status	Remarks
			General Comments (cc)				
MD-216-3310-EG-CV-DED-1186-A01	3310	1	Please make reference to drw. ..CV-DED-1005	Mr. Doron Golan - Bechtel	Incorporated	Closed	