


DRAWING NUMBER	REV
MD-216-3310-EG-CV-DED-1187	D01

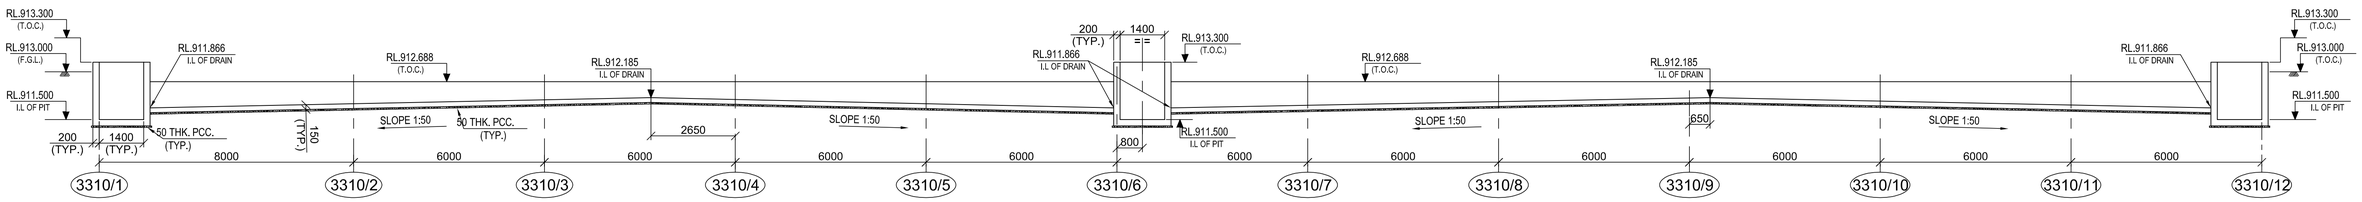


SECTION : B-B
SCALE 1:100

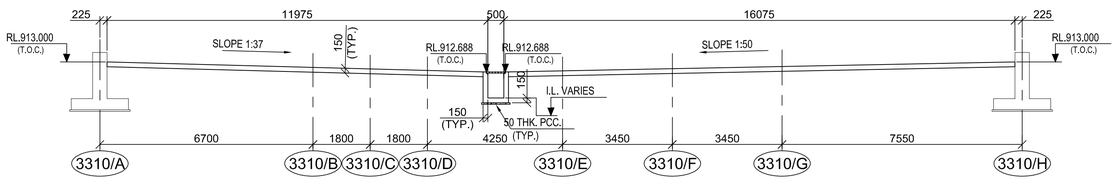


SECTION : A-A
SCALE 1:100

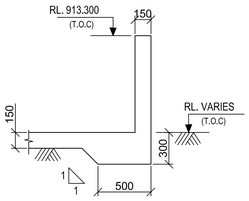


SECTION D-D
SECTION D'-D' (OPP. HAND)
SCALE 1:30

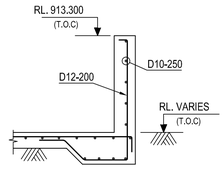


SECTION D-D
SECTION D'-D' (OPP. HAND)
(R.C DETAIL)
SCALE 1:30

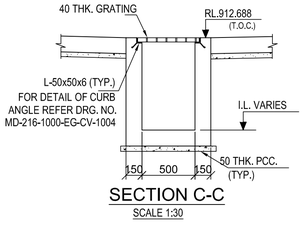


SECTION C-C
SCALE 1:30

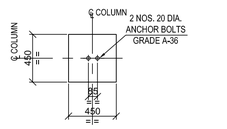


VIEW : L-L
SCALE 1:30

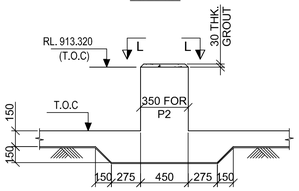


DETAIL OF P1, P2
SCALE 1:30

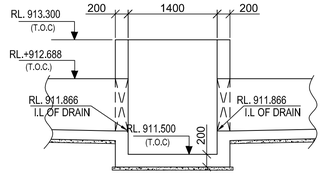


SECTION F-F
SCALE 1:50

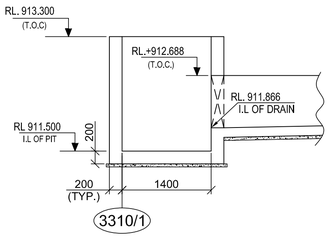


SECTION G-G
SCALE 1:50

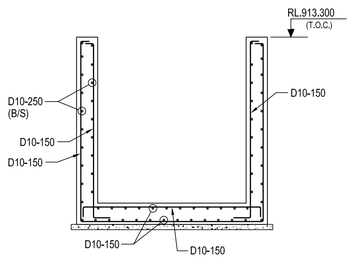


SECTION E-E
(R.C DETAIL)
SCALE 1:30

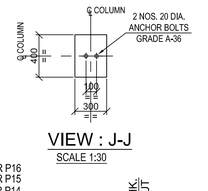


VIEW : J-J
SCALE 1:30

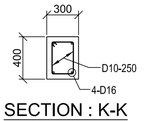


SECTION : K-K
SCALE 1:30

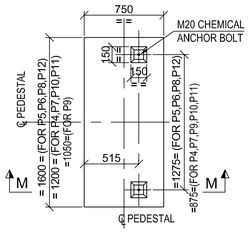

DETAIL OF PEDESTAL MKD. P4 TO P12
(PEDESTAL ORIENTATION TREATED AS PER LAYOUT PLAN)
(SCALE - 1:30)

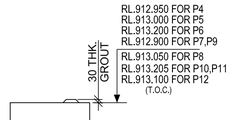

SECTION : M-M
(SCALE - 1:30)

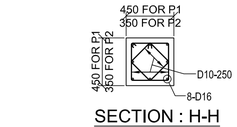

SECTION : H-H
SCALE 1:30

DETAIL-D1
SCALE 1:50


DETAIL-D2
SCALE 1:50

SECTION F-F
(R.C DETAIL)
SCALE 1:30


DETAIL OF P3,P13,P14,P15,P16
SCALE 1:30

DETAIL OF P3,P13,P14,P15,P16
(R.C DETAIL)
SCALE 1:30


SECTION : M-M
(R.C DETAIL)
(SCALE - 1:20)

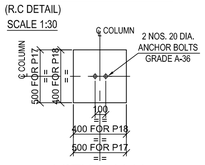


VIEW : N-N
SCALE 1:30

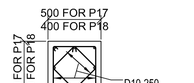


SECTION : P-P
SCALE 1:30

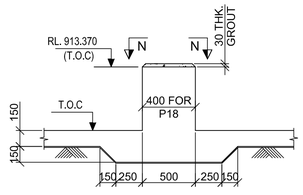

DETAIL OF P17, P18
SCALE 1:30

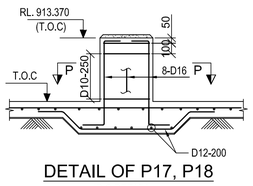

DETAIL OF P17, P18
(R.C DETAIL)
SCALE 1:30

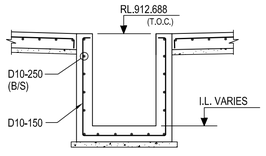

SECTION C-C
(R.C DETAIL)
SCALE 1:30

LEGEND :-
R.L. - REDUCED LEVEL
I.L - INVERT LEVEL
F.G.L - FINISHED GROUND LEVEL
THK. - THICKNESS
T.O.C - TOP OF CONCRETE
B/S - BOTH SIDE
P.C.C - PLAIN CEMENT CONCRETE
TYP. - TYPICAL
℄ - CENTRE LINE
T.O.G - TOP OF GRATING
R.C. - REINFORCED CONCRETE
DIA. - DIAMETER

NOTES:-
1. ALL DIMENSIONS ARE IN MILLIMETRES AND LEVELS AND CO-ORDINATES ARE IN METRES UNLESS OTHERWISE STATED.
2. FOR DETAILS OF GRADE SLAB REFER DRG. NO. MD-216-1000-EG-CV-DED-1002.
3. THIS DRAWING SHOULD BE READ IN CONJUNCTION WITH DRAWING NO. MD-216-3310-EG-CV-GAD-1177.

DOCUMENT NUMBER	REFERENCE DOCUMENTS	REV	DATE	REVISION DESCRIPTION	DRN	CHK	ENG	APP	EMP
		D01	16/02/2023	AS-BUILT	ABS	SJM	AVG	AG	
MD-216-3310-EG-CV-GAD-1173	ROUGHER AND SCAVENGER FLOTATION	C02	13/10/2020	ISSUED FOR CONSTRUCTION & REVISED AS MKD.	ABS	SJM	AVG	AG	
MD-216-3310-EG-ME-GAD-1055	FLOTATION ROUGHER/SCAVENGER/CLEANER	C01	29/04/2020	ISSUED FOR CONSTRUCTION & REVISED AS MKD.	ABS	SJM	AVG	AG	
MD-216-3310-EG-ST-GAD-2163	ROUGHER AND SCAVENGER FLOTATION	A01	31/03/2020	ISSUED FOR REFERENCE	ABS	SJM	AVG	AG	

RESERVED FOR VENDOR LOGO AND DRAWING NUMBER

LARSEN & TOUBRO

This drawing is the property of LARSEN & TOUBRO and must not be passed on to any person or body not authorized by us to receive it nor be copied or otherwise made use either in full or in part by such person or body without our prior permission in writing.

Outotec

The content of these documents are the sole property of Outotec Oyj. Any rights not expressly granted herein are reserved. Reproduction, transfer or distribution of part or all of the contents in any form without prior written permission of Outotec is prohibited.

MA'ADEN معادن
Saudi Arabian Mining Company شركة معادن العربية السعودية

This document and the information contained herein is Ma'aden proprietary know-how. This document or any part thereof should not be reproduced, stored in a retrieval system or transmitted by any means, electronic or otherwise, or divulged without prior written permission of Ma'aden.

LARSEN & TOUBRO DRAWING NUMBER	019045_450_C_D_24084_004		REVISION 3
OUTOTEC DRAWING NUMBER	900707__GAU01__ZF01__CTB17__33101	DOCUMENT ID OU100680080	REVISION 3
DRAWN	ABS	27/03/2020	MANSOURAH - MASSARAH GOLD PROJECT
CHECKED	SJM	30/03/2020	DETAIL DRAWING
ENGINEER	AVG	27/03/2020	ROUGHER AND SCAVENGER FLOTATION
APPROVED	AG	31/03/2020	R.C. DETAILS OF GRADE SLAB
EMPLOYER			
SCALE 1:125, 1:50, 1:20	A1		DRAWING NUMBER MD-216-3310-EG-CV-DED-1187 REV D01