


DRAWING NUMBER: MD-216-3310-EG-CV-DED-1194 | REV: D01

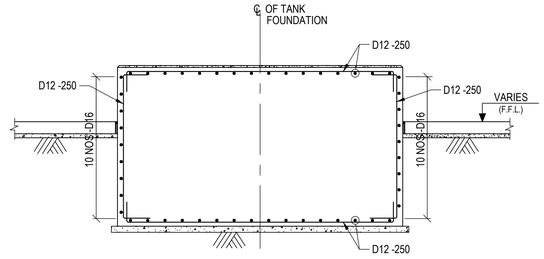


SECTION : A-A
SCALE 1:40

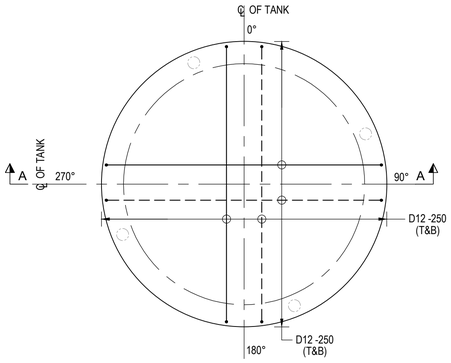


RCC. DETAIL 3310-REA-002
SCALE 1:40

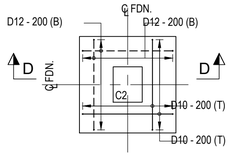


RCC. DET. OF FDN.
MKD. F2
SCALE 1:50

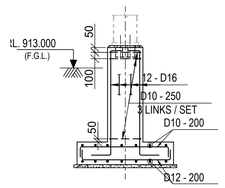


SECTION : D-D
SCALE 1:50

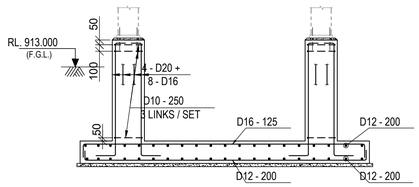


SECTION : E-E
SCALE 1:50

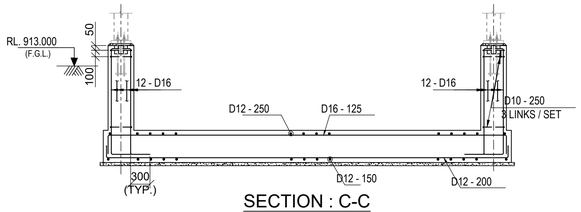


SECTION : C-C
SCALE 1:50

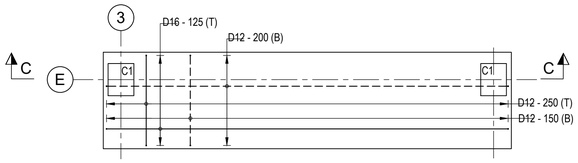


RCC. DET. OF FDN.
MKD. F1
SCALE 1:50

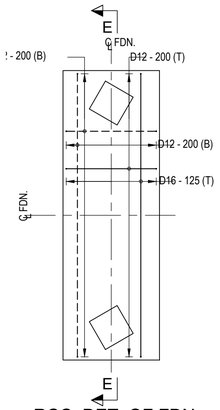


RCC. DET. OF FDN.
MKD. F3 & F4
SCALE 1:50

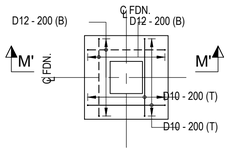


RCC. DET. OF FDN.
MKD. F5 & F6
SCALE 1:50

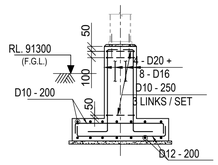


SECTION : M'-M'
SCALE 1:50

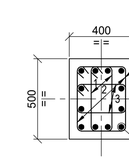


RCC. DET. OF C1 & C7
SCALE 1:20

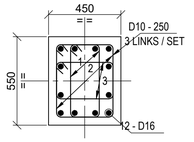


RCC. DET. OF C2
SCALE 1:20

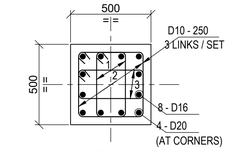


RCC. DET. OF C3, C4,
C5 & C6
SCALE 1:20

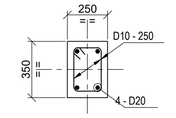


RCC. DET. OF C8
SCALE 1:20

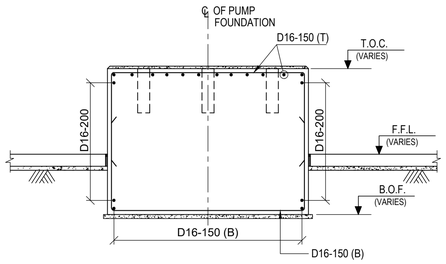


SECTION : B-B
SCALE 1:40

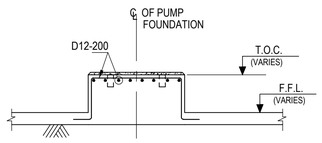


TYP. RC. DET. OF FDN. FOR PUMP MKD.
3310-PMP-501,502 & 503
SCALE 1:40

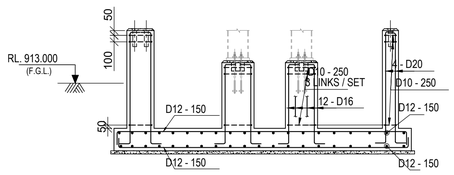


SECTION : G-G
SCALE 1:50

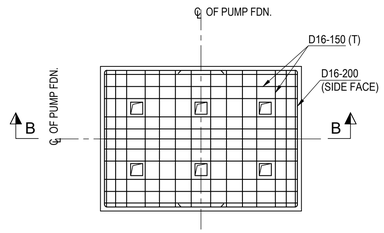


TYP. RC. DET. OF FDN. FOR PUMP MKD.
3310-PMP-009,010,011,012,015,016,017
(TOP VIEW)
SCALE 1:40

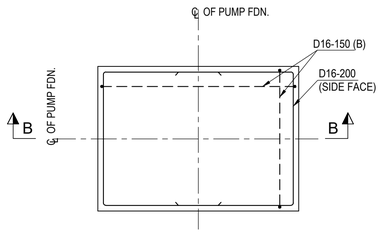

TYP. RC. DET. OF FDN. FOR PUMP MKD.
3310-PMP-009,010,011,012,015,016,017
(BOTTOM VIEW)
SCALE 1:40

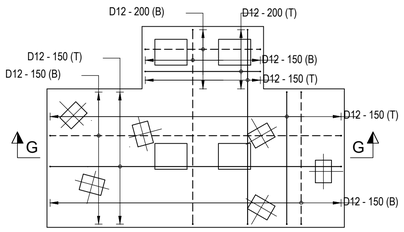

RC. DET. OF FDN. MKD. F7
SCALE 1:50

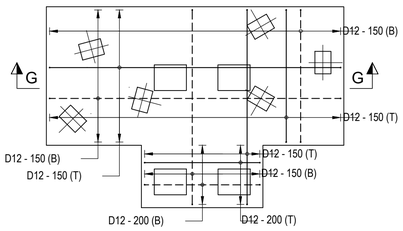

RC. DET. OF FDN. MKD. F8 & F9
SCALE 1:50

LEGEND :-

R.L. - REDUCED LEVEL
℄ - CENTRE LINE
T.O.C. - TOP OF CONCRETE
TYP. - TYPICAL
F.G.L. - FINISHED GROUND LEVEL
F.F.L. - FINISHED FLOOR LEVEL
B.O.F. - BOTTOM OF FOUNDATION
MKD. - MARKED
P.C.C - PLAIN CEMENT CONCRETE
N.T.S. - NOT TO SCALE
EXP. JT. - EXPANSION JOINT
DET. - DETAIL
BOTTOM REINFORCEMENT (B) - - - - - - -
TOP REINFORCEMENT (T) - ———
SQ. - SQUARE
R.C. - REINFORCED CONCRETE
FDN. - FOUNDATION
THK. - THICK

NOTES:-

1. ALL DIMENSIONS ARE IN MILLIMETRES AND LEVELS AND CO-ORDINATES ARE IN METRES UNLESS OTHERWISE STATED.
2. NET SAFE BEARING CAPACITY OF SOIL AT BOTTOM OF FOUNDATION CONSIDER 450KN/ SQ. M
3. GRADE OF CONCRETE SHALL BE C35 (35MPa) FOR FOUNDATION & C15 (15MPa) FOR BLINDING CONCRETE.
4. GRADE OF REINFORCEMENT SHALL BE DEFORMED BAR 420 MPa (GRADE 60) - ASTM A615/A615M.
5. IF ANY PART OF FOUNDATION COMES ON BACKFILL ZONE OF ADJACENT FOUNDATION OR ANY LOOSE SOIL ARE ENCOUNTERED BELOW FOUNDATION LEVEL THE SAME SHALL BE REMOVED AND FILLED WITH PCC (C15).
6. CLEAR COVER TO REINFORCEMENT SHALL BE a. FOUNDATIONS = 50 MM., b. COLUMNS = 50 MM.
7. FOR STANDARD REINFORCEMENT DETAIL & GENERAL NOTES FOR CIVIL WORKS REFER DRAWING NO. MD-216-1000-EG-CV-DED-1005 & 1001.
8. THIS DRAWING SHOULD BE READ IN CONJUNCTION WITH DRAWING NO. MD-216-3310-EG-CV-GAD-1185, MD-216-3310-EG-CV-GAD-1186.

DOCUMENT NUMBER	REFERENCE DOCUMENTS	REV	DATE	REVISION DESCRIPTION	DRN	CHK	ENG	APP	EMP
MD-216-3310-EG-CV-GAD-1186	DETAIL OF MISCELLANEOUS FOUNDATION								
MD-216-3310-EG-CV-GAD-1185	LAYOUT & DETAIL OF MISCELLANEOUS FOUNDATION								
MD-216-1000-EG-ST-CRT-1001	CIVIL, STRUCTURAL & ARCHITECTURAL-DESIGN CRITERIA	D01	22/02/2023	AS-BUILT	ABS	SJM	AVG	AG	
MD-216-3310-EG-ME-GAD-1055	PLAN AT EL. +913.000	C01	17/10/2020	ISSUED FOR CONSTRUCTION	ABS	SJM	AVG	AG	
MD-216-3310-EG-CV-GAD-1177	LAYOUT & DETAIL OF GRADE SLAB	A01	30/09/2020	ISSUED FOR REFERENCE	ABS	SJM	AVG	AG	

RESERVED FOR VENDOR LOGO AND DRAWING NUMBER

LARSEN & TOUBRO DRAWING NUMBER: 019045_450_C_D_24391_001 | REVISION: 2
OUTOTEC DRAWING NUMBER: 900707__GAU01__ZF01__CTB17__33105 | DOCUMENT ID: OU100696608 | REVISION: 2

LARSEN & TOUBRO
This drawing is the property of LARSEN & TOUBRO and must not be passed on to any person or body not authorized by us to receive it nor be copied or otherwise made use either in full or in part by such person or body without our prior permission in writing.

Outotec
The content of these documents are the sole property of Outotec Oyj. Any rights not expressly granted herein are reserved. Reproduction, transfer or distribution of part or all of the contents in any form without prior written permission of Outotec is prohibited.

MA'ADEN معادن
Saudi Arabian Mining Company شركة التعدين العربية السعودية
This document and the information contained herein is Ma'aden proprietary know-how. This document or any part thereof should not be reproduced, stored in a retrieval system or transmitted by any means, electronic or otherwise, or divulged without prior written permission of Ma'aden.

DRAWN	ABS	07/09/2020	MANSOURAH - MASSARAH GOLD PROJECT
CHECKED	SJM	11/09/2020	DETAIL DRAWING
ENGINEER	AVG	08/09/2020	ROUGHER AND SCAVENGER FLOTATION
APPROVED	AG	30/09/2020	RC. DETAILS OF MISCELLANEOUS FOUNDATION
EMPLOYER			
SCALE	1:20, 1:50, 1:150	A1	

DRAWING NUMBER: MD-216-3310-EG-CV-DED-1194 | REV: D01