


DRAWING NUMBER: MD-216-3310-EG-CV-DED-1195 | REV: D01

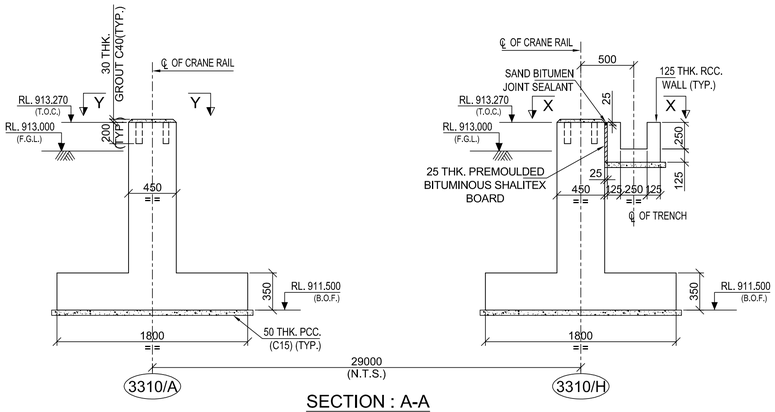


SECTION : A-A
SCALE 1:30

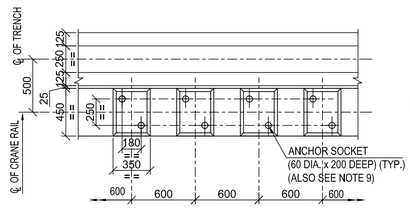


VIEW : X-X
SCALE 1:30

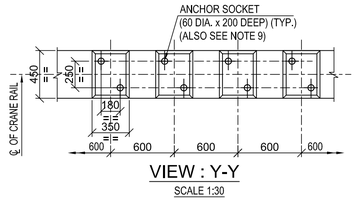


VIEW : Y-Y
SCALE 1:30

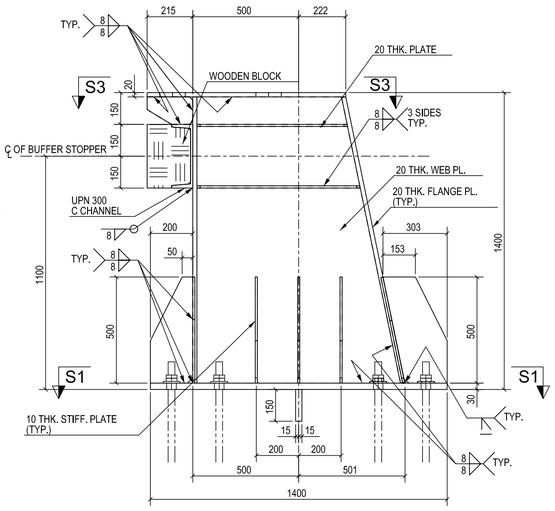


TYP. DETAIL OF BUFFER STOP
SCALE 1:15

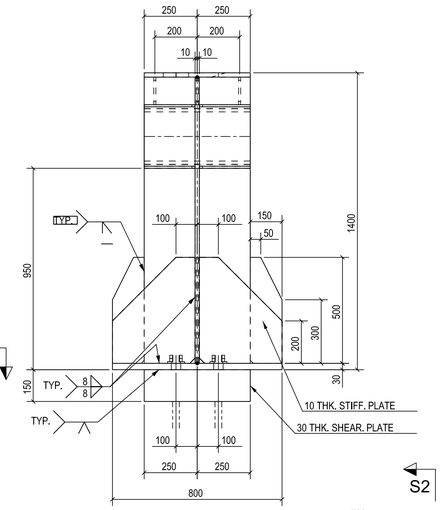


SECTION : S2-S2
SCALE 1:15

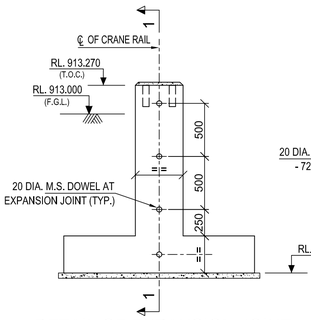


DETAIL OF EXPANSION JOINT
SCALE 1:30

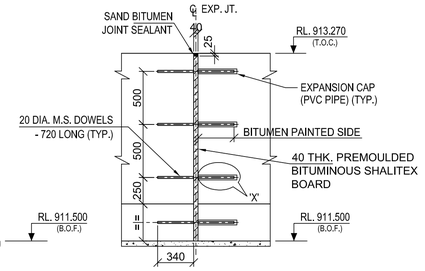


SECTION : 1-1
SCALE 1:30

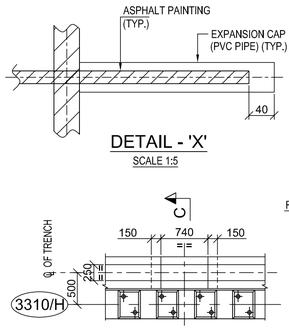


DETAIL - 'X'
SCALE 1:5

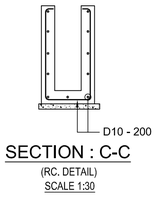


SECTION : C-C
(RC. DETAIL)
SCALE 1:30

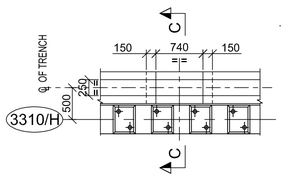


DETAIL - 'C'
SCALE 1:50

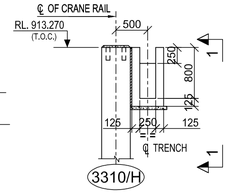


SECTION : C-C
SCALE 1:50

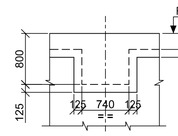


VIEW : 1-1
SCALE 1:50

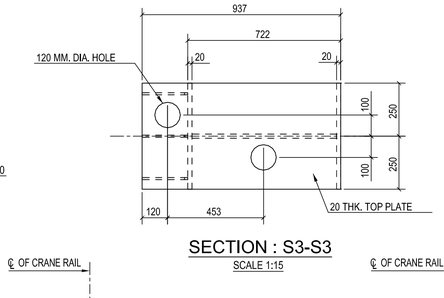


SECTION : S3-S3
SCALE 1:15

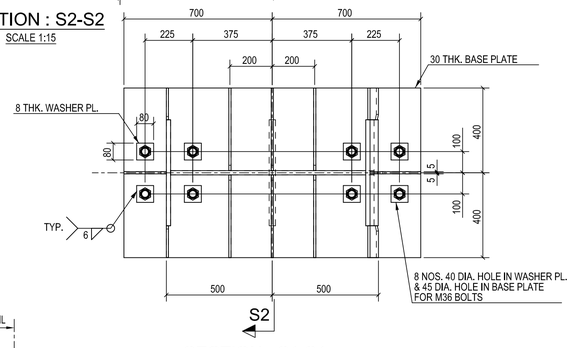


SECTION : S1-S1
SCALE 1:15

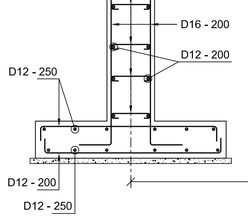


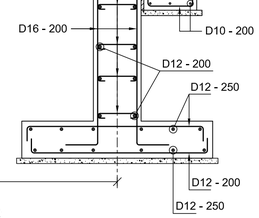


SECTION : A-A
(RC. DETAIL)
SCALE 1:30

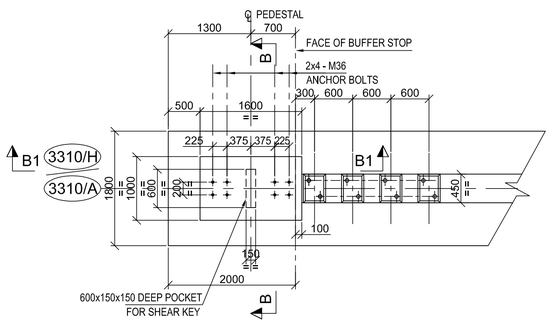


DETAIL - 'A'
DETAIL - 'B' (SIMILAR BUT OPPOSITE HAND)
SCALE 1:50

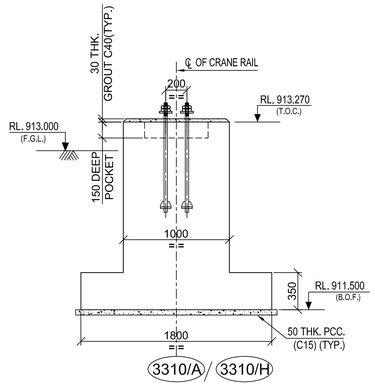


SECTION : B-B
SCALE 1:30

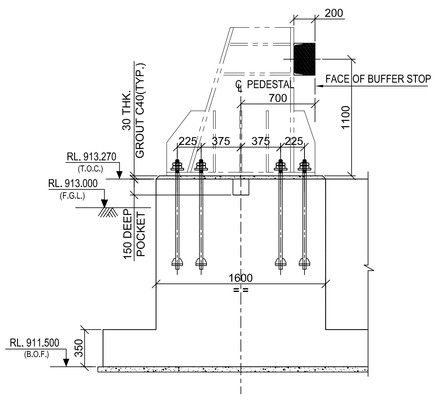

SECTION : B1-B1
SCALE 1:30

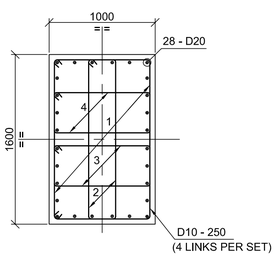

VIEW : Z-Z
SCALE 1:30

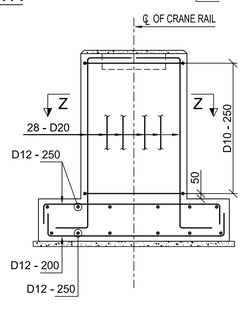

SECTION : B-B
(RC. DETAIL)
SCALE 1:30

LEGEND :-
R.L. - REDUCED LEVEL
℄ - CENTRE LINE
T.O.C. - TOP OF CONCRETE
T.O.G. - TOP OF GROUT
TYP. - TYPICAL
F.G.L. - FINISHED GROUND LEVEL
F.F.L. - FINISHED FLOOR LEVEL
B.O.F. - BOTTOM OF FOUNDATION
MKD. - MARKED
THK. - THICK
R.C.C - REINFORCED CEMENT CONCRETE
P.C.C - PLAIN CEMENT CONCRETE
FDN. - FOUNDATION
DET. - DETAIL
PVC - POLYVINYL CHLORIDE
EXP. JT. - EXPANSION JOINT
N.T.S. - NOT TO SCALE
M.S. - MILD STEEL
DIA. - DIAMETER

NOTES:-
1. ALL DIMENSIONS ARE IN MILLIMETRES AND LEVELS AND CO-ORDINATES ARE IN METRES UNLESS OTHERWISE STATED.
3. GRADE OF CONCRETE SHALL BE C35 (35MPa) FOR FOUNDATION & C15 (15MPa) FOR BLINDING CONCRETE.
4. GRADE OF REINFORCEMENT SHALL BE DEFORMED BAR 420 MPa (GRADE 60) - ASTM A615/A615M.
5. NET SAFE BEARING CAPACITY OF SOIL AT BOTTOM OF FOUNDATION CONSIDERED AS 450KN/ SQ. M
6. CLEAR COVER TO REINFORCEMENT SHALL BE FOUNDATIONS = 50 MM., COLUMNS = 50 MM., WALL = 50 MM.
7. FOR STANDARD REINFORCEMENT DETAIL & GENERAL NOTES FOR CIVIL WORKS REFER DRAWING NO. MD-216-1000-EG-CV-DED-1005 & 1001.
8. THIS DRAWING SHOULD BE READ IN CONJUNCTION WITH DRAWING NO. MD-216-3310-EG-CV-GAD-1187.
9. BOLT FIXING IN ANCHOR SOCKET SHALL BE DONE WITH EPOXY GROUT (GANTREX S3) OR EQUIVALENT.
10. FOR STRUCTURAL GENERAL NOTES REFER DRAWING NO. MD-216-1000-EG-ST-DED-1001.

DOCUMENT NUMBER	REFERENCE DOCUMENTS	REV	DATE	REVISION DESCRIPTION	DRN	CHK	ENG	APP	EMP
		D01	22/02/2023	AS-BUILT	ABS	SJM	AVG	AG	
		C03	17/07/2021	ISSUED FOR CONSTRUCTION & REVISED AS MKD. /C03	PML	SJM	AVG	AG	
MD-216-1000-EG-ST-CRT-1001	CIVIL, STRUCTURAL & ARCHITECTURAL-DESIGN CRITERIA	C02	04/12/2020	ISSUED FOR CONSTRUCTION & REVISED AS MKD. /C02	MNS	SJM	AVG	AG	
MD-216-3310-EG-ME-GAD-1055	PLAN AT EL. +913.000	C01	17/10/2020	ISSUED FOR CONSTRUCTION	ABS	SJM	AVG	AG	
MD-216-3310-EG-CV-GAD-1187	LAYOUT OF CRANE RAIL FOUNDATION	A01	21/09/2020	ISSUED FOR REFERENCE	ABS	SJM	AVG	AG	

RESERVED FOR VENDOR LOGO AND DRAWING NUMBER

LARSEN & TOUBRO DRAWING NUMBER: 019045_450_C_D_24394_001 | REVISION: 4
OUTOTEC DRAWING NUMBER: 900707__GAU01__ZF01__CTB17__33106 | DOCUMENT ID: OU100696609 | REVISION: 4

LARSEN & TOUBRO
This drawing is the property of LARSEN & TOUBRO and must not be passed on to any person or body not authorized by us to receive it nor be copied or otherwise made use either in full or in part by such person or body without our prior permission in writing.

Outotec
The content of these documents are the sole property of Outotec Oyj. Any rights not expressly granted herein are reserved. Reproduction, transfer or distribution of part or all of the contents in any form without prior written permission of Outotec is prohibited.

MA'ADEN معادن
Saudi Arabian Mining Company شركة المعادن العربية السعودية
This document and the information contained herein is Ma'aden proprietary know-how. This document or any part thereof should not be reproduced, stored in a retrieval system or transmitted by any means, electronic or otherwise, or divulged without prior written permission of Ma'aden.

DRAWN	ABS	02/09/2020	MANSOURAH - MASSARAH GOLD PROJECT
CHECKED	SJM	11/09/2020	DETAIL DRAWING
ENGINEER	AVG	03/09/2020	ROUGHER AND SCAVENGER FLOTATION
APPROVED	AG	21/09/2020	DETAILS OF CRANE RAIL FOUNDATION
EMPLOYER			
SCALE 1:5, 1:30, 1:50	A1		DRAWING NUMBER: MD-216-3310-EG-CV-DED-1195 | REV: D01