


DRAWING NUMBER MD-216-3310-EG-CV-GAD-1177 REV D01

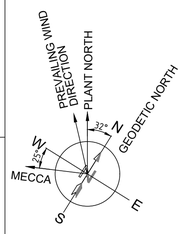


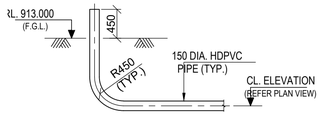

TYP. DET. OF CONDUIT


SCALE 1:50

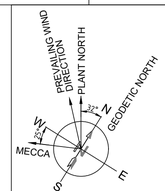

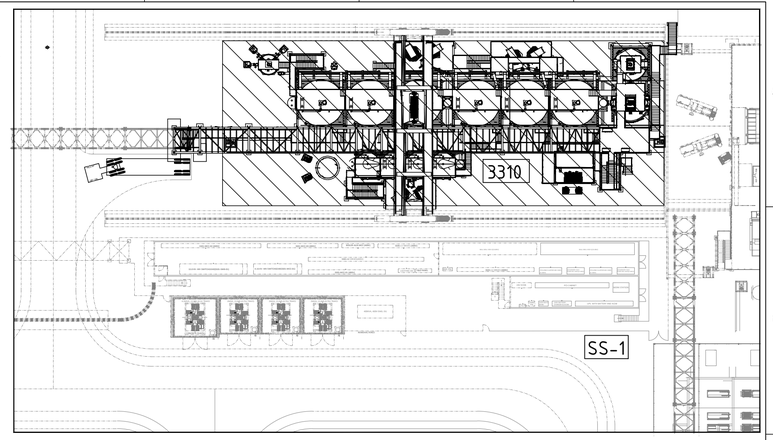

KEY PLAN

SCALE 1:500

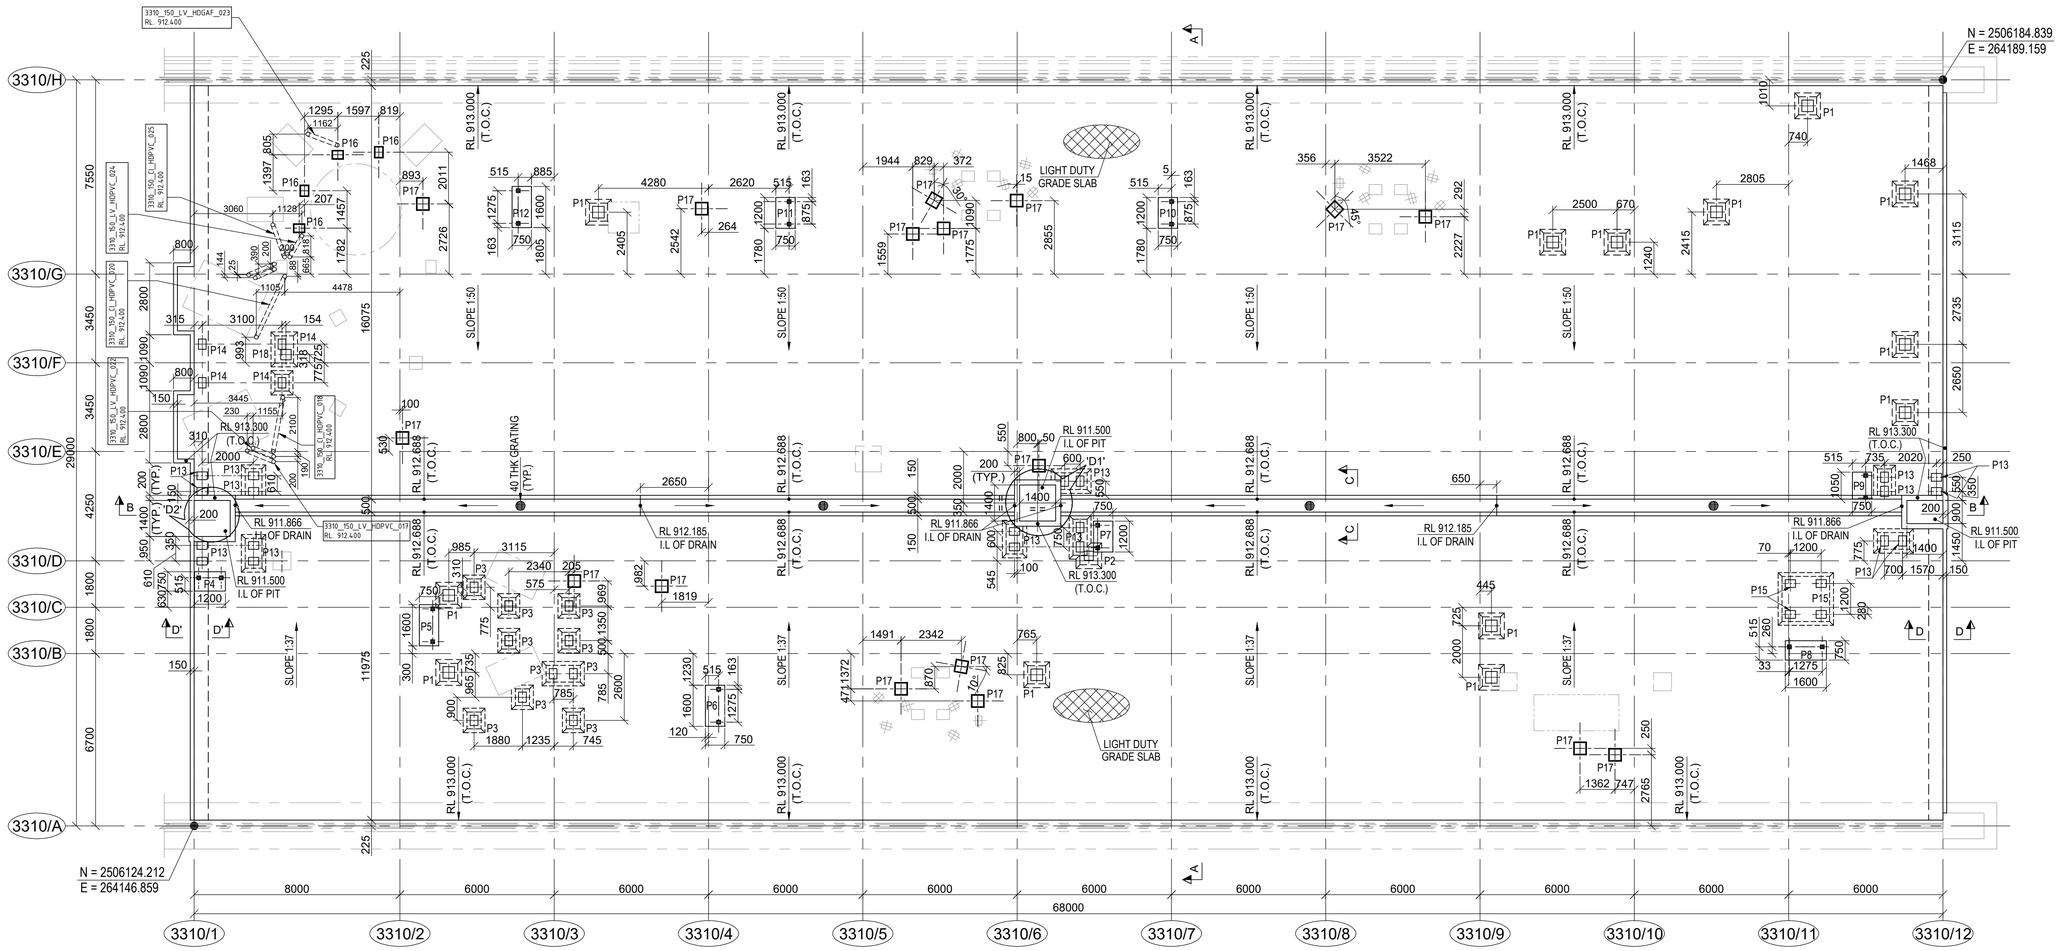

LAYOUT OF GRADE SLAB FOR FLOTATION AREA

SCALE 1:125

ALL CABLE CONDUITS SHALL BE LAID AS PER ELECTRICAL DRG. MD-216-3300-EG-EL-LAD-1001

LEGEND :-

R.L. - REDUCED LEVEL
I.L - INVERT LEVEL
F.G.L - FINISHED GROUND LEVEL
T.O.C. - TOP OF CONCRETE
P.C.C - PLAIN CEMENT CONCRETE
TYP. - TYPICAL
THK - THICKNESS
R - RADIUS
HDPVC - HIGH DENSITY POLYVINYL CHLORIDE

NOTES:-

1. ALL DIMENSIONS ARE IN MILLIMETRES AND LEVELS AND CO-ORDINATES ARE IN METRES UNLESS OTHERWISE STATED.
2. FOR DETAILS OF GRADE SLAB REFER DRG. NO. MD-216-1000-EG-CV-DED-1002.
3. THE CONTENT OF THIS DRAWING SHALL CONFORM TO THE PROVISIONS OF CIVIL, STRUCTURAL AND ARCHITECTURAL DESIGN CRITERIA DOCUMENT NO. MD-216-1000-EG-ST-CRT-1001.
4. THIS DRAWING SHOULD BE READ IN CONJUNCTION WITH DRAWING NO. MD-216-3310-EG-CV-DED-1187.

DOCUMENT NUMBER	REFERENCE DOCUMENTS	REV	DATE	REVISION DESCRIPTION	DRN	CHK	ENG	APP	EMP
		D01	22/02/2023	AS-BUILT	ABS	SJM	AVG	AG	
		C03	04/03/2021	ISSUED FOR CONSTRUCTION & REVISED AS MKD.	ABS	SJM	AVG	AG	
MD-216-3310-EG-CV-GAD-1173	ROUGHER AND SCAVENGER FLOTATION	C02	13/10/2020	ISSUED FOR CONSTRUCTION & REVISED AS MKD.	ABS	SJM	AVG	AG	
MD-216-3310-EG-ME-GAD-1055	FLOTATION ROUGHER/SCAVENGER/CLEANER	C01	29/04/2020	ISSUED FOR CONSTRUCTION & REVISED AS MKD.	ABS	SJM	AVG	AG	
MD-216-3310-EG-ST-GAD-2163	ROUGHER AND SCAVENGER FLOTATION	A01	31/03/2020	ISSUED FOR REFERENCE	ABS	SJM	AVG	AG	

RESERVED FOR VENDOR LOGO AND DRAWING NUMBER

LARSEN & TOUBRO

This drawing is the property of LARSEN & TOUBRO and must not be passed on to any person or body not authorized by us to receive it nor be copied or otherwise made use either in full or in part by such person or body without our prior permission in writing.

Outotec

The content of these documents are the sole property of Outotec Oyj. Any rights not expressly granted herein are reserved. Reproduction, transfer or distribution of part or all of the contents in any form without prior written permission of Outotec is prohibited.

MA'ADEN معادن
Saudi Arabian Mining Company شركة معادن العربية السعودية

This document and the information contained herein is Ma'aden proprietary know-how. This document or any part thereof should not be reproduced, stored in a retrieval system or transmitted by any means, electronic or otherwise, or divulged without prior written permission of Ma'aden.

LARSEN & TOUBRO DRAWING NUMBER	019045_450_C_G_24083_005		REVISION 4
OUTOTEC DRAWING NUMBER	900707__GAU01__ZF01__MTL01__33132	DOCUMENT ID	OU100665312 REVISION 4

DRAWN	ABS	26/03/2020
CHECKED	SJM	30/03/2020
ENGINEER	AVG	26/03/2020
APPROVED	AG	31/03/2020
EMPLOYER		
SCALE	1:125	A1

MANSOURAH - MASSARAH GOLD PROJECT
GENERAL ARRANGEMENT DRAWING
ROUGHER AND SCAVENGER FLOTATION
LAYOUT & DETAIL OF GRADE SLAB

DRAWING NUMBER MD-216-3310-EG-CV-GAD-1177 REV D01