

DRAWING NUMBER MD-216-39WQ-EG-CV-DED-1450 REV D01

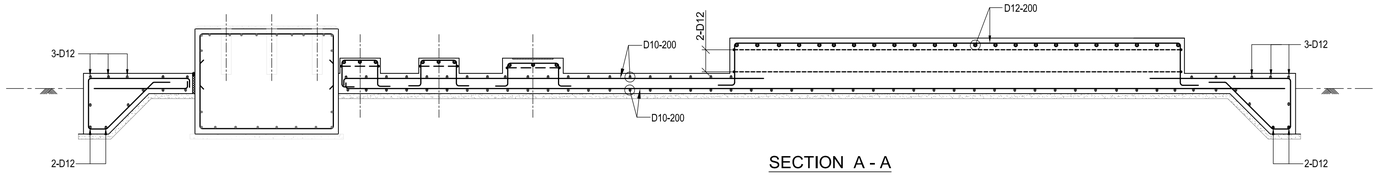

SECTION A - A

(SHOWING RC DETAIL)


(SCALE - 1:30)

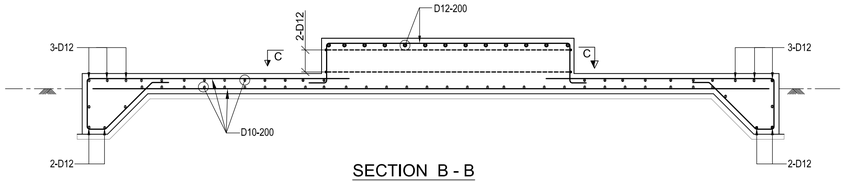

SECTION B - B


(SHOWING RC DETAIL)

(SCALE - 1:30)

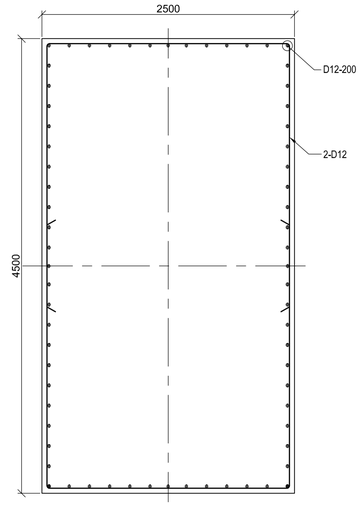

SECTION C - C


(SCALE - 1:30)

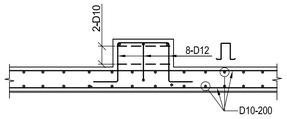

SECTION 1 - 1

(SECTION FOR P1, P2 , P3, P5 & P6)


(SCALE 1:25)

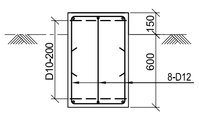

SECTION 1 - 1

(SECTION FOR P1A & P4)


(SCALE 1:25)

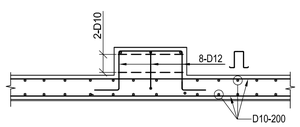

SECTION 2 - 2


(SECTION FOR P7)

(SCALE 1:25)

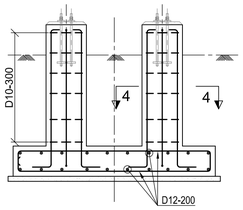

SECTION 3 - 3


(SCALE - 1:30)

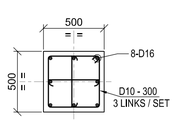

SECTION 4 - 4


(SECTION FOR P8)

(SCALE 1:25)

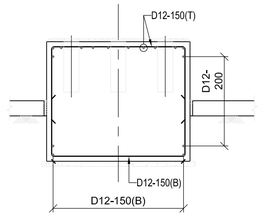

SECTION 5 - 5


(SCALE 1:30)

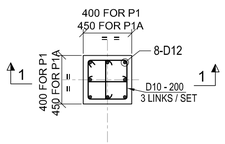

RC DETAIL OF PEDESTAL

MKD. P1, P1A, P2, P3 & P6


(SCALE 1:25)

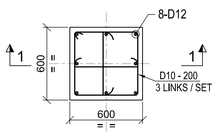

RC DETAIL OF PEDESTAL

MKD. P4 & P5


(SCALE 1:25)

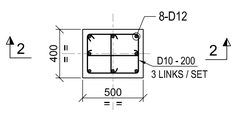

RC DETAIL OF PEDESTAL

MKD. P7


(SCALE 1:25)

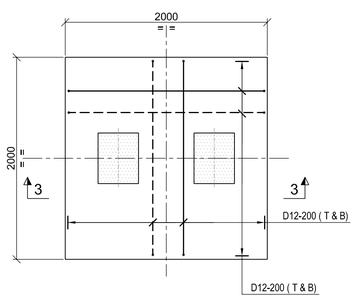

RC DETAIL OF FOOTING

MKD. F1

(SCALE 1:30)

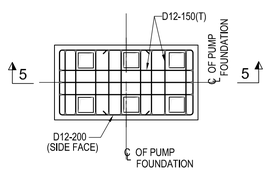

RC DETAIL OF PUMP MKD.

39WQ-PMP-010 & 39WQ-PMP-011

(SCALE 1:30)

LEGEND :-

R.L. - REDUCED LEVEL
℄ - CENTRE LINE
T.O.C. - TOP OF CONCRETE
TYP. - TYPICAL
F.G.L. - FINISHED GROUND LEVEL
F.F.L. - FINISHED FLOOR LEVEL
B.O.F. - BOTTOM OF FOUNDATION
MKD. - MARKED
P.C.C. - PLAIN CEMENT CONCRETE
N.T.S. - NOT TO SCALE
EXP. JT. - EXPANSION JOINT
DET. - DETAIL
BOTTOM REINFORCEMENT (B) - ————
TOP REINFORCEMENT (T) - – – – – –
SQ. - SQUARE
R.C. - REINFORCED CONCRETE
FDN. - FOUNDATION
THK. - THICK
GA-GENERAL ARRANGEMENT
REF.- REFER
DWG.-DRAWING
DIA. - DIAMETER
R.C.C. - REINFORCED CEMENT CONCRETE

NOTES:-

1. ALL DIMENSIONS ARE IN MILLIMETRES AND LEVELS AND CO-ORDINATES ARE IN METRES UNLESS OTHERWISE STATED.
2. GRADE OF CONCRETE SHALL BE C35 (35MPa) FOR FOUNDATION & C15 (15MPa) FOR BLINDING CONCRETE.
3. GRADE OF REINFORCEMENT SHALL BE DEFORMED BAR 420 MPa (GRADE 60) - ASTM A615/A615M.
4. IF ANY PART OF FOUNDATION COMES ON BACKFILL ZONE OF ADJACENT FOUNDATION OR ANY LOOSE SOIL ARE ENCOUNTERED BELOW FOUNDATION LEVEL THE SAME SHALL BE REMOVED AND FILLED WITH PCC (C15).
5. CLEAR COVER TO REINFORCEMENT SHALL BE
   a. FOUNDATIONS = 50 MM., b. COLUMNS = 50 MM., c. GRADE SLAB = 25 MM.
6. FOR STANDARD REINFORCEMENT DETAIL & GENERAL NOTES FOR CIVIL WORKS REFER DRAWING NO. MD-216-1000-EG-CV-DED-1005 & 1001.

DOCUMENT NUMBER	REFERENCE DOCUMENTS			REVISION DESCRIPTION	DRN	CHK	ENG	APP	EMP
		D01	08/09/2023	AS-BUILT	AMJ	SJM	AVG	AG	
MD-216-39WQ-EG-CV-GAD-1001	LAYOUT & DETAILS OF FOUNDATIONS & GRADE SLAB	C01	09/03/2021	ISSUED FOR CONSTRUCTION	AMJ	SJM	AVG	AG	
MD-216-1000-EG-ST-CRT-1001	CIVIL,STRUCTURAL AND ARCHITECTURAL DESIGN CRITERIA	A01	04/02/2021	ISSUED FOR APPROVAL	AMJ	SJM	AVG	AG	

RESERVED FOR VENDOR LOGO AND DRAWING NUMBER

LARSEN & TOUBRO

This drawing is the property of *LARSEN & TOUBRO* and must not be passed on to any person or body not authorized by us to receive it nor be copied or otherwise made use either in full or in part by such person or body without our prior permission in writing.

Outotec

The content of these documents are the sole property of Outotec Oyj. Any rights not expressly granted herein are reserved. Reproduction, transfer or distribution of part or all of the contents in any form without prior written permission of Outotec is prohibited.

MA'ADEN معادن
Saudi Arabian Mining Company شركة التعدين العربية السعودية

This document and the information contained herein is Ma'aden proprietary know-how. This document or any part thereof should not be reproduced, stored in a retrieval system or transmitted by any means, electronic or otherwise, or divulged without prior written permission of Ma'aden.

LARSEN & TOUBRO DRAWING NUMBER: 019045_080_C_D_24180_001 — REVISION: 2

OUTOTEC DRAWING NUMBER: 900707__GAU01__AG35__CTB05__39102 — DOCUMENT ID: OU100712478 — REVISION: 2

DRAWN	AMJ	22/01/2021
CHECKED	SJM	24/01/2021
ENGINEER	AVG	28/01/2021
APPROVED	AG	04/02/2021
EMPLOYER		
SCALE 1:75, 1:25 & 1:15		A1

MANSOURAH - MASSARAH GOLD PROJECT

DETAIL DRAWING

MINE WATER SYSTEM

RC DETAIL OF FDN. AND GRADE SLAB

DRAWING NUMBER: MD-216-39WQ-EG-CV-DED-1450 — REV: D01