


DRAWING NUMBER MD-216-39WQ-EG-CV-DED-1451 REV D01

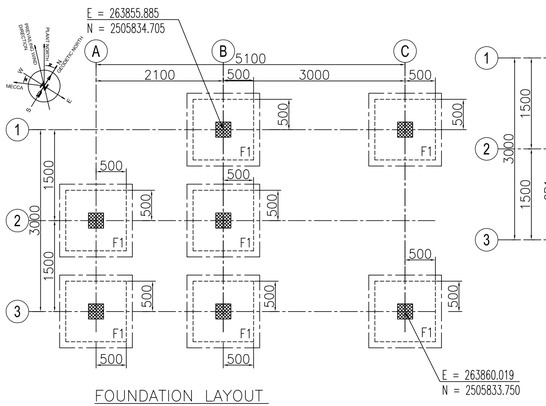


FOUNDATION LAYOUT
SCALE 1:50

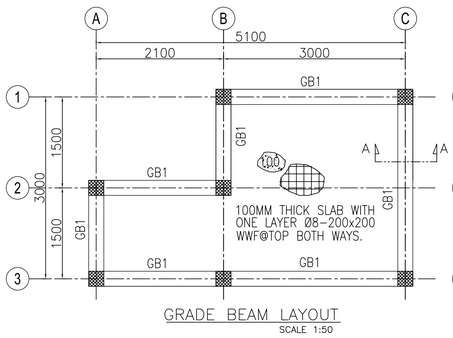


GRADE BEAM LAYOUT
SCALE 1:50

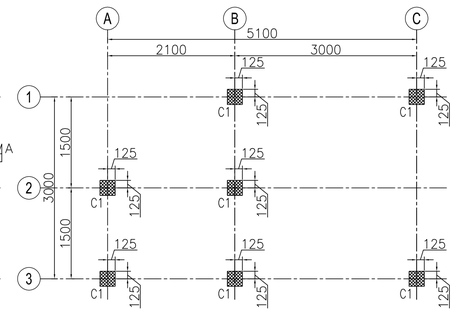


COLUMN LAYOUT
SCALE 1:50

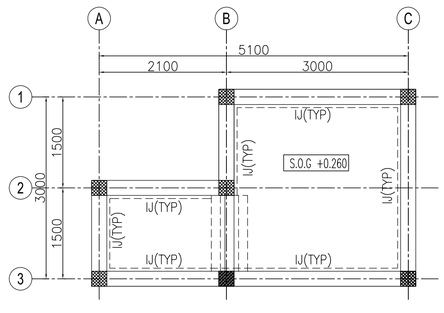


CONCRETE JOINTS LAYOUT
SCALE 1:50

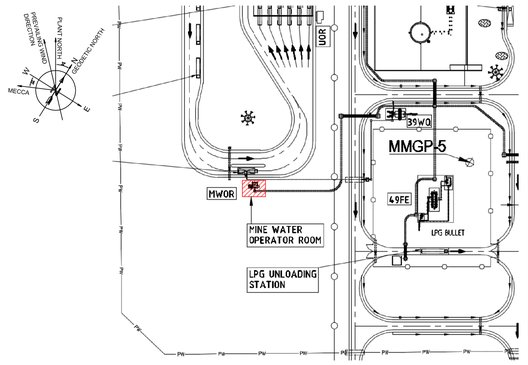


KEY PLAN

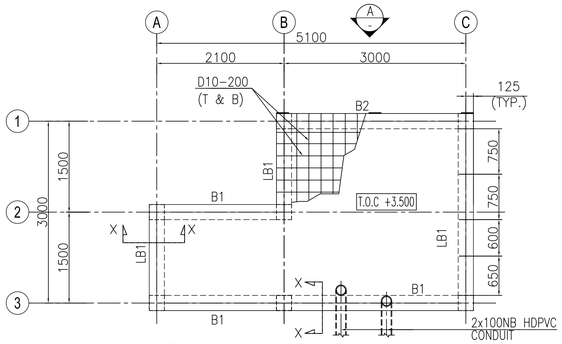

ROOF HOLLOW CORE SLAB LAYOUT
SCALE 1:50

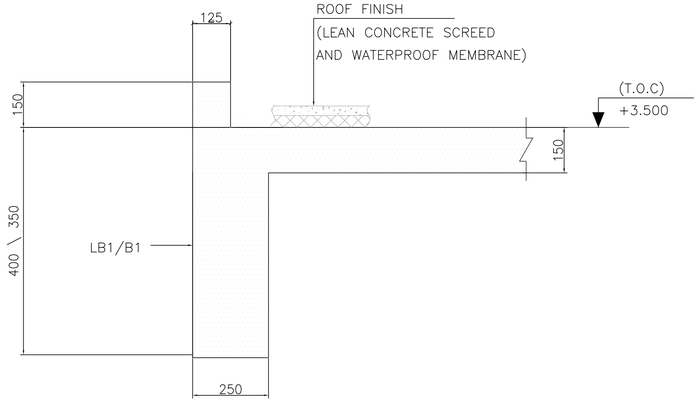

SECTION X-X
(SCALE 1:20)

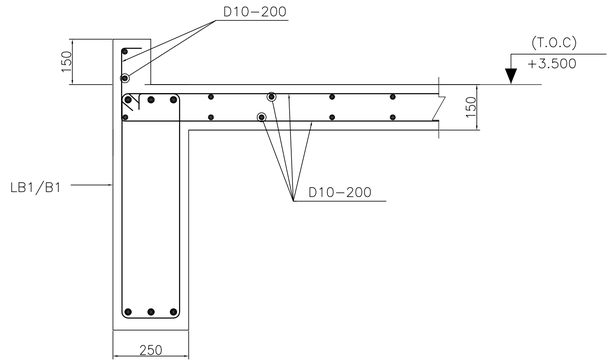

SECTION X-X
(SHOWING RC DETAIL)
(SCALE 1:20)

SCHEDULE OF FOOTINGS


FOOTING MARK	PLAIN CONCRETE			REINFORCED CONCRETE			BOTTOM REINFORCEMENT		TOP REINFORCEMENT		Ha	REMARKS
	L	W	T	L	W	T	SHORT BARS	LONG BARS	SHORT BARS	LONG BARS		
F1	1200	1200	50	1000	1000	300	ø12@200	ø12@200	–	–	1200	

SCHEDULE OF GRADE BEAMS

BEAM MARK	DIMENSIONS		STEEL REINFORCEMENT				SIDE BAR EACH FACE	STIRRUPS
			BOTTOM		TOP			
	WIDTH	DEPTH	STRAIGHT	ADD.	STRAIGHT	ADD.		
GB1	250	700	3ø20	–	3ø20	–	1ø12	PROVIDE ø10@150 AT END SPAN@DISTANCE OF L/3 FROM THE SUPPORT & ø10@200 AT MIDSPAN

SCHEDULE OF ROOF BEAMS


BEAM MARK	DIMENSIONS		STEEL REINFORCEMENT				STIRRUPS	REMARKS
			TOP		BOTTOM			
	WIDTH	DEPTH	STRAIGHT	ADD.	STRAIGHT	ADD.		
LB1	250	400	3ø12	–	3ø12	–	PROVIDE ø10@150 AT THE DISTANCE OF L/3 FROM THE SUPPORT IN END SPAN & ø10@200 IN THE MID SPAN	REFER DETAIL-X
B1	250	350	3ø12	–	3ø12	–	PROVIDE ø10@100 AT THE DISTANCE OF L/3 FROM THE SUPPORT IN END SPAN & ø10@125 IN THE MID SPAN	REFER DETAIL-R
B2	250	500	3ø16	–	3ø16	–	PROVIDE ø10@140 BOTH IN END SPAN & MIDSPAN	REFER DETAIL-W

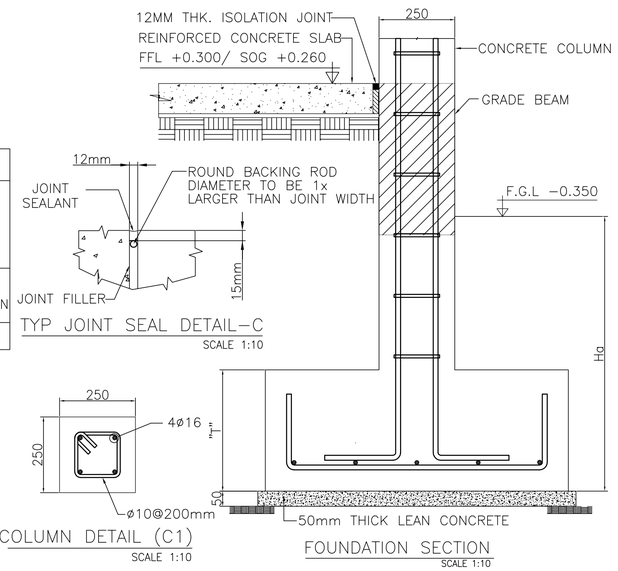

TYP JOINT SEAL DETAIL-C
SCALE 1:10


COLUMN DETAIL (C1)
SCALE 1:10

FOUNDATION SECTION
SCALE 1:10

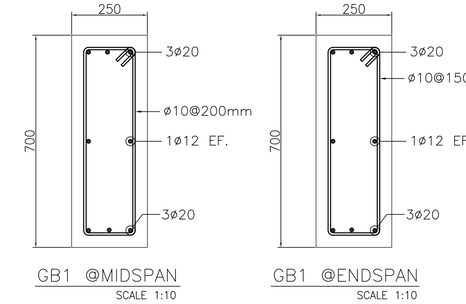

GB1 @MIDSPAN
SCALE 1:10

GB1 @ENDSPAN
SCALE 1:10

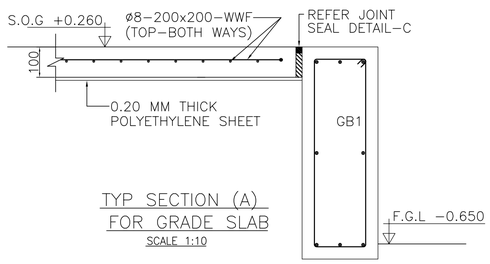

TYP SECTION (A)
FOR GRADE SLAB
SCALE 1:10

NOTES

1. ALL DIMENSIONS ARE GIVEN IN MILLIMETRES AND ELEVATIONS ARE IN METRES UNLESS OTHERWISE NOTED.
2. MINIMUM REINFORCED CONCRETE GRADE TO BE USED FOR SUPERSTRUCTURE & SUBSTRUCTURES IS C35(5000 PSI).
3. MINIMUM LEAN CONCRETE GRADE TO BE USED FOR THE SUB-STRUCTURES IS C15(2175 PSI).
4. ALL REINFORCING STEEL SHALL BE DEFORMED BILLET STEEL BARS CONFORMING TO ASTM-A615, WITH MINIMUM YIELD STRENGTH OF FY420 MPA .
5. THE NET SOIL BEARING CAPACITY CONSIDERED IN FOUNDATION DESIGN IS 250 KPA(REFER DOC 216-3000-EG-CV-RPT-1008)
6. WATER PROOFING INSULATION SHALL BE AS PER PROJECT SPECIFICATIONS & ITS MATERIAL TO BE APPROVED BY SITE ENGINEER.
7. MINIMUM CONCRETE COVER AS PER SBC-304-2018(TABLE 20.6.1.3.1) MEASURED FROM REBAR SHALL BE
   a. CONCRETE CAST AGAINST & PERMANENTLY EXPOSED TO EARTH (INCLUDING FOUNDATIONS OVER SUB-SLAB) FORMED CONCRETE EXPOSED TO EARTH OR WEATHER.....50MM
   b. CONCRETE NOT EXPOSED TO WEATHER NOR IN CONTACT WITH GROUND
      BEAMS, COLUMNS.....40MM
      SLABS, WALLS, JOISTS.....20MM
   c. CONCRETE SLAB OVER 50MM SUB-SLAB.....20MM
8. ALL DRAWINGS MUST BE READ IN CONJUNCTION WITH RELEVANT ARCHITECTURAL AND ENGINEERING DRAWINGS RELATED TO THE SAME SHEET AND ANY ITEM ON IT.
9. F.F.L +0.300 MENTIONED IS EQUIVALENT TO RL 913.850m.

LEGENDS

F/FDN.-FOUNDATION
CR-COLUMN NECK
C/COL.-COLUMN
FFL-FINISH FLOOR LEVEL
FGL-FINISH GROUND LEVEL
VER-VERTICAL
WWF-WELDED WIRE FABRIC
HCS-HOLLOW CORE SLAB
GB-GRADE BEAM
IJ-ISOLATION JOINT
ø- DIAMETER
DOC.-DOCUMENT
TOS-TOP OF SLAB
CJ-CONTROL JOINT
BW's-BOTH WAYS
S.O.G-SLAB ON GRADE
TYP-TYPICAL
HOR.-HORIZONTAL
REINF.-REINFORCEMENT
LVL.-LEVEL
RL.-REDUCED LEVEL
P.-PEDESTAL
EF. - EACH FACE
DIA-DIAMETER

DOCUMENT NUMBER	REFERENCE DOCUMENTS	REV	DATE	REVISION DESCRIPTION	DRN	CHK	ENG	APP	EMP
		D01	08/09/2023	AS-BUILT	SYA	SJM	AVG	AG	
		C02	14/09/2021	ISSUED FOR CONSTRUCTION & REVISED AS MARKED /C02	SYA	SJM	AVG	AG	
MD-216-1000-EG-ST-CRT-1001	CIVIL, STRUCTURAL & ARCHITECTURAL-	C01	18/02/2021	ISSUED FOR CONSTRUCTION	MNS	SJM	AVG	AG	
	DESIGN CRITERIA	A01	13/01/2021	ISSUED FOR APPROVAL	MNS	SJM	AVG	AG	

DESIGNER:

LARSEN & TOUBRO

This drawing is the property of LARSEN & TOUBRO and must not be passed on to any person or body not authorized by us to receive it nor be copied or otherwise made use either in full or in part by such person or body without our prior permission in writing.

Outotec

The content of these documents are the sole property of Outotec Oyj. Any rights not expressly granted herein are reserved. Reproduction, transfer or distribution of part or all of the contents in any form without prior written permission of Outotec is prohibited.

MA'ADEN معادن
Saudi Arabian Mining Company شركة التعدين العربية السعودية

This document and the information contained herein is Ma'aden proprietary know-how. This document or any part thereof should not be reproduced, stored in a retrieval system or transmitted by any means, electronic or otherwise, or divulged without prior written permission of Ma'aden.

LARSEN & TOUBRO DRAWING NUMBER: 019045_080_C_D_24180_002 — REVISION: 3
OUTOTEC DRAWING NUMBER: 900707__GAU01__AG35__CTB05__39101 — DOCUMENT ID: 0U100711098 — REVISION: 3

DRAWN	MNS	28/12/2020
CHECKED	SJM	29/12/2020
ENGINEER	AVG	28/12/2020
APPROVED	AG	13/01/2021
EMPLOYER		
SCALE	1:50	A1

MANSOURAH - MASSARAH GOLD PROJECT
DETAIL DRAWING
MINE WATER AREA : OPERATOR ROOM
DETAILS OF BUILDING STRUCTURE

DRAWING NUMBER: MD-216-39WQ-EG-CV-DED-1451 — REV: D01