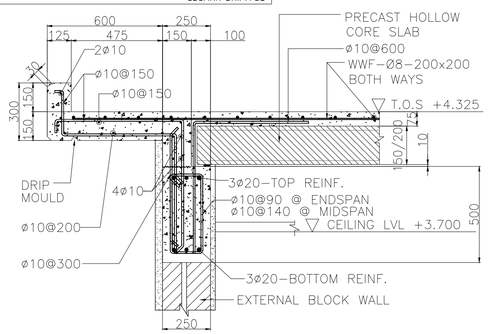
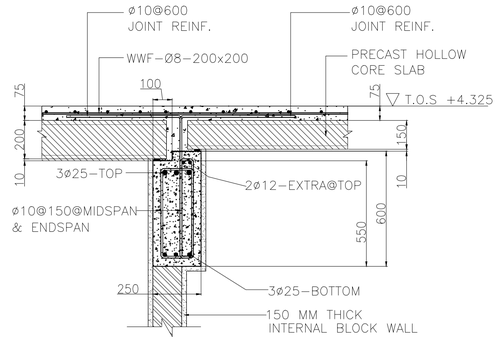
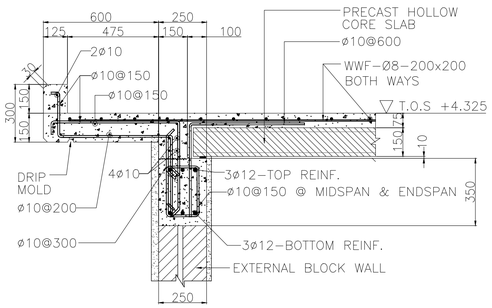
| REV | DRAWING NUMBER |
|---|---|
| D01 | MD-216-49BL-EG-CV-DED-1066 |



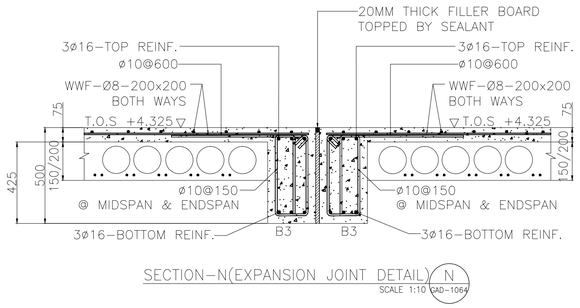

SECTION-Y (LB1)
SCALE 1:10 CAD-1064



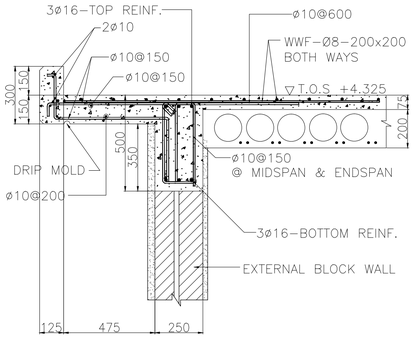

SECTION-W (LB2)
SCALE 1:10 CAD-1064



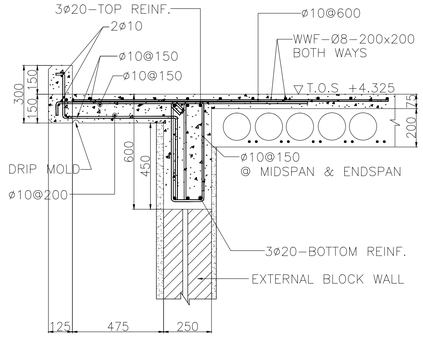

SECTION-S (LB3)
SCALE 1:10 CAD-1064



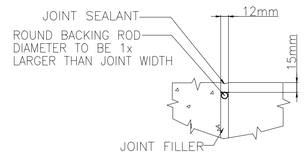

SECTION-N(EXPANSION JOINT DETAIL) (N)
SCALE 1:10 CAD-1064




SECTION-X1 (B1)
SCALE 1:10 CAD-1064




SECTION-X (B2)
SCALE 1:10 CAD-1064

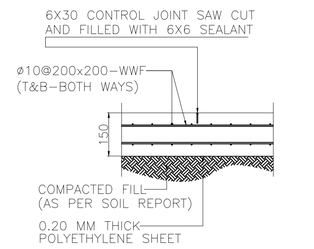



TYP JOINT SEAL DETAIL (C)
SCALE 1:10 DED-1065

## SCHEDULE OF ROOF BEAMS

| BEAM MARK | DIMENSIONS | | STEEL REINFORCEMENT | | | | STIRRUPS | REMARKS |
|---|---|---|---|---|---|---|---|---|
| | | | BOTTOM | | TOP | | | |
| | WIDTH | DEPTH | STRAIGHT | ADD. | STRAIGHT | ADD. | | |
| LB1 | 250 | 500 | 3ø20 | – | 3ø20 | – | PROVIDE ø10@90@ ENDSPAN & ø10@140 THE MID SPAN | REFER DETAIL-Y |
| LB2 | 250 | 550 | 3ø25 | – | 3ø25 | – | PROVIDE ø10@150 BOTH @ MIDSPAN & THE END SPAN | REFER DETAIL-W |
| LB3 | 250 | 350 | 3ø12 | – | 3ø12 | – | PROVIDE ø10@150 BOTH @ MIDSPAN & THE END SPAN | REFER DETAIL-S |
| B1 | 250 | 500 | 3ø16 | – | 3ø16 | – | PROVIDE ø10@150 BOTH @ MIDSPAN & THE END SPAN | REFER DETAIL-X1 |
| B2 | 250 | 600 | 3ø20 | – | 3ø20 | – | PROVIDE ø10@150 BOTH @ MIDSPAN & THE END SPAN | REFER DETAIL-X |
| B3 | 250 | 500 | 3ø16 | – | 3ø16 | – | PROVIDE ø10@150 BOTH @ MIDSPAN & THE END SPAN | REFER DETAIL-N |
| | | | | | | | | |
| | | | | | | | | |

NOTE: CONTROL JOINTS SHALL BE PROVIDED AT MAX SPACING OF 20 FT (6.10 M) AS PER ACI CODE




TYP CONTROL JOINT (CJ) DETAIL (B)
SCALE 1:10 CAD-1064

## NOTES

1. ALL DIMENSIONS ARE GIVEN IN MILLIMETRES AND ELEVATIONS ARE IN METRES UNLESS OTHERWISE NOTED.
2. MINIMUM REINFORCED CONCRETE GRADE TO BE USED FOR SUPERSTRUCTURE & SUBSTRUCTURES IS C35(5000 PSI).
3. MINIMUM LEAN CONCRETE GRADE TO BE USED FOR THE SUB-STRUCTURES IS C15(2175 PSI).
4. ALL REINFORCING STEEL SHALL BE DEFORMED BILLET STEEL BARS CONFORMING TO ASTM-A615, WITH MINIMUM YIELD STRENGTH OF FY420 MPA .
5. THE NET SOIL BEARING CAPACITY CONSIDERED IN FOUNDATION DESIGN IS 570 KPA(REFER DOC 216-3000-EG-CV-RPT-1008)
6. WATER PROOFING INSULATION SHALL BE AS PER PROJECT SPECIFICATIONS & ITS MATERIAL TO BE APPROVED BY SITE ENGINEER.
7. MINIMUM CONCRETE COVER AS PER SBC-304-2018(TABLE 20.6.1.3.1) MEASURED FROM REBAR SHALL BE
   a. CONCRETE CAST AGAINST & PERMANENTLY EXPOSED TO EARTH (INCLUDING FOUNDATIONS OVER SUB-SLAB) FORMED CONCRETE EXPOSED TO EARTH OR WEATHER.....50MM
   b. CONCRETE NOT EXPOSED TO WEATHER NOR IN CONTACT WITH GROUND
      BEAMS, COLUMNS.....40MM
      SLABS, WALLS, JOISTS.....20MM
   c. CONCRETE SLAB OVER 50MM SUB-SLAB.....20MM
8. ALL DRAWINGS MUST BE READ IN CONJUNCTION WITH RELEVANT ARCHITECTURAL AND ENGINEERING DRAWINGS RELATED TO THE SAME SHEET AND ANY ITEM ON IT.
9. F.F.L +0.00 MENTIONED IS EQUIVALENT TO RL 913.500

LEGENDS
F/FDN.-FOUNDATION
CR-COLUMN NECK
C/COL.-COLUMN
FFL-FINISH FLOOR LEVEL
FGL-FINISH GROUND LEVEL
TOS-TOP OF SCREED
WWF-WELDED WIRE FABRIC
HCS-HOLLOW CORE SLAB
GB-GRADE BEAM
IJ-ISOLATION JOINT
CJ-CONTROL JOINT
BW's-BOTH WAYS
S.O.G-SLAB ON GRADE
ARCH-ARCHITECTURAL
HOR.-HORIZONTAL
REINF.-REINFORCEMENT
LVL.-LEVEL
RL.-REDUCED LEVEL
P.-PEDESTAL
℄-CENTRE LINE OF COLUMN

| DOCUMENT NUMBER | REFERENCE DOCUMENTS | REV | DATE | REVISION DESCRIPTION | DRN | CHK | ENG | APP | EMP |
|---|---|---|---|---|---|---|---|---|---|
| MD-216-6000-EG-CV-STD-1002 | HOLLOW CORE SLAB STANDARD | D01 | 08/09/2023 | AS-BUILT | -- | AVG | -- | SJM | |
| MD-216-6000-EG-CV-STD-1001 | REINFORCEMENT STANDARD | C02 | 13/01/2021 | ISSUED FOR CONSTRUCTION & REVISED AS MARKED (02) | -- | AVG | -- | SJM | |
| MD-216-498L-EG-AR-GAD-3012 | BUILDING ELEVATIONS & SECTIONS | C01 | 30/06/2020 | ISSUED FOR CONSTRUCTION | -- | AVG | -- | SJM | |
| MD-216-498L-EG-AR-GAD-3011 | BUILDING PLANS | A01 | 31/05/2020 | ISSUED FOR APPROVAL | -- | AVG | -- | SJM | |

DESIGNER:
مكتب الخليج للاستشارات الهندسية
المبرد المملكة العربية السعودية
GULF CONSULT
ARCHITECTS AND ENGINEERS

| DRAWING NUMBER | | | | | | REVISION |
|---|---|---|---|---|---|---|
| LABORATORY BUILDING-ST-001 | | | | | | 0 |
| DATE | 27/05/2020 | DATE | 28/05/2020 | DATE | 29/05/2020 | |
| DRAWN | MAH | CHECKED | MF | APPROVED | FK | |

| LARSEN & TOUBRO DRAWING NUMBER | | REVISION |
|---|---|---|
| 019045_300_C_D_24027_002 | | 3 |
| OUTOTEC DRAWING NUMBER | DOCUMENT ID | REVISION |
| 900707__GAU01__AL01__CTB05__69001 | OU100684632 | 3 |

LARSEN & TOUBRO

This drawing is the property of LARSEN & TOUBRO and must not be passed on to any person or body not authorized by us to receive it nor be copied or otherwise made use either in full or in part by such person or body without our prior permission in writing.

Outotec

The content of these documents are the sole property of Outotec Oyj. Any rights not expressly granted herein are reserved. Reproduction, transfer or distribution of part or all of the contents in any form without prior written permission of Outotec is prohibited.

MA'ADEN معادن
Saudi Arabian Mining Company شركة معادن العربية السعودية

This document and the information contained herein is Ma'aden proprietary know-how. This document or any part thereof should not be reproduced, stored in a retrieval system or transmitted by any means, electronic or otherwise, or divulged without prior written permission of Ma'aden.

| | | |
|---|---|---|
| DRAWN | -- | -- |
| CHECKED | AVG | 30/05/2020 |
| ENGINEER | -- | -- |
| APPROVED | SJM | 31/05/2020 |
| EMPLOYER | | |
| SCALE | 1:150 | A1 |

MANSOURAH - MASSARAH GOLD PROJECT
DETAIL DRAWING
PROCESS PLANT : LABORATORY BUILDING
DETAIL OF ROOF & GRADE SLAB

| DRAWING NUMBER | REV |
|---|---|
| MD-216-49BL-EG-CV-DED-1066 | D01 |