


DRAWING NUMBER: MD-216-498L-EG-CV-GAD-1063 | REV: D01

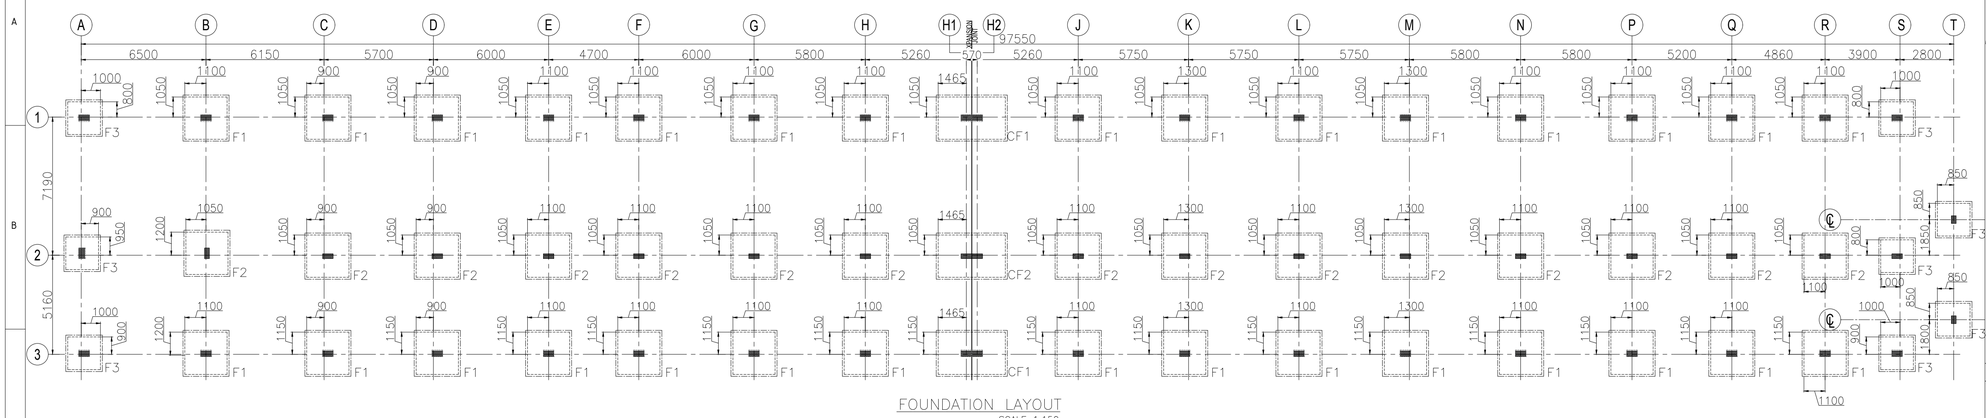

FOUNDATION LAYOUT
SCALE 1:150

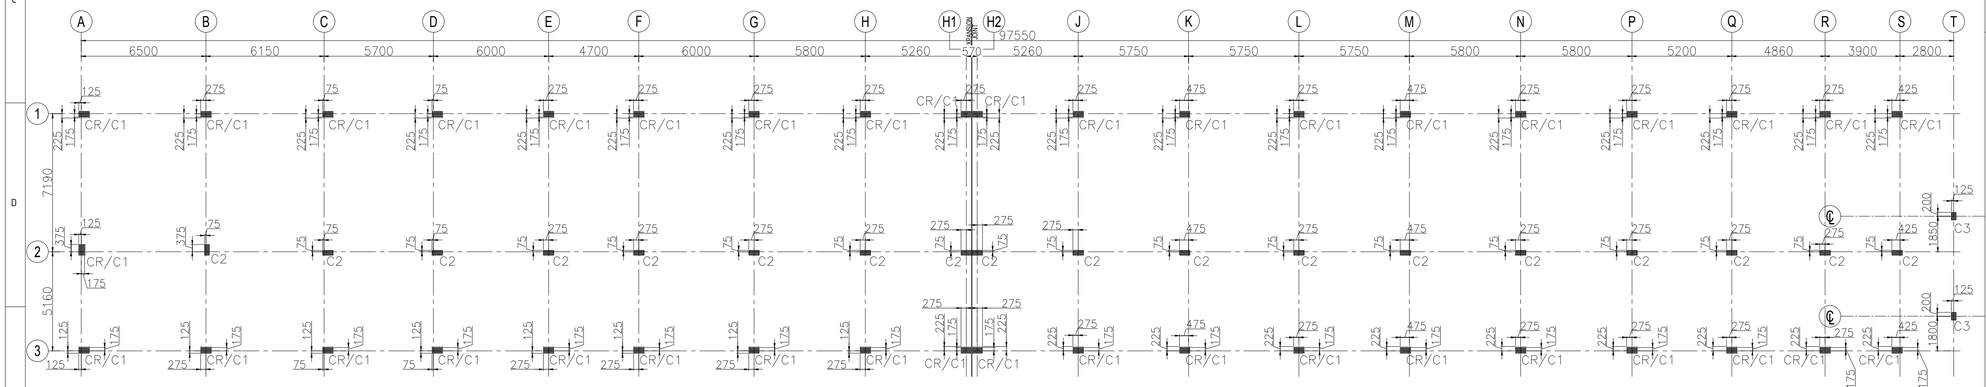


COLUMN LAYOUT
SCALE 1:150

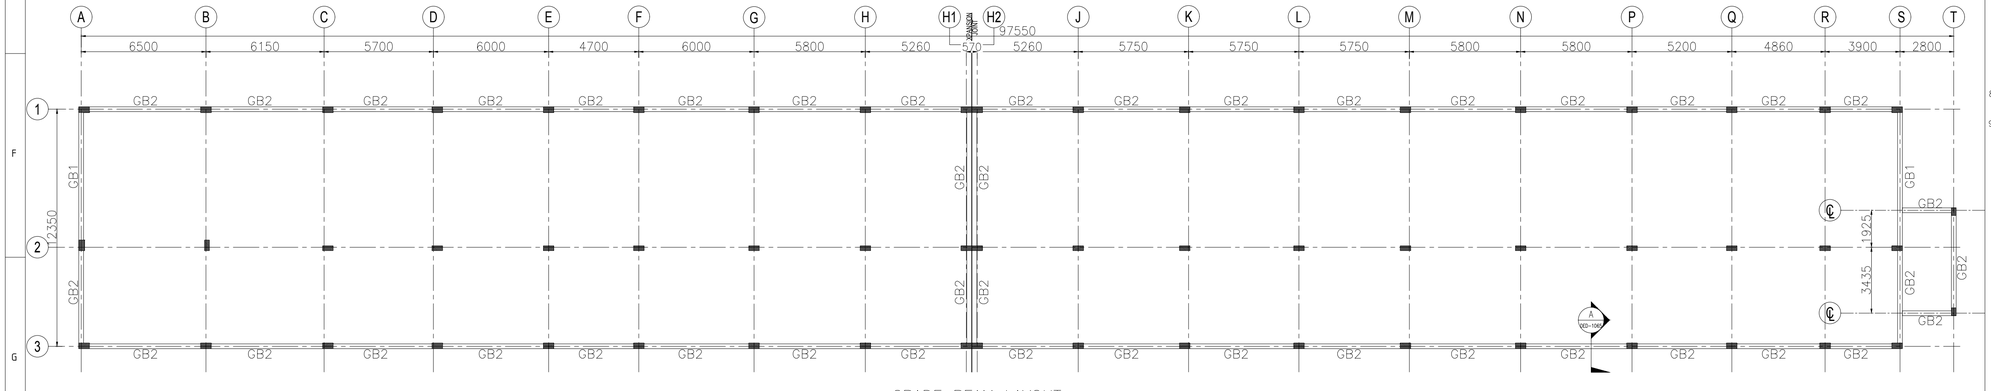


GRADE BEAM LAYOUT
SCALE 1:150

MASTER KEY PLAN

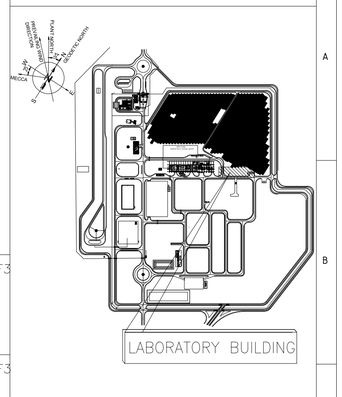

ENLARGED KEYPLAN

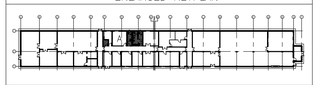

LABORATORY BUILDING			
BLDG NO.	CORNER NO.	EASTING	NORTHING
A	S-1	E264208.537	N2506301.630
	A-3	E264134.729	N2506240.946

NOTES

1. ALL DIMENSIONS ARE GIVEN IN MILLIMETRES AND ELEVATIONS ARE IN METRES UNLESS OTHERWISE NOTED.
2. MINIMUM REINFORCED CONCRETE GRADE TO BE USED FOR SUPERSTRUCTURE & SUBSTRUCTURES IS C35(5000 PSI).
3. MINIMUM LEAN CONCRETE GRADE TO BE USED FOR THE SUB-STRUCTURES IS C15(2175 PSI).
4. ALL REINFORCING STEEL SHALL BE DEFORMED BILLET STEEL BARS CONFORMING TO ASTM-A615, WITH MINIMUM YIELD STRENGTH OF FY420 MPA.
5. THE NET SOIL BEARING CAPACITY CONSIDERED IN FOUNDATION DESIGN IS 570 KPA(REFER DOC 216-3000-EG-CV-RPT-1008)
6. WATER PROOFING INSULATION SHALL BE AS PER PROJECT SPECIFICATIONS & ITS MATERIAL TO BE APPROVED BY SITE ENGINEER.
7. MINIMUM CONCRETE COVER AS PER SBC-304-2018(TABLE 20.6.1.3.1) MEASURED FROM REBAR SHALL BE
   a. CONCRETE CAST AGAINST & PERMANENTLY EXPOSED TO EARTH (INCLUDING FOUNDATIONS OVER SUB-SLAB) FORMED CONCRETE EXPOSED TO EARTH OR WEATHER.....50MM
   b. CONCRETE NOT EXPOSED TO WEATHER NOR IN CONTACT WITH GROUND
      BEAMS, COLUMNS.....40MM
      SLABS, WALLS, JOISTS.....20MM
   c. CONCRETE SLAB OVER 50MM SUB-SLAB.....20MM
8. ALL DRAWINGS MUST BE READ IN CONJUNCTION WITH RELEVANT ARCHITECTURAL AND ENGINEERING DRAWINGS RELATED TO THE SAME SHEET AND ANY ITEM ON IT.
9. F.F.L +0.00 MENTIONED IS EQUIVALENT TO RL 913.500

LEGENDS

F/FDN.-FOUNDATION
CR-COLUMN NECK
C/COL.-COLUMN
FFL-FINISH FLOOR LEVEL
FGL-FINISH GROUND LEVEL
TOS-TOP OF SCREED
WWF-WELDED WIRE FABRIC
HCS-HOLLOW CORE SLAB
GB-GRADE BEAM
IJ-ISOLATION JOINT
CJ-CONTROL JOINT
BW's-BOTH WAYS
S.O.G-SLAB ON GRADE
ARCH-ARCHITECTURAL
HOR.-HORIZONTAL
REINF.-REINFORCEMENT
LVL.-LEVEL
RL.-REDUCED LEVEL
P.-PEDESTAL
℄ -CENTRE LINE OF COLUMN/GRADE BEAM

DOCUMENT NUMBER	REFERENCE DOCUMENTS	REV	DATE	REVISION DESCRIPTION	DRN	CHK	ENG	APP	EMP
MD-216-6000-EG-CV-STD-1002	HOLLOW CORE SLAB STANDARD								
MD-216-6000-EG-CV-STD-1001	REINFORCEMENT STANDARD	D01	08/09/2023	AS-BUILT	--	AVG	--	SJM	
MD-216-498L-EG-AR-GAD-3012	BUILDING ELEVATIONS & SECTIONS	C01	06/07/2020	ISSUED FOR CONSTRUCTION	--	AVG	--	SJM	
MD-216-498L-EG-AR-GAD-3011	BUILDING PLANS	A01	31/05/2020	ISSUED FOR APPROVAL	--	AVG	--	SJM	

DESIGNER: مكتب الخليج للاستشارات الهندسية — الخبر، المملكة العربية السعودية — GULF CONSULT ARCHITECTS AND ENGINEERS

DRAWING NUMBER					REVISION
LABORATORY BUILDING-ST-001					0
DATE	27/05/2020	DATE	28/05/2020	DATE	29/05/2020
DRAWN	MAH	CHECKED	MF	APPROVED	FK

LARSEN & TOUBRO DRAWING NUMBER		REVISION
O19045_300_C_G_24026_001		2
OUTOTEC DRAWING NUMBER	DOCUMENT ID	REVISION
900707 __GAU01 __AL01__MTL01__ 69009	OU100688038	2

LARSEN & TOUBRO
This drawing is the property of LARSEN & TOUBRO and must not be passed on to any person or body not authorized by us to receive it nor be copied or otherwise made use either in full or in part by such person or body without our prior permission in writing.

Outotec
The content of these documents are the sole property of Outotec Oyj. Any rights not expressly granted herein are reserved. Reproduction, transfer or distribution of part or all of the contents in any form without prior written permission of Outotec is prohibited.

MA'ADEN معادن
Saudi Arabian Mining Company شركة معادن العربية السعودية
This document and the information contained herein is Ma'aden proprietary know-how. This document or any part thereof should not be reproduced, stored in a retrieval system or transmitted by any means, electronic or otherwise, or divulged without prior written permission of Ma'aden.

DRAWN	--	--
CHECKED	AVG	30/05/2020
ENGINEER	--	--
APPROVED	SJM	31/05/2020
EMPLOYER		
SCALE	1:150	A1

MANSOURAH - MASSARAH GOLD PROJECT
GENERAL ARRANGEMENT DRAWING
PROCESS PLANT : LABORATORY BUILDING
LAYOUT OF FDN. COL. & GRADE BEAM

DRAWING NUMBER	REV
MD-216-498L-EG-CV-GAD-1063	D01